


DUNHAM SURVEYING, S.C.
SURVEYING & SUBDIVIDING
DELAVER, WISCONSIN 53115

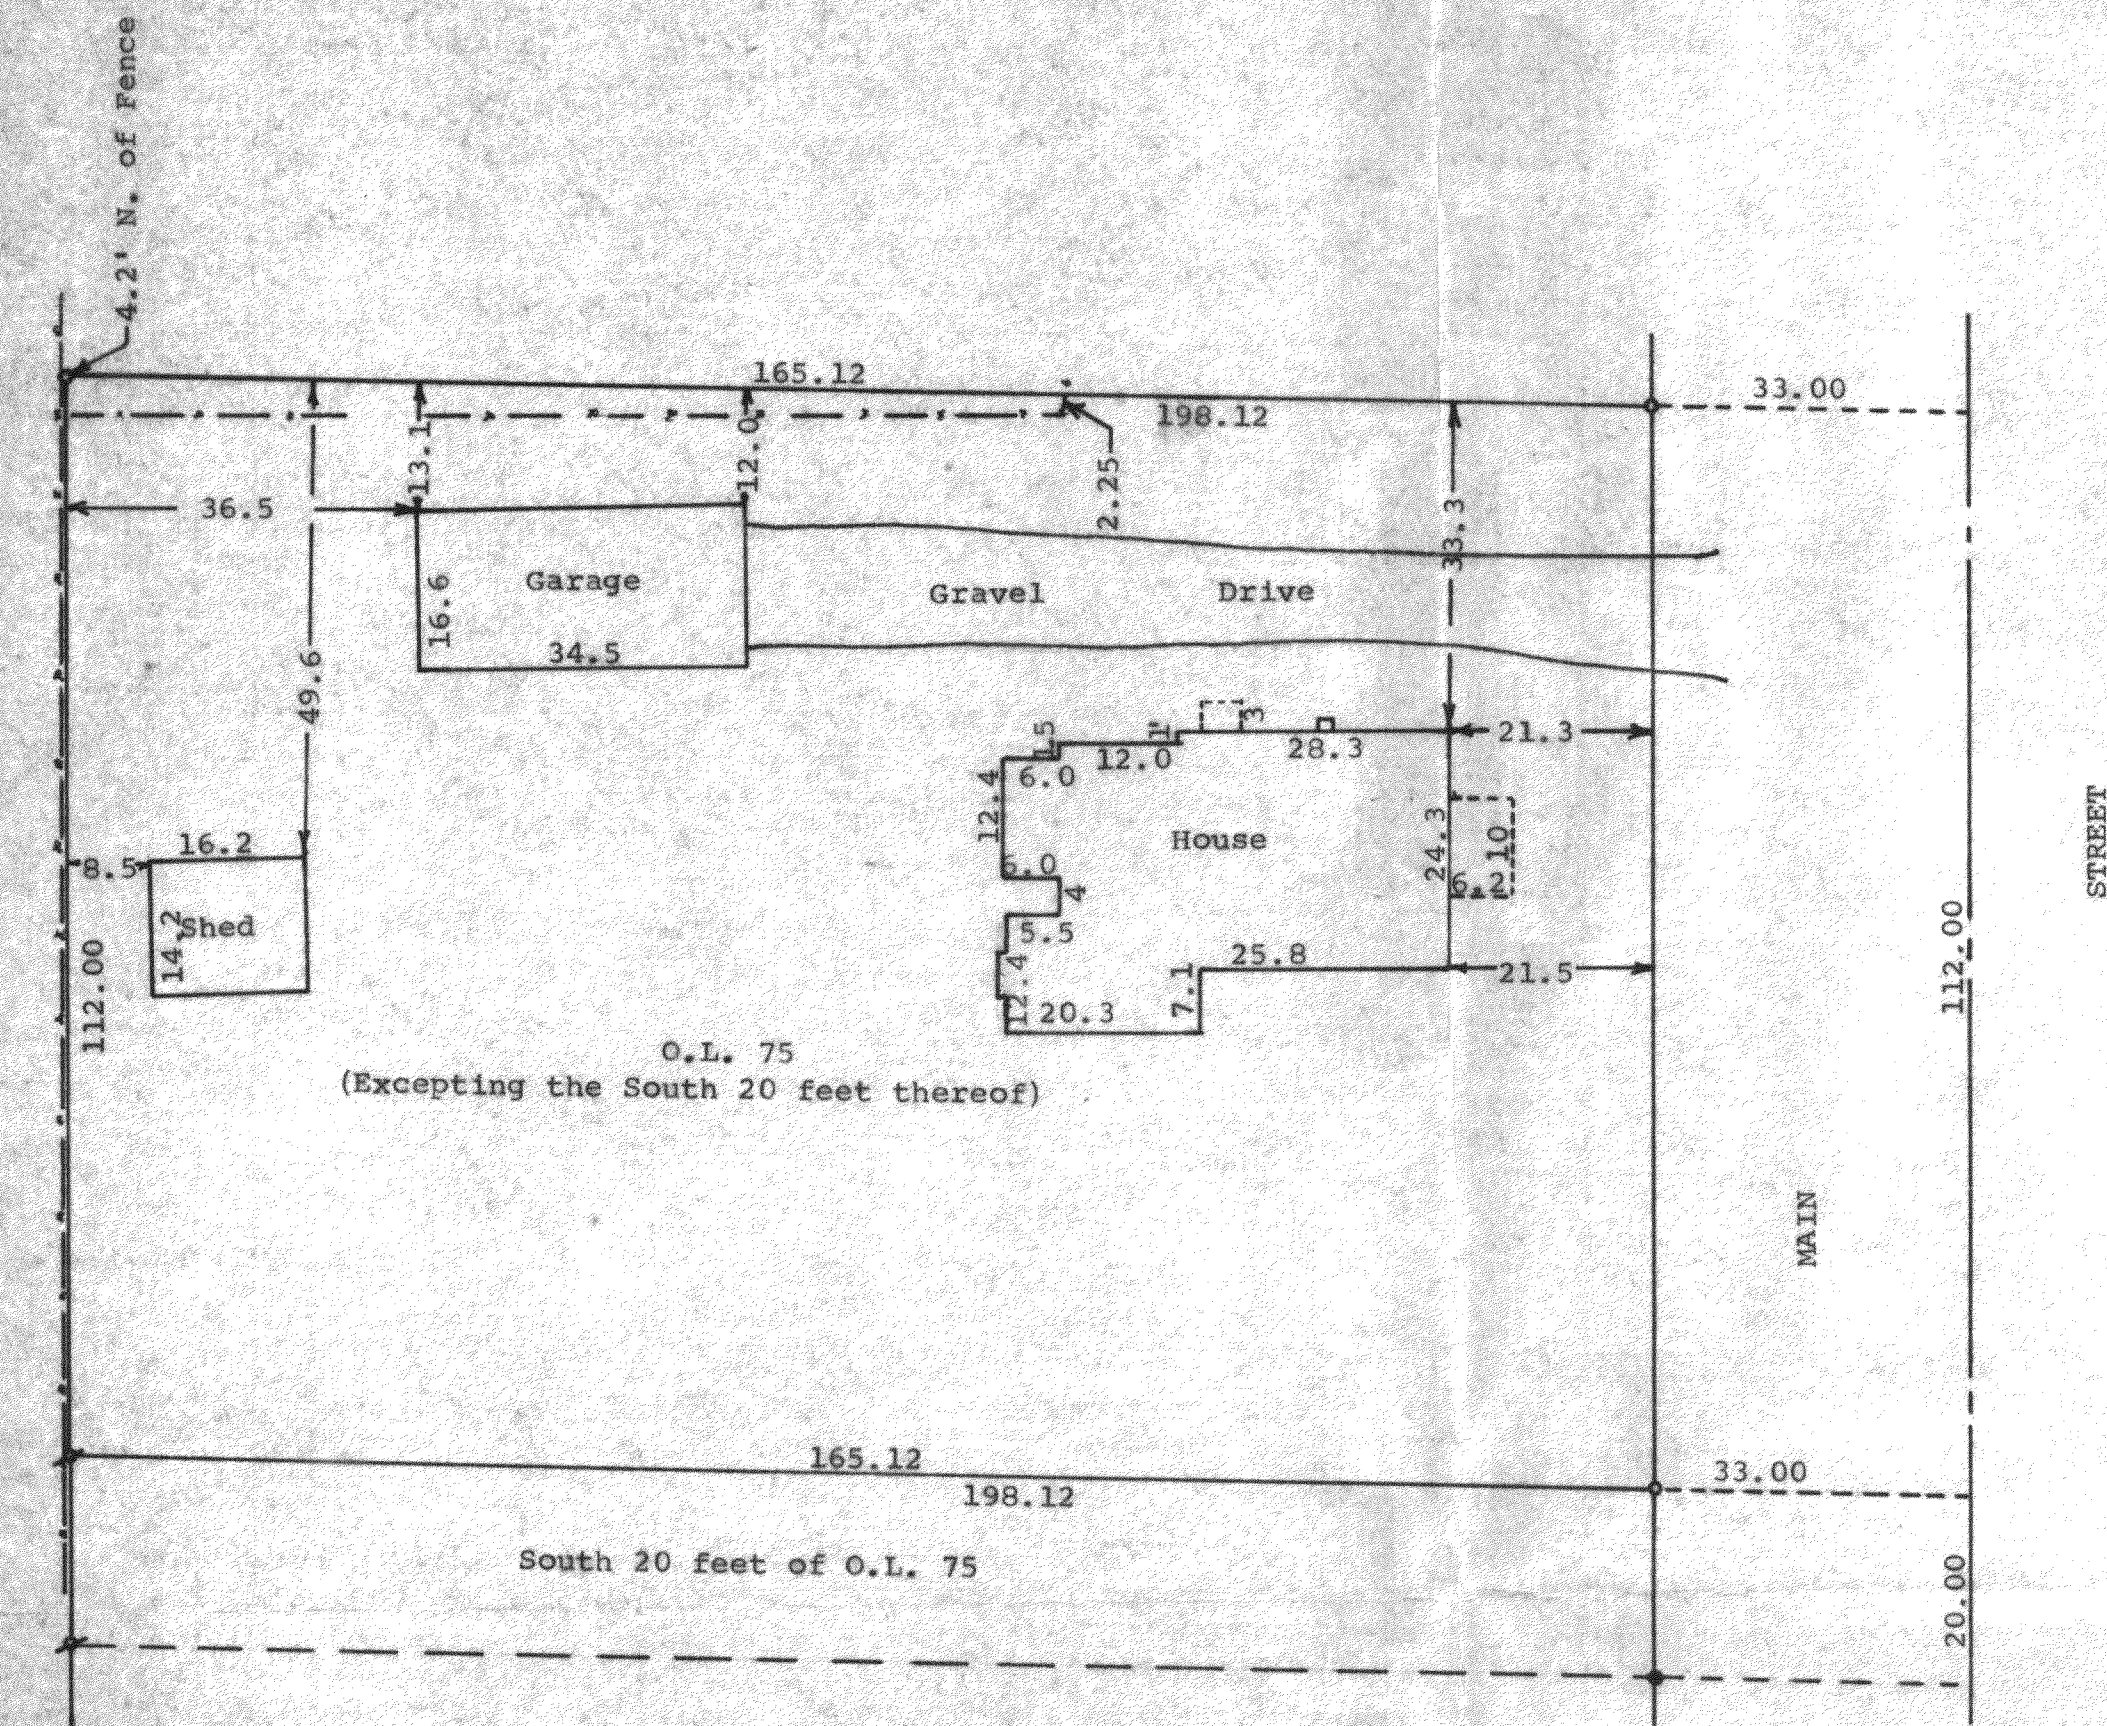

Scale - 1" = 20'

- = Iron Rod Found
- o = Iron Pipe Set
- / = Iron Pipe Found
- - - = Fence Line

Survey recertification ordered by:
The Rauland Agency
118 Kenosha Street
Walworth, WI 53184

STATE OF WISCONSIN) SS
COUNTY OF WALWORTH)

I, George T. Dunham, Surveyor, certify that I have surveyed the property described as follows:

O.L. 75 of the Assessors Plat of the Village of Walworth, Walworth County, Wisconsin EXCEPTING the South 20.00 feet thereof, and the above map is a true representation thereof and shows the size and location of the property, its exterior boundaries, the location and dimensions of all structures thereon, fences, apparent easements and roadways and visible encroachments, if any.

This survey is made for the exclusive use of the present owners of the property, and also those who purchase, mortgage, or guarantee the title thereto within one (1) year from date hereof; and as to them I warrant the accuracy of said survey and map.

May 1, 1978

Updated and recertified to this
17th Day of January, 1991

George T. Dunham
George T. Dunham, Surveyor

