


GEORGE T. DUNHAM
SURVEYING & SUBDIVIDING
DELAVAN, WISCONSIN

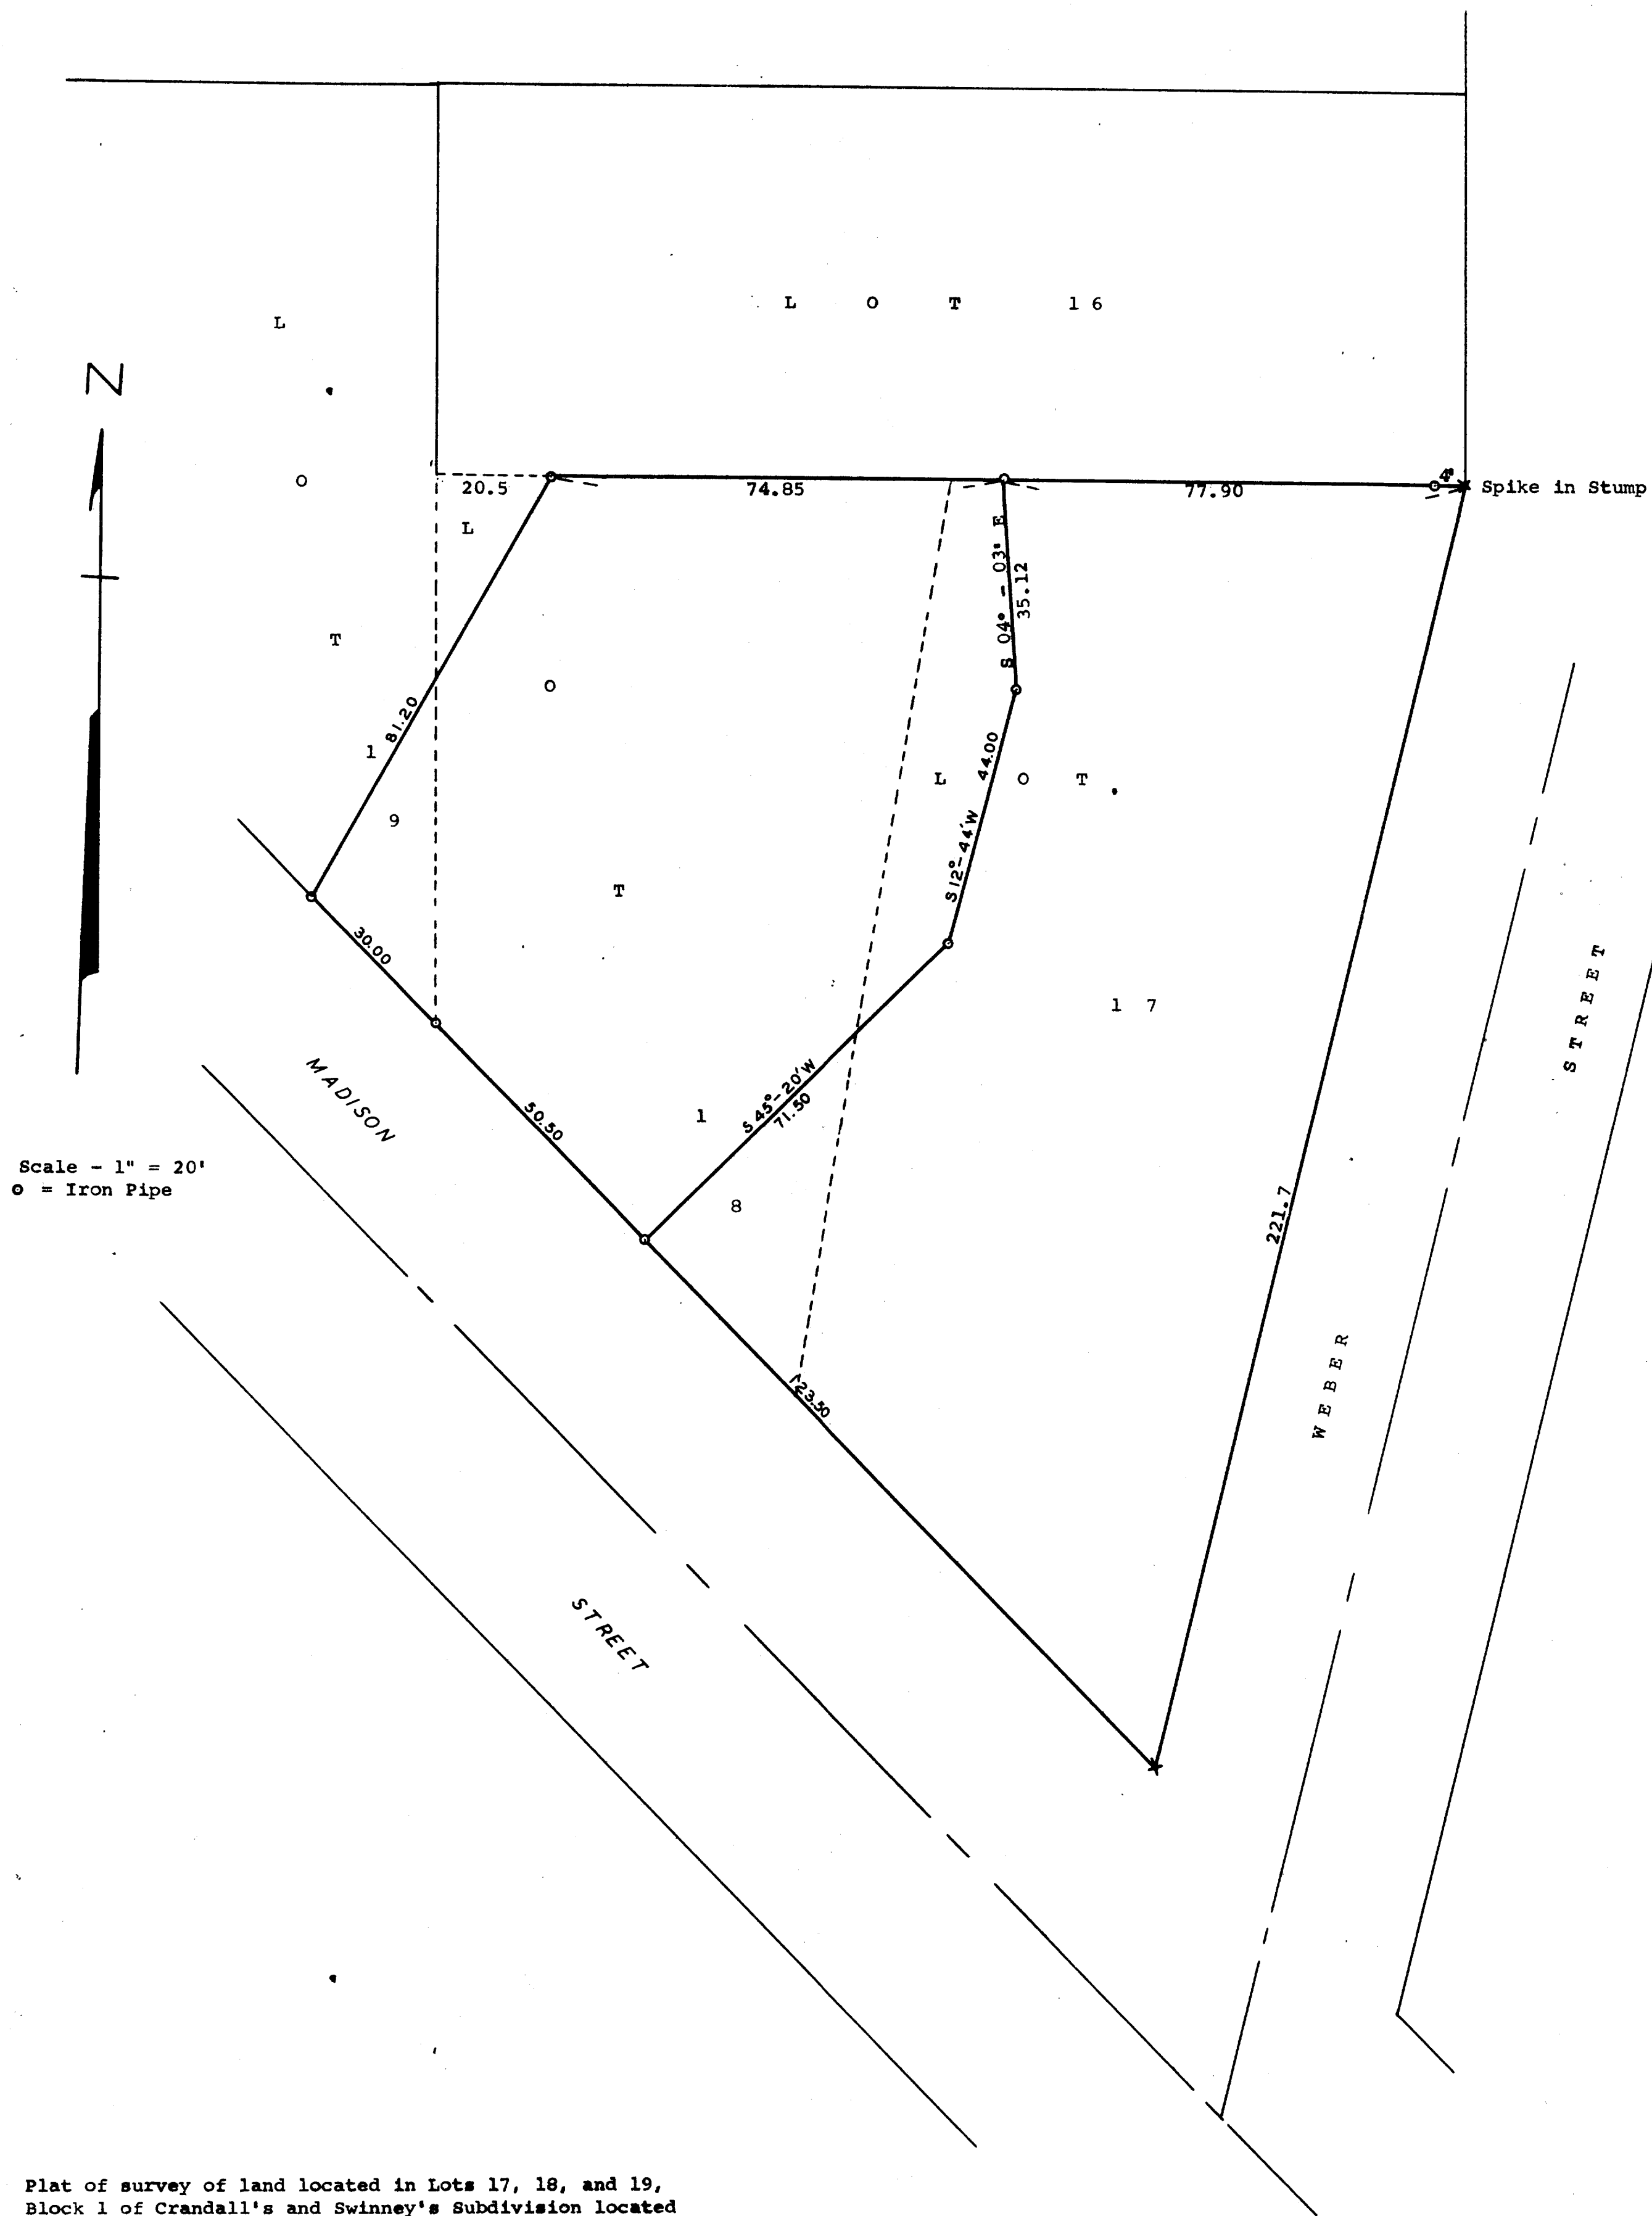

Plat of survey of land located in Lots 17, 18, and 19,
Block 1 of Crandall's and Swinney's Subdivision located
in the Village of Walworth, Walworth County, Wisconsin.
March 29, 1963

George T. Dunham
George T. Dunham, Surveyor