


DUNHAM SURVEYING, S.C.

SURVEYING & SUBDIVIDING  
DELAVAL, WISCONSIN 53115

Iron Rod located 0.5' North-Northwest  
of corner post

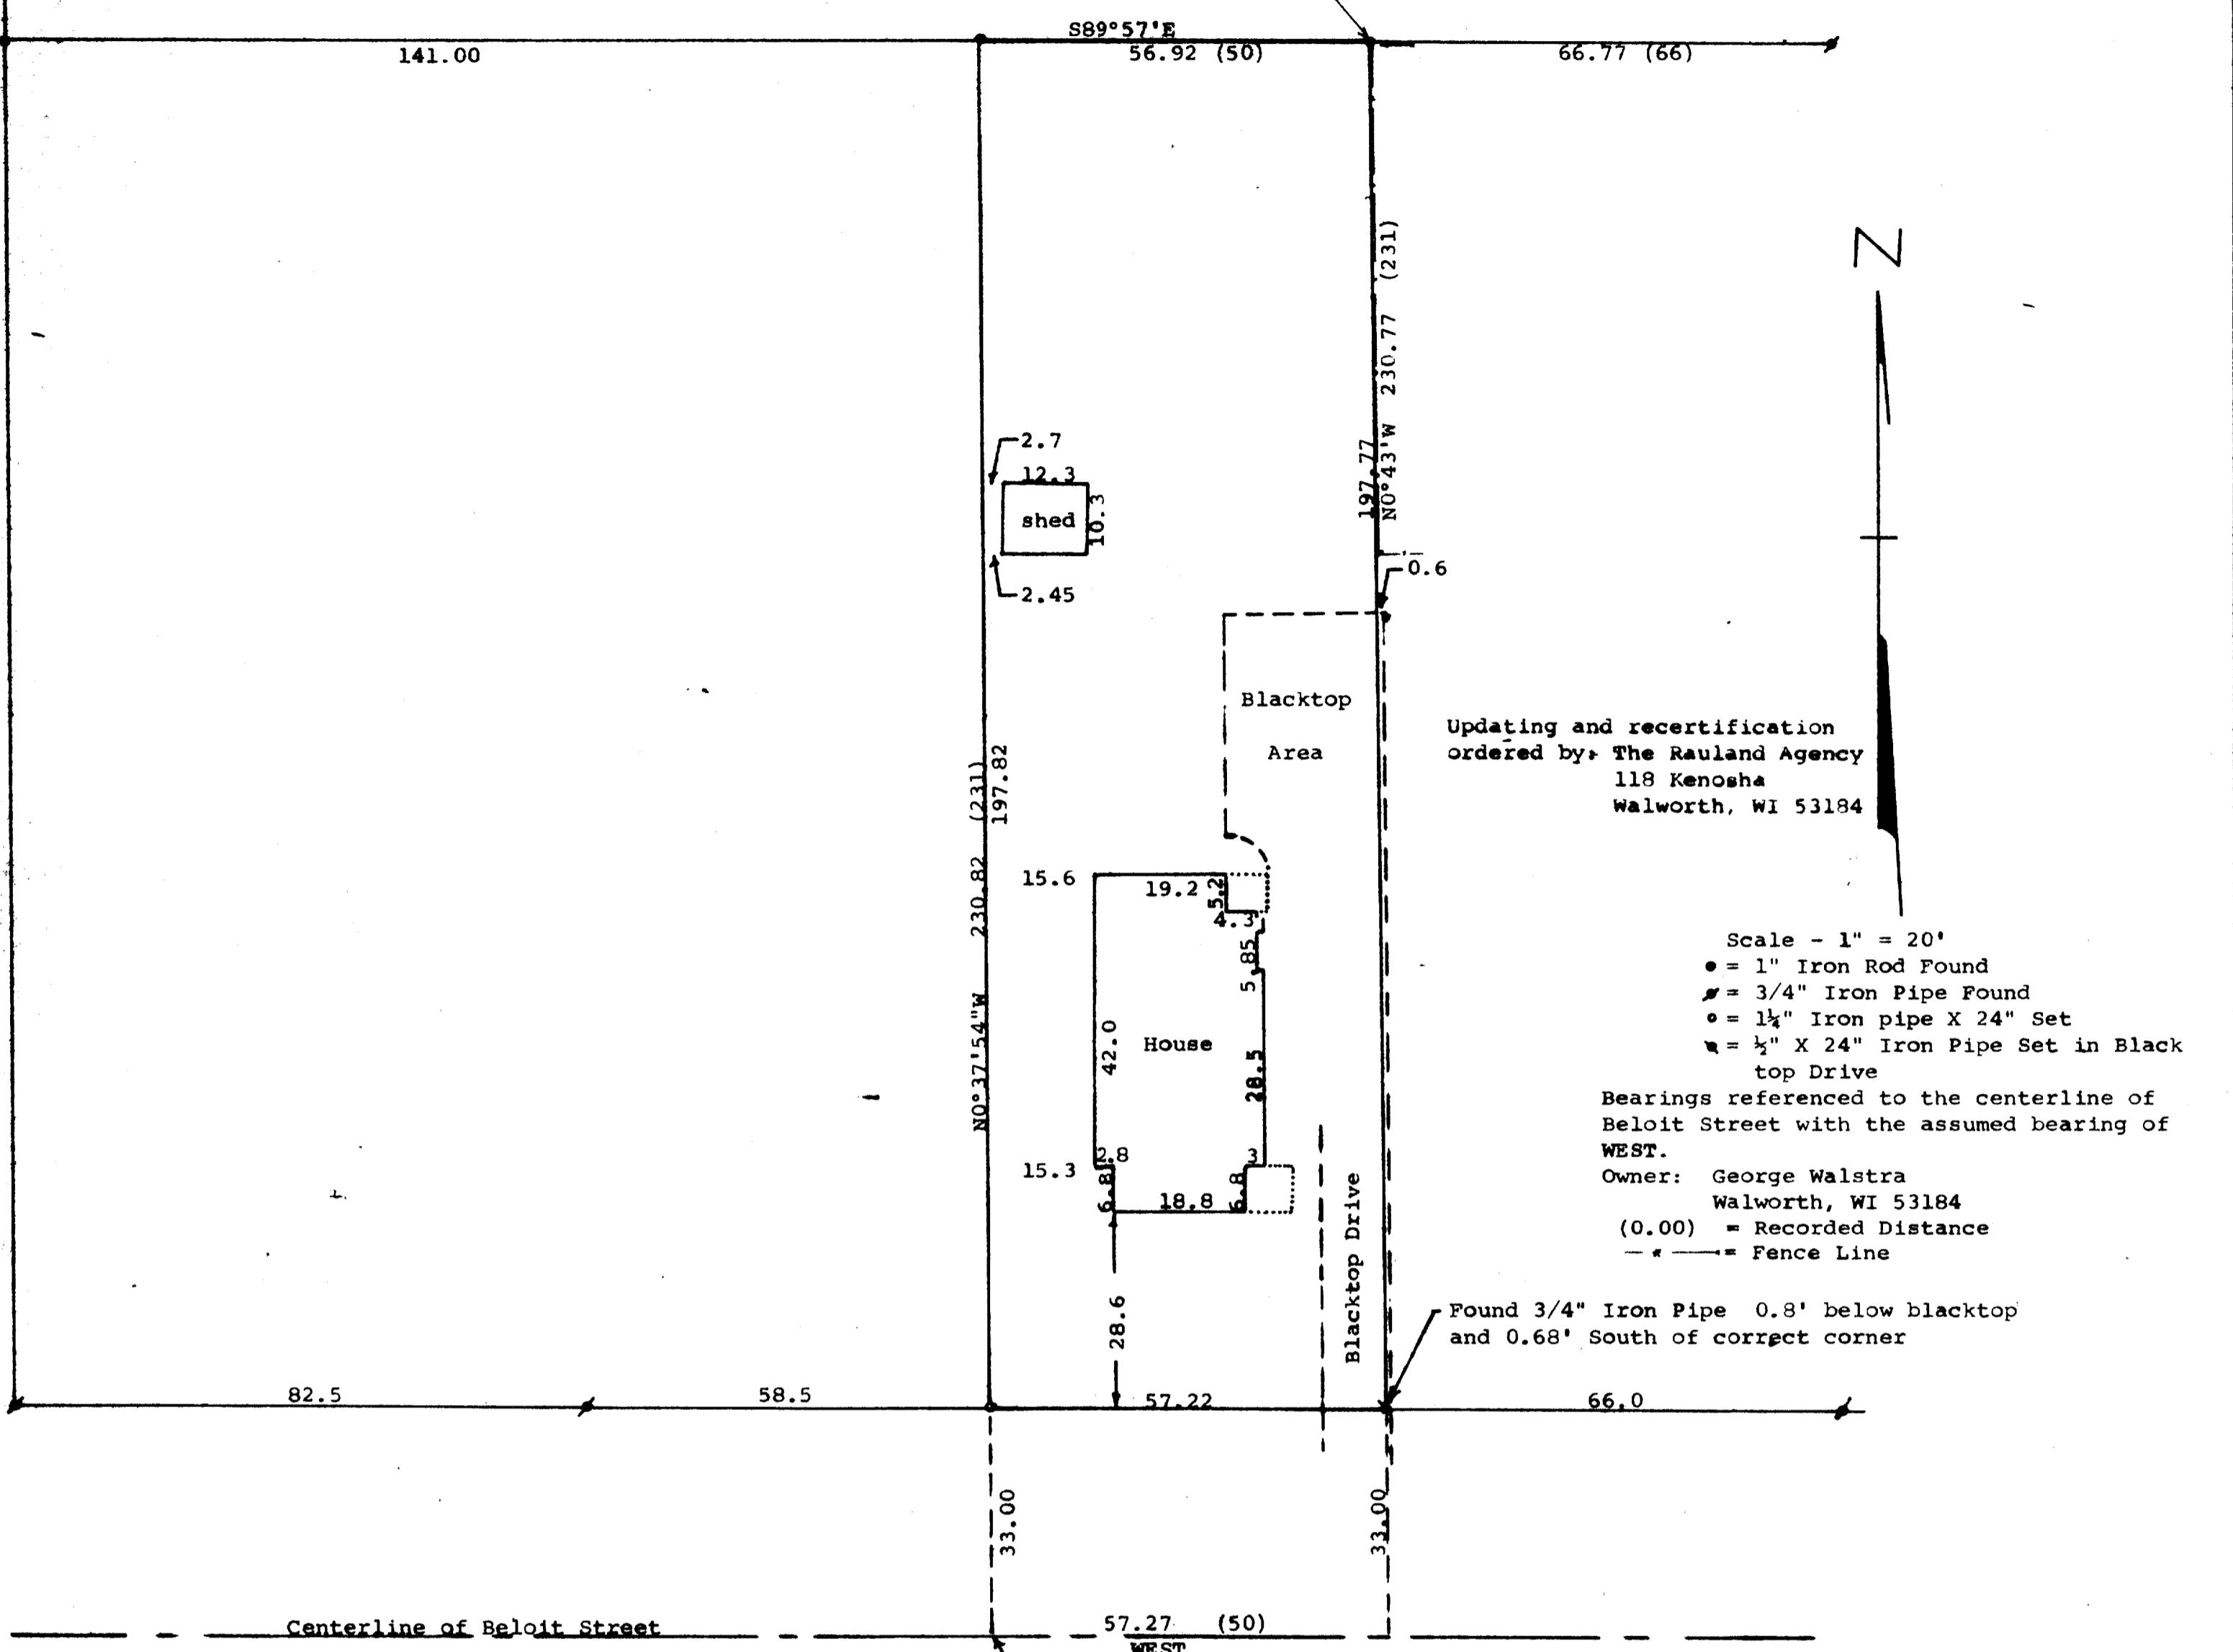

STATE OF WISCONSIN, SS  
COUNTY OF WALWORTH, SS

I, George T. Dunham, Surveyor, certify that I have surveyed the property  
described as follows:

Outlot 29 of the Assessor's Plat of the Village of Walworth, Walworth  
County, Wisconsin.

and that the above map is a true representation thereof and shows the size and  
location of the property, its exterior boundaries, the location of all visible  
structures and dimensions of all principal buildings thereon, boundary fences,  
apparent easements, roadways and visible encroachments, if any, and that I have  
surveyed the property herein described according to the official records to the  
best of my knowledge and belief.

April 22, 1986

Updated and recertified to this  
4th day of February, 1993

*George T. Dunham*  
George T. Dunham, Surveyor

