


ABELL
SURVEYING & MAPPING
DELAVER, WISCONSIN 53115
414-728-6737

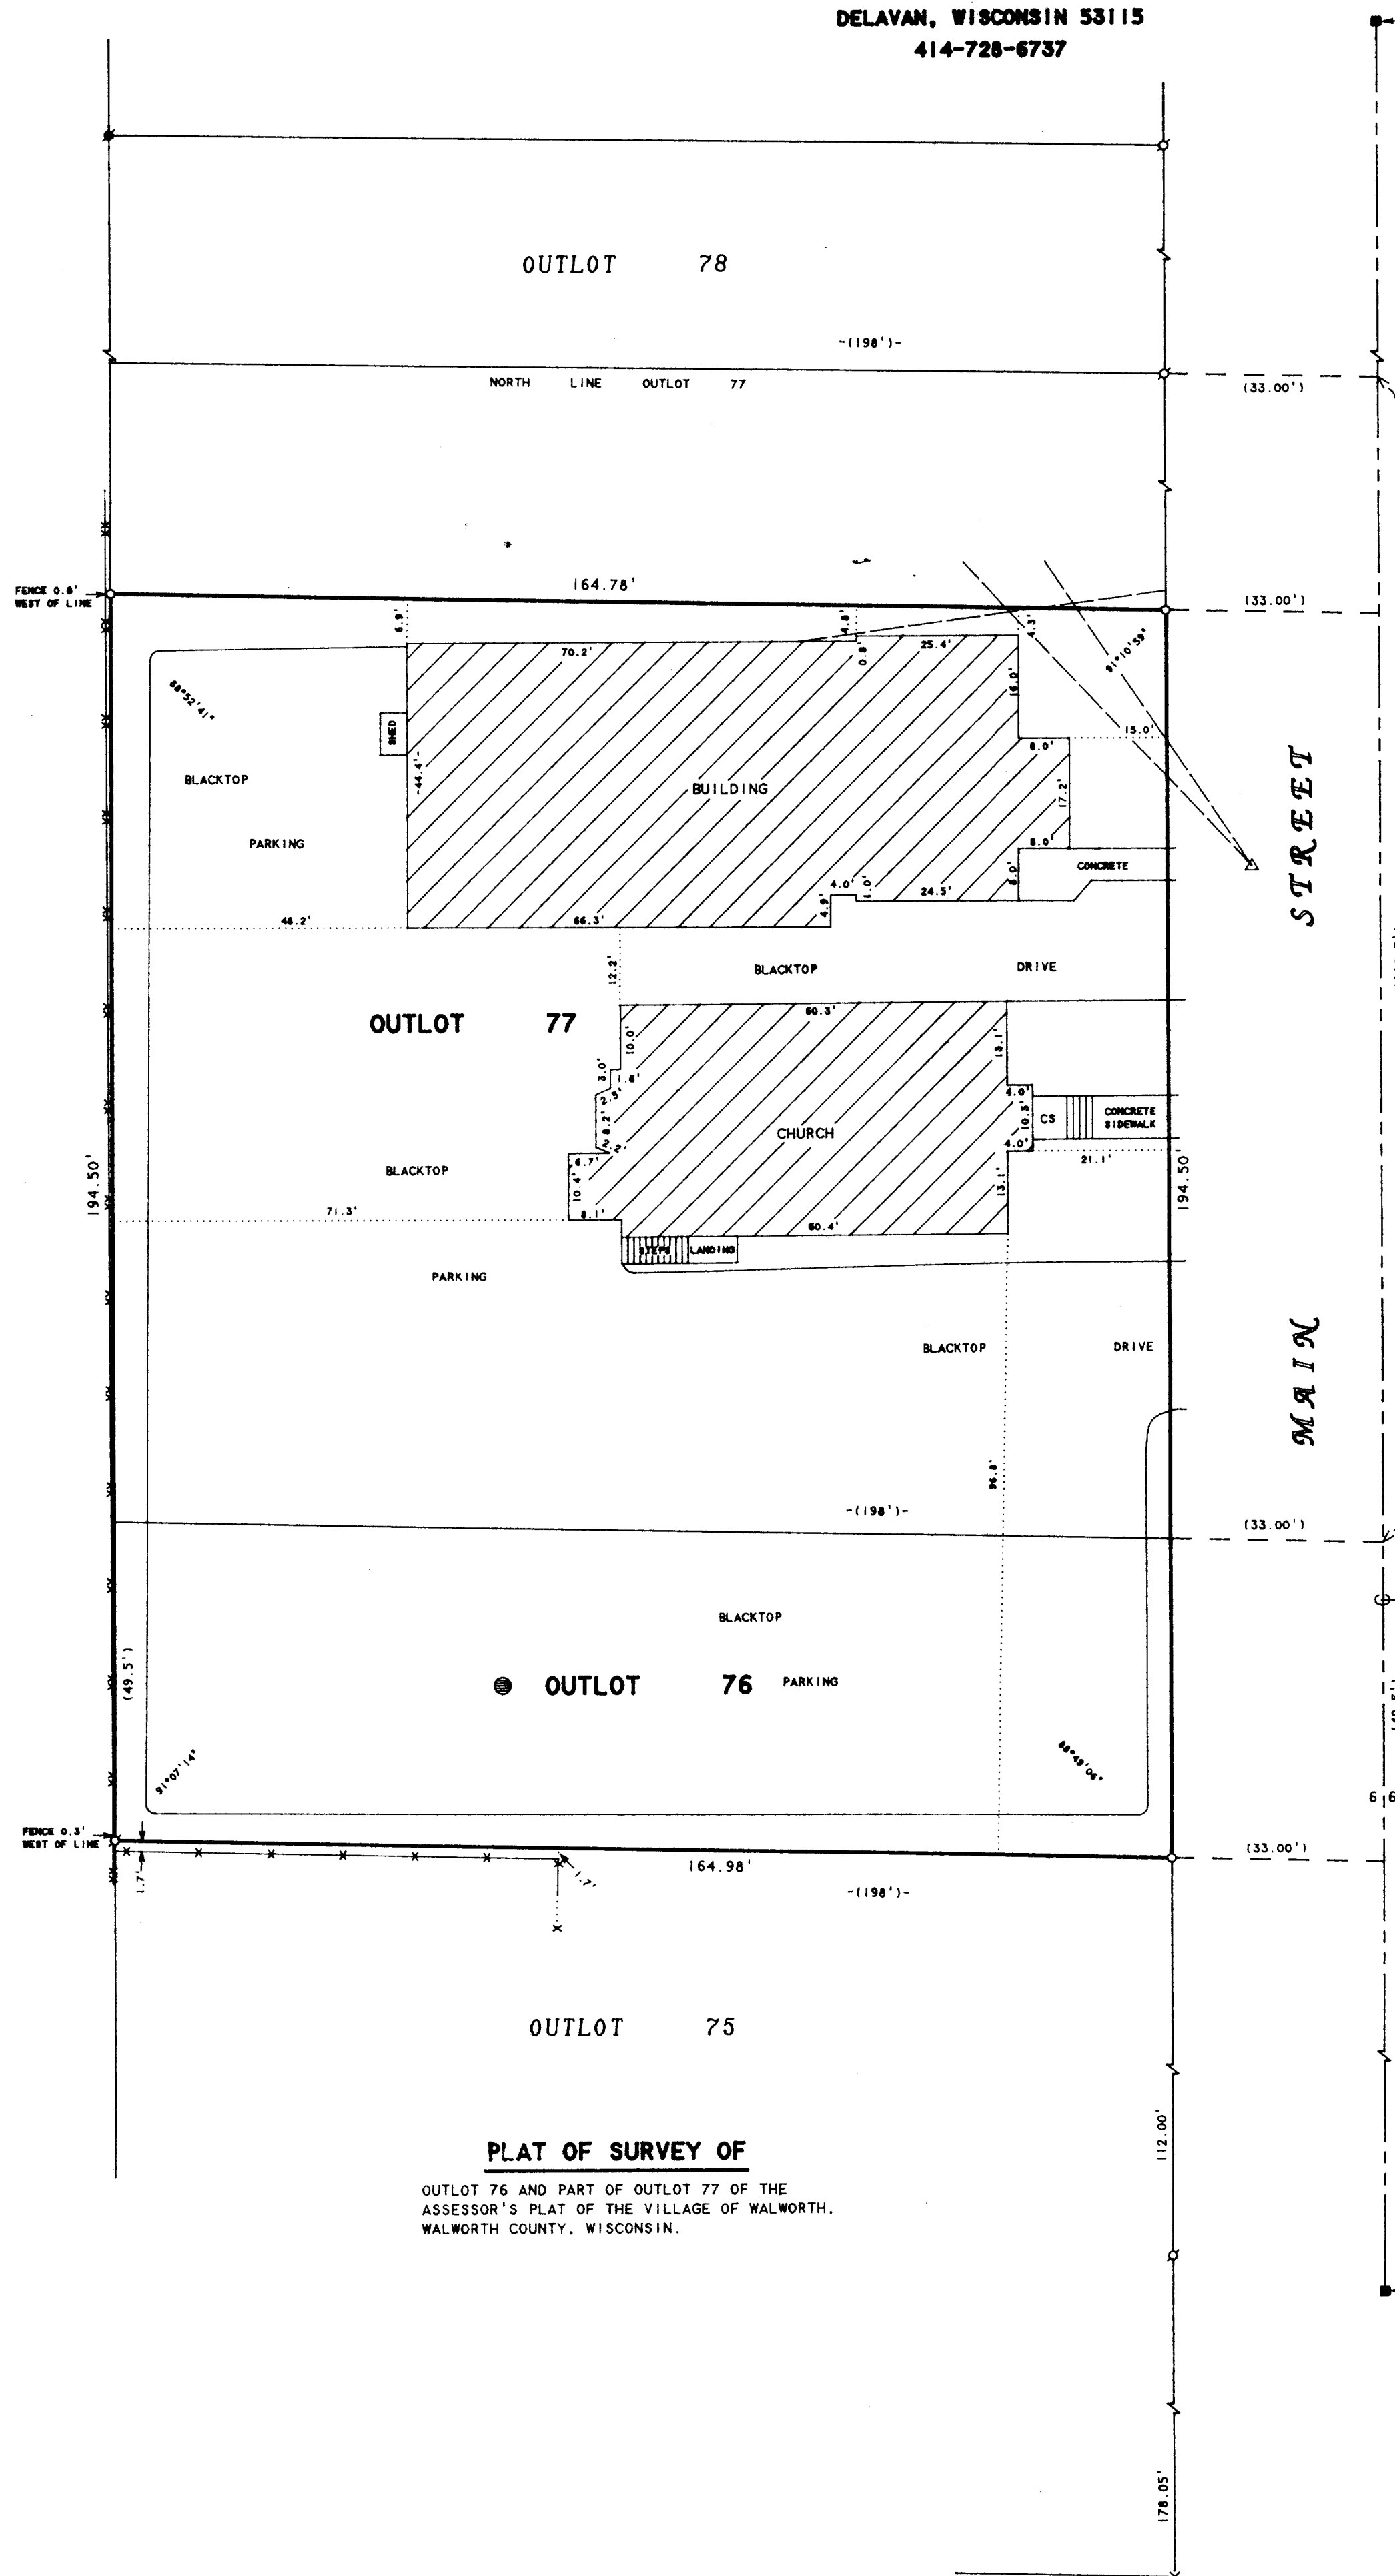

SCALE 1"=20'

LEGEND


- - IRON PIPE FOUND
- - CONCRETE MONUMENT FOUND
- - IRON ROD FOUND
- ✕ - CUT CROSS IN CONCRETE FOUND
- - IRON ROD SET
- - WOOD FENCE
- - CHAINLINK FENCE
- CS - CONCRETE STOOP
- - STORM DRAIN
- △ - UTILITY POLE
- - OVERHEAD UTILITY LINES
- () - RECORDED AS

ORDERED BY: DAVID GOFF
P.O. BOX 686
DARIEN, WI 53114

FOR: GRACE EVANGELICAL FREE CHURCH
WALWORTH, WI.

PLAT OF SURVEY OF

OUTLOT 76 AND PART OF OUTLOT 77 OF THE
ASSESSOR'S PLAT OF THE VILLAGE OF WALWORTH,
WALWORTH COUNTY, WISCONSIN.

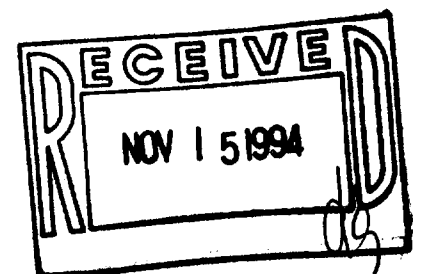

I, DAVID F. ABELL, DO HEREBY CERTIFY THAT I HAVE SURVEYED THE PROPERTY HEREON DESCRIBED ACCORDING TO THE OFFICIAL RECORDS AND THAT THE PLAT HEREON IS A CORRECT REPRESENTATION OF THE PROPERTY LINES TO THE BEST OF MY KNOWLEDGE AND BELIEF.

David F. Abell

DAVID F. ABELL
WISCONSIN REGISTERED LAND SURVEYOR, S-1596

October 7, 1994

DATE: NOVEMBER 15, 1994
NOTE: THIS IS NOT A CERTIFIED COPY UNLESS SEALED.

PHILLIPS AVENUE

VWP-86
VWP-87

009-497