




DUNHAM SURVEYING, S.C.
SURVEYING & SUBDIVIDING
DELAVER, WISCONSIN 53115

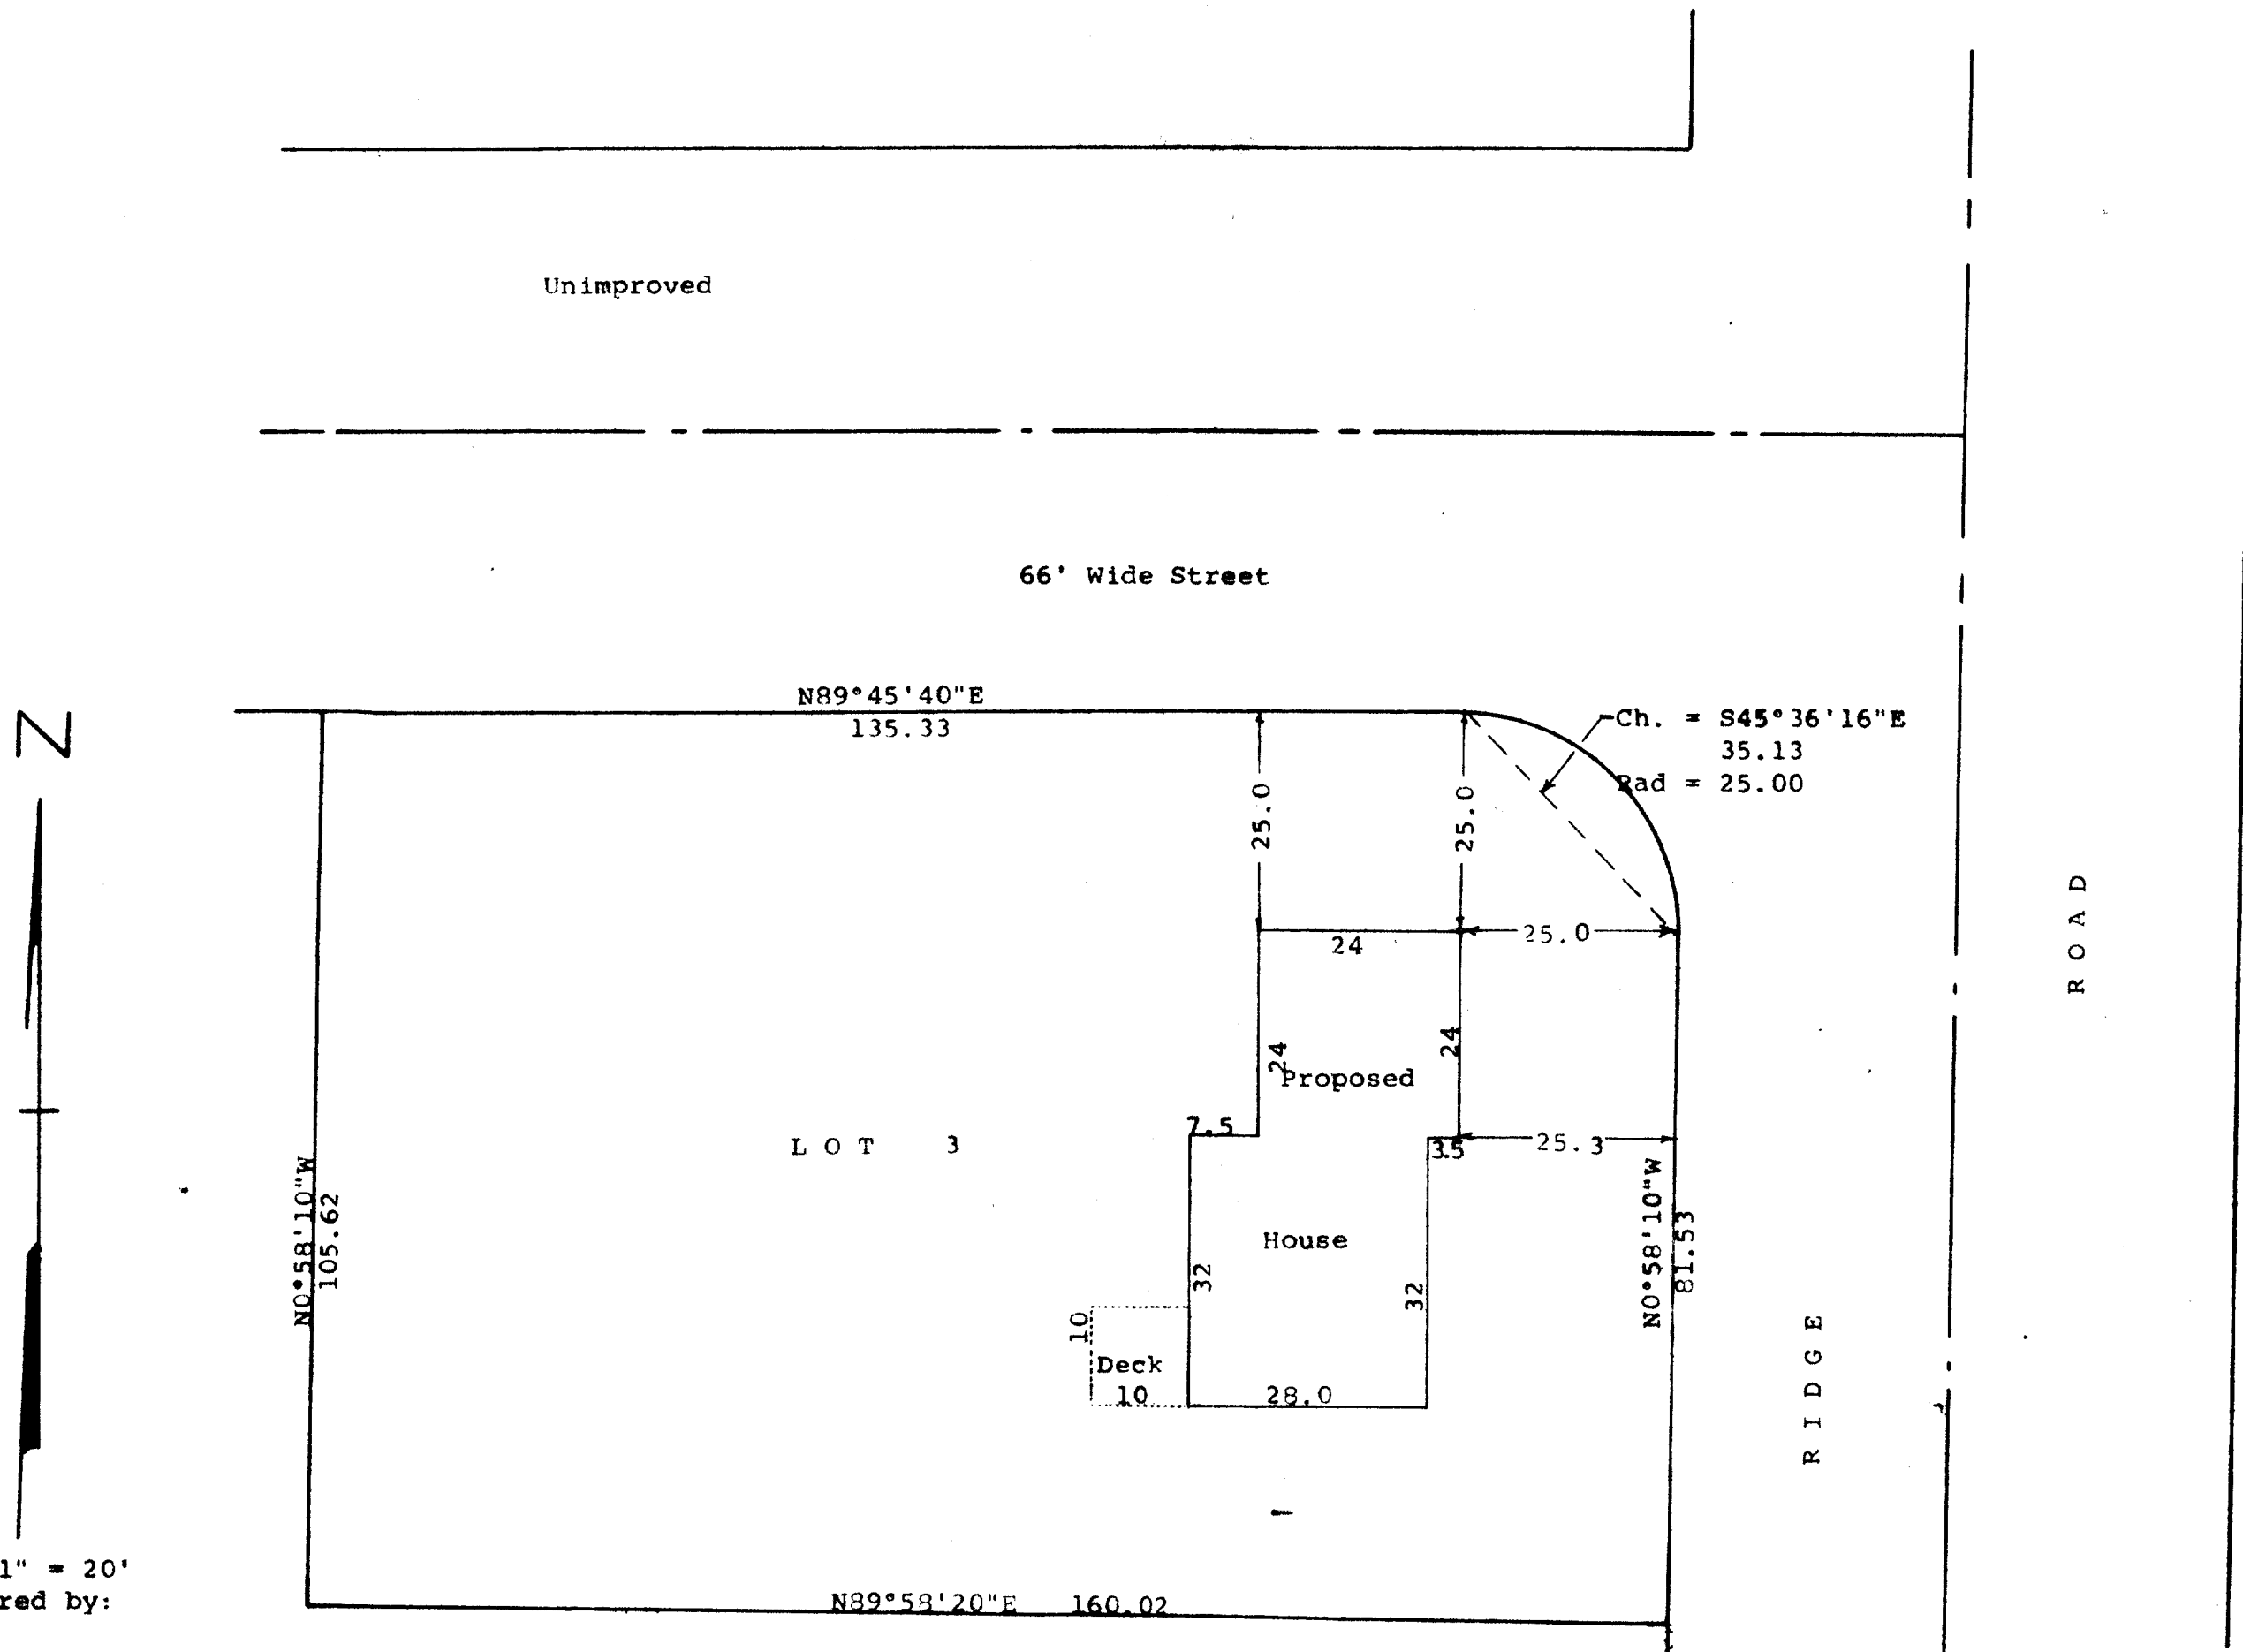

Scale - 1" = 20'
Plot plan ordered by:
KTR Builders
1495 Ryer Court
R. 1, Box 377
Walworth, WI 53184

Plot plan showing the proposed location of a house to be built on
Lot 3 of Certified Survey Map No. 2253, located in the Southeast 1/4
of Section 22, T 1 N, R 16 E, Village of Walworth, Walworth County,
Wisconsin.
April 8, 1994


George J. Dunham
George J. Dunham, Surveyor

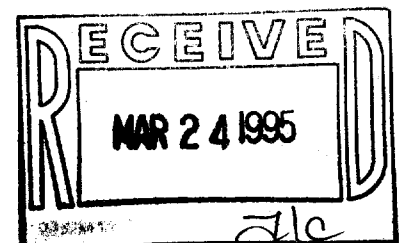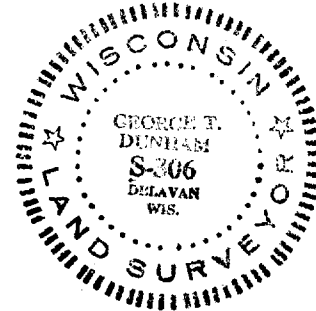

WA-2253-3

009-507

DUNHAM SURVEYING, S.C.
SURVEYING & SUBDIVIDING
DELAVER, WISCONSIN 53115

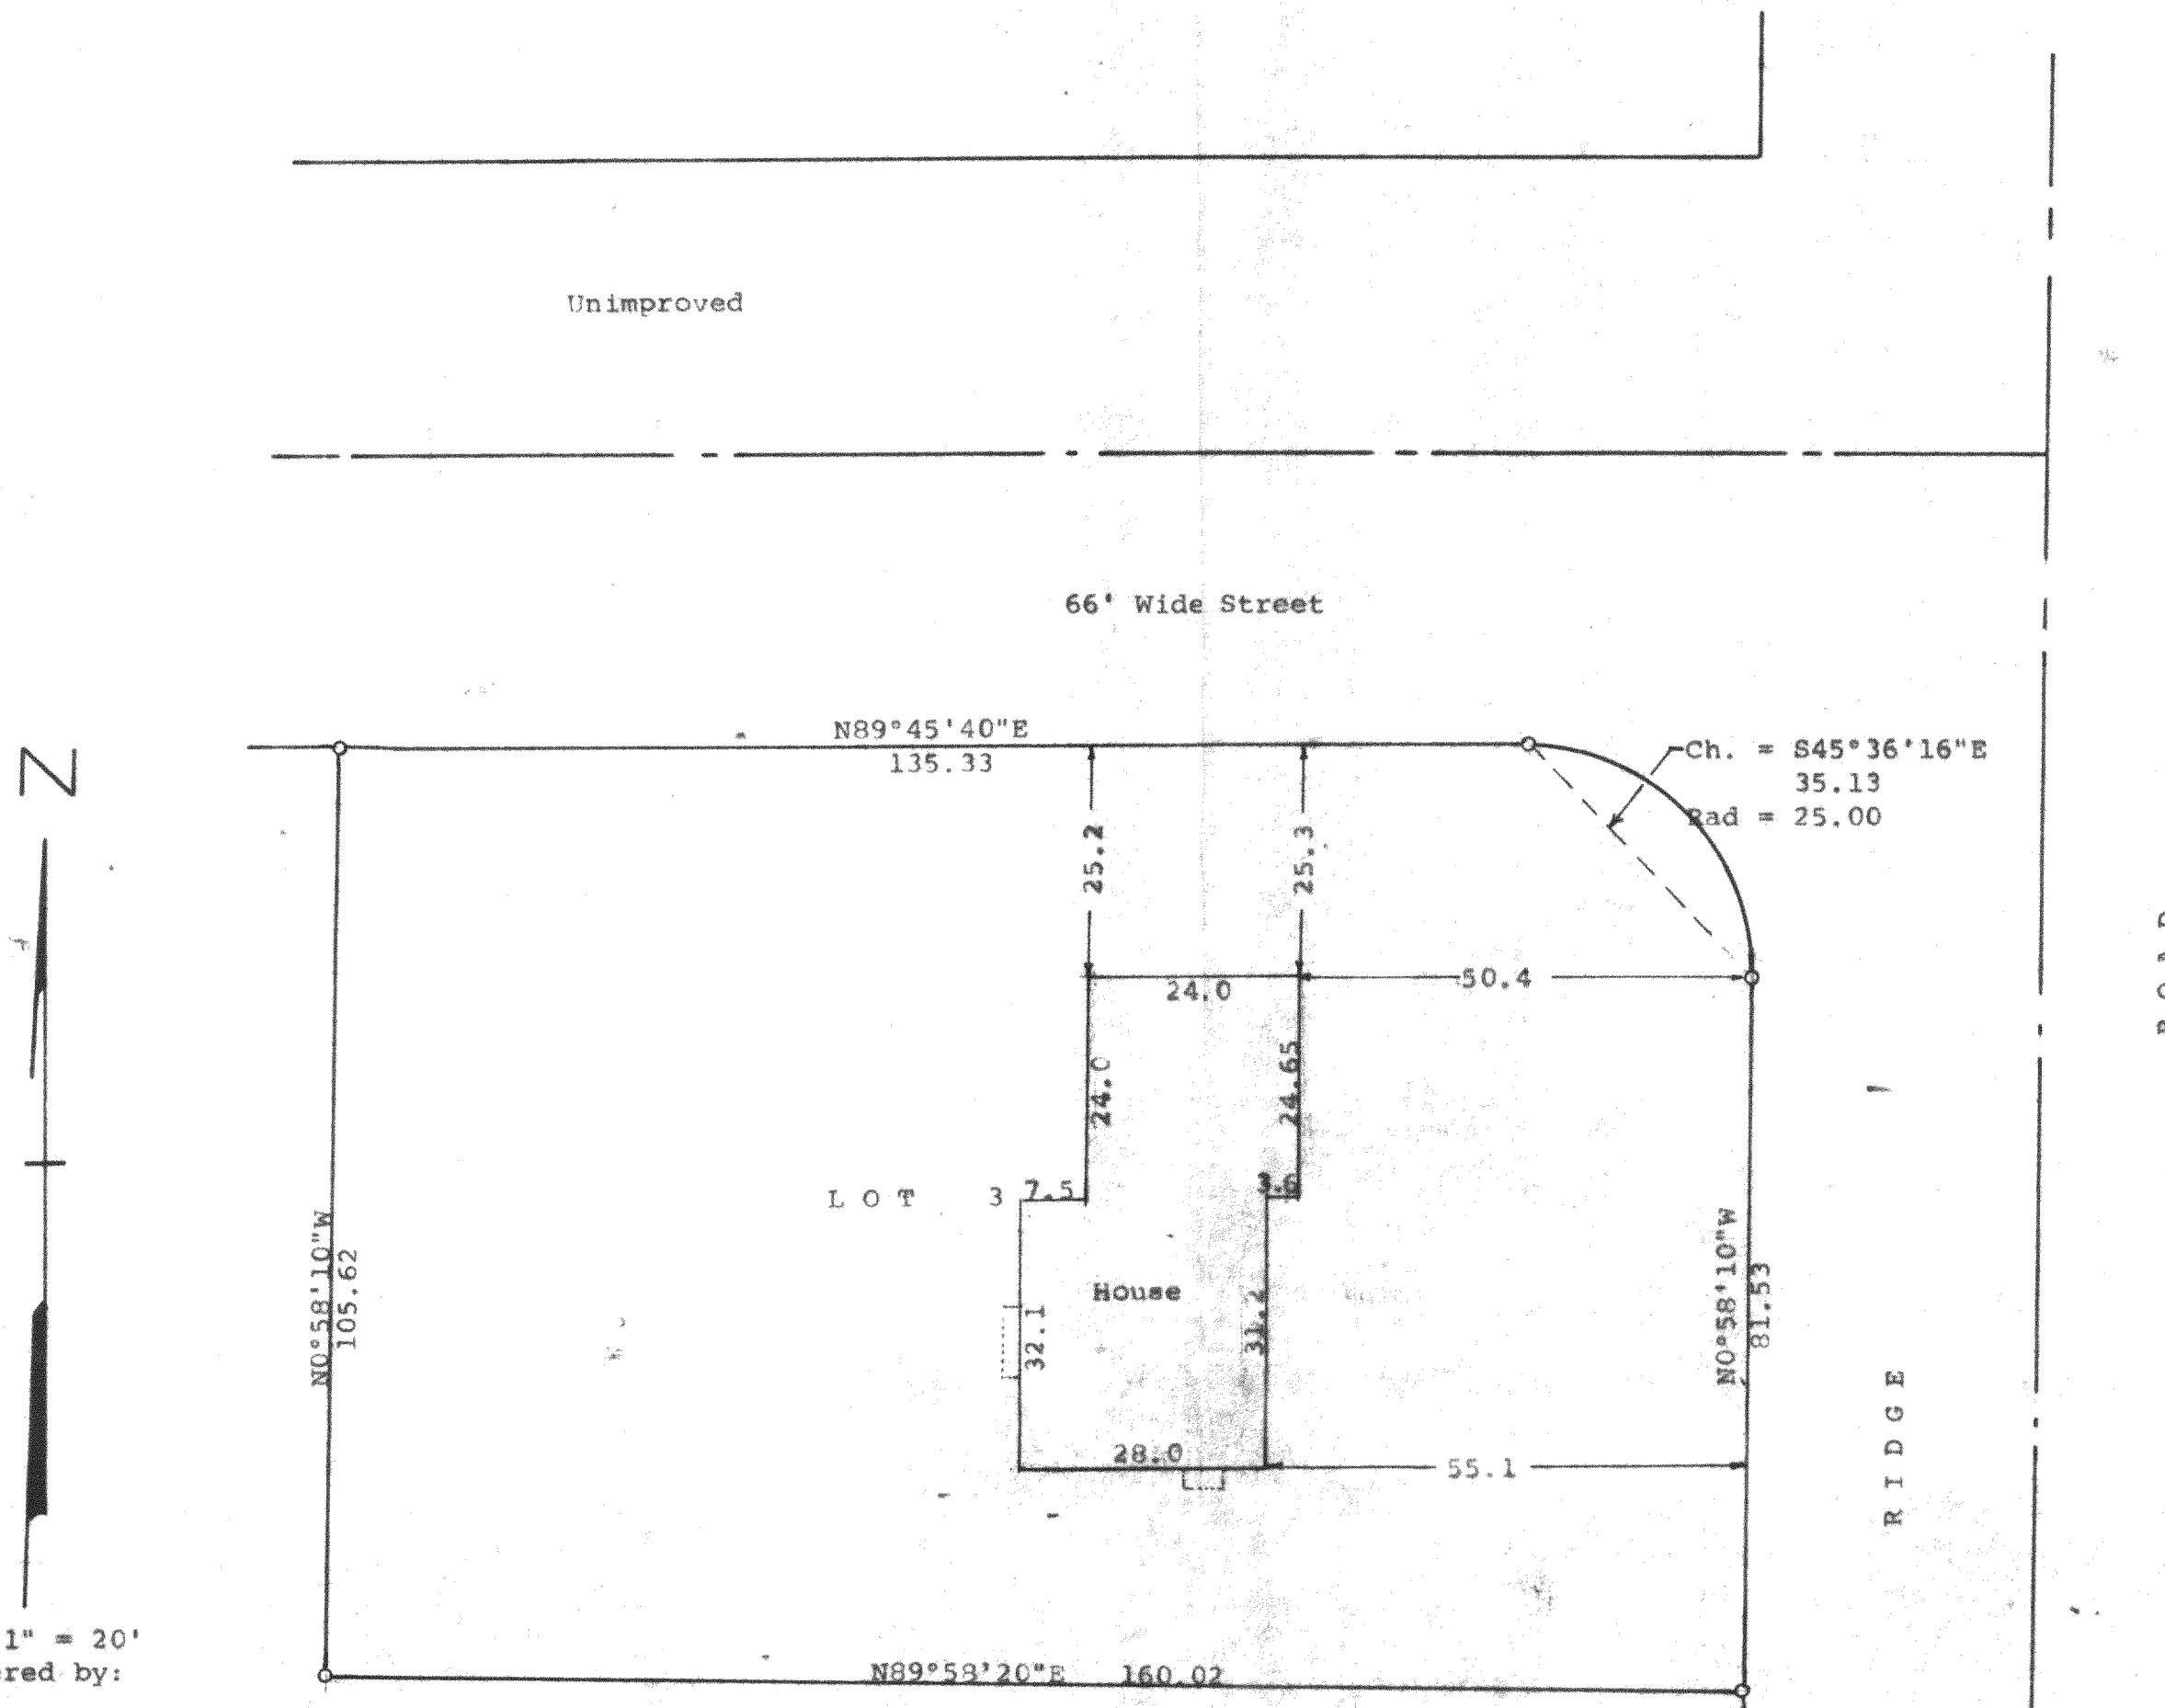

Scale - 1" = 20'
Plot plan ordered by:
KTR Builders
N1495 Ryer Court
R. 1, Box 377
Walworth, WI 53184
Updating and recertification ordered by:
KTR Builders
N1495 Ryer Court
R. 1, Box 377
Walworth, WI 53184

Plot plan showing the proposed location of a house to be built on Lot 3 of Certified Survey Map No. 2253, located in the Southeast 1/4 of Section 22, T 1 N, R 16 E, Village of Walworth, Walworth County, Wisconsin.
April 8, 1994

George T. Dunham
George T. Dunham, Surveyor

STATE OF WISCONSIN)
COUNTY OF WALWORTH) SS

I, George T. Dunham, Surveyor, certify that I have surveyed the property described as follows:

Lot 3 of Certified Survey Map No. 2253, located in the Southeast 1/4 of Section 22, T 1 N, R 16 E, Village of Walworth, Walworth County, Wisconsin.

and that the plat shown hereon is a correct representation thereof and shows the size and location of the property, its exterior boundaries, the location of all visible structures and dimensions of all principal buildings thereon, boundary fences, apparent easements, roadways and visible encroachments, if any, and that I have surveyed the property hereon described, according to the official records, to the best of my knowledge and belief.

May 11, 1994

George T. Dunham
George T. Dunham, Surveyor

