

FARRIS, HANSEN & ASSOCIATES, INC.

ENGINEERING, ARCHITECTURE, SURVEYING
7 RIDGWAY COURT - P.O. BOX 437, ELKHORN, WISCONSIN 53121
PHONE: (414) 723-2098 FAX: (414) 723-5886



PLAT OF SURVEY

LOT 1 OF CSM 2432

REC. VOL. 12, ON PG. 81, DOC. NO. 282914
OF WALWORTH COUNTY CERTIFIED SURVEY MAPS
LOCATED IN THE VILLAGE OF WALWORTH
WALWORTH COUNTY, WISCONSIN

WORK ORDERED BY: DENNIS CONDON
CONDON CONSTRUCTION
1521 E. RACINE ST.
JANESVILLE, WI. 53545

ASSIGN SOUTH LINE N 89° 52' 20" E
PER RECORD PLAT

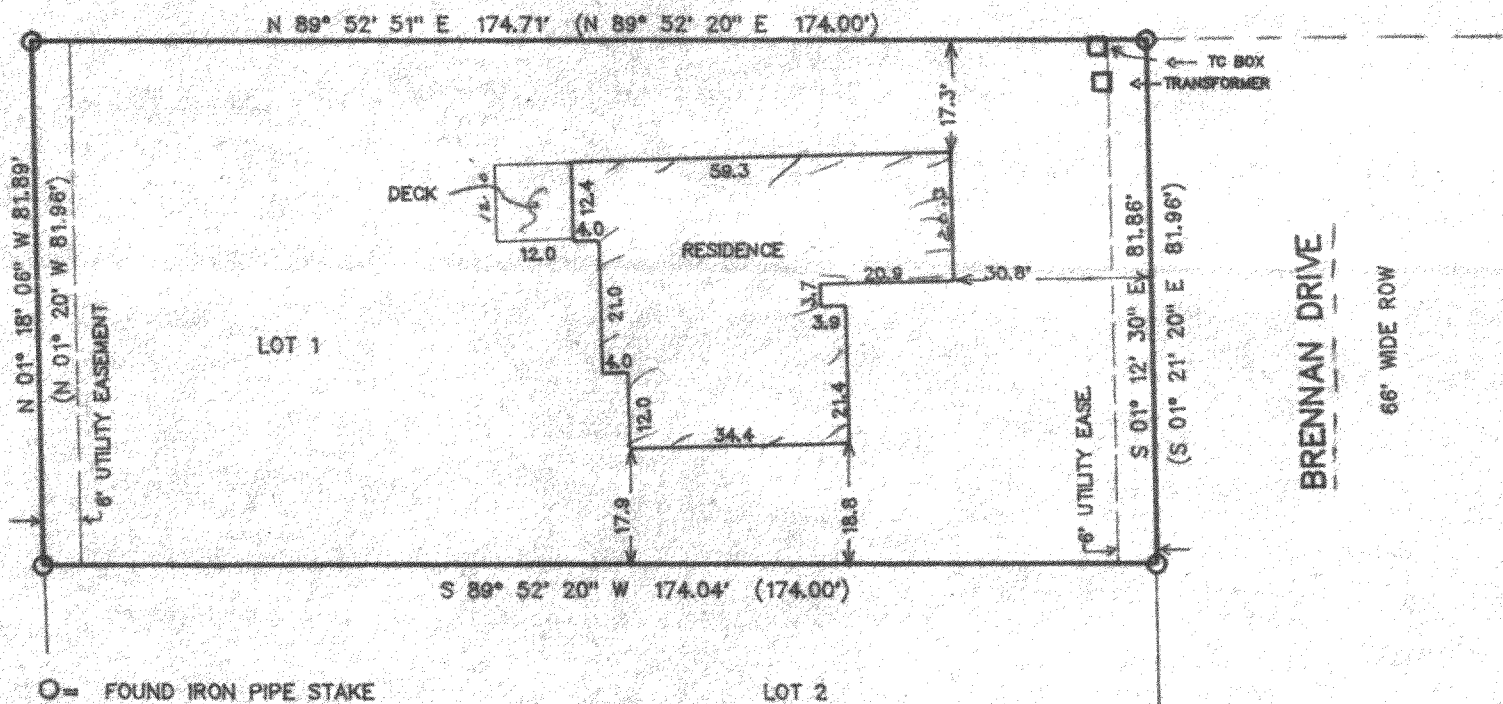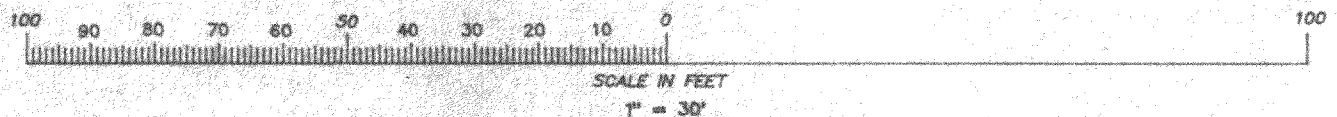


NOTE: COPIES OF THIS MAP TO WHICH THE FOLLOWING CERTIFICATE WILL APPLY ARE BLUE LINE PRINTS SHOWING SURVEYOR'S ORIGINAL SEAL AND SIGNATURE IN BLACK INK. COPIES BY ANY OTHER MEANS MAY HAVE ALTERATIONS WHICH DO NOT REPRESENT THE SURVEYOR'S WORK PRODUCT.

I HEREBY CERTIFY THAT THE ABOVE DESCRIBED PROPERTY HAS BEEN SURVEYED UNDER MY DIRECTION AND THAT THE ABOVE MAP IS A TRUE REPRESENTATION THEREOF AND SHOWS THE SIZE AND LOCATION OF THE PROPERTY AND ITS EXTERIOR BOUNDARIES. THIS SURVEY IS MADE FOR THE USE OF THE PRESENT OWNERS OF THE PROPERTY, AND ALSO THOSE WHO PURCHASE, MORTGAGE, OR GUARANTEE THE TITLE THERETO WITHIN ONE YEAR FROM THE DATE HEREOF.

DATED: 11/16/95

PETER S. GORDON R.L.S. 2101

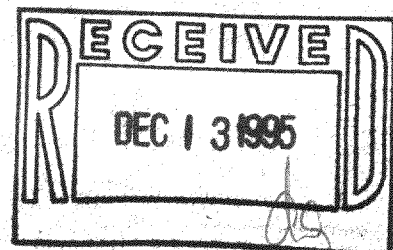

PROJ 4429
11-15-95

VA-2432-1

009-531