


DUNHAM SURVEYING, S.C.
SURVEYING & SUBDIVIDING
DELAVER, WISCONSIN 53115

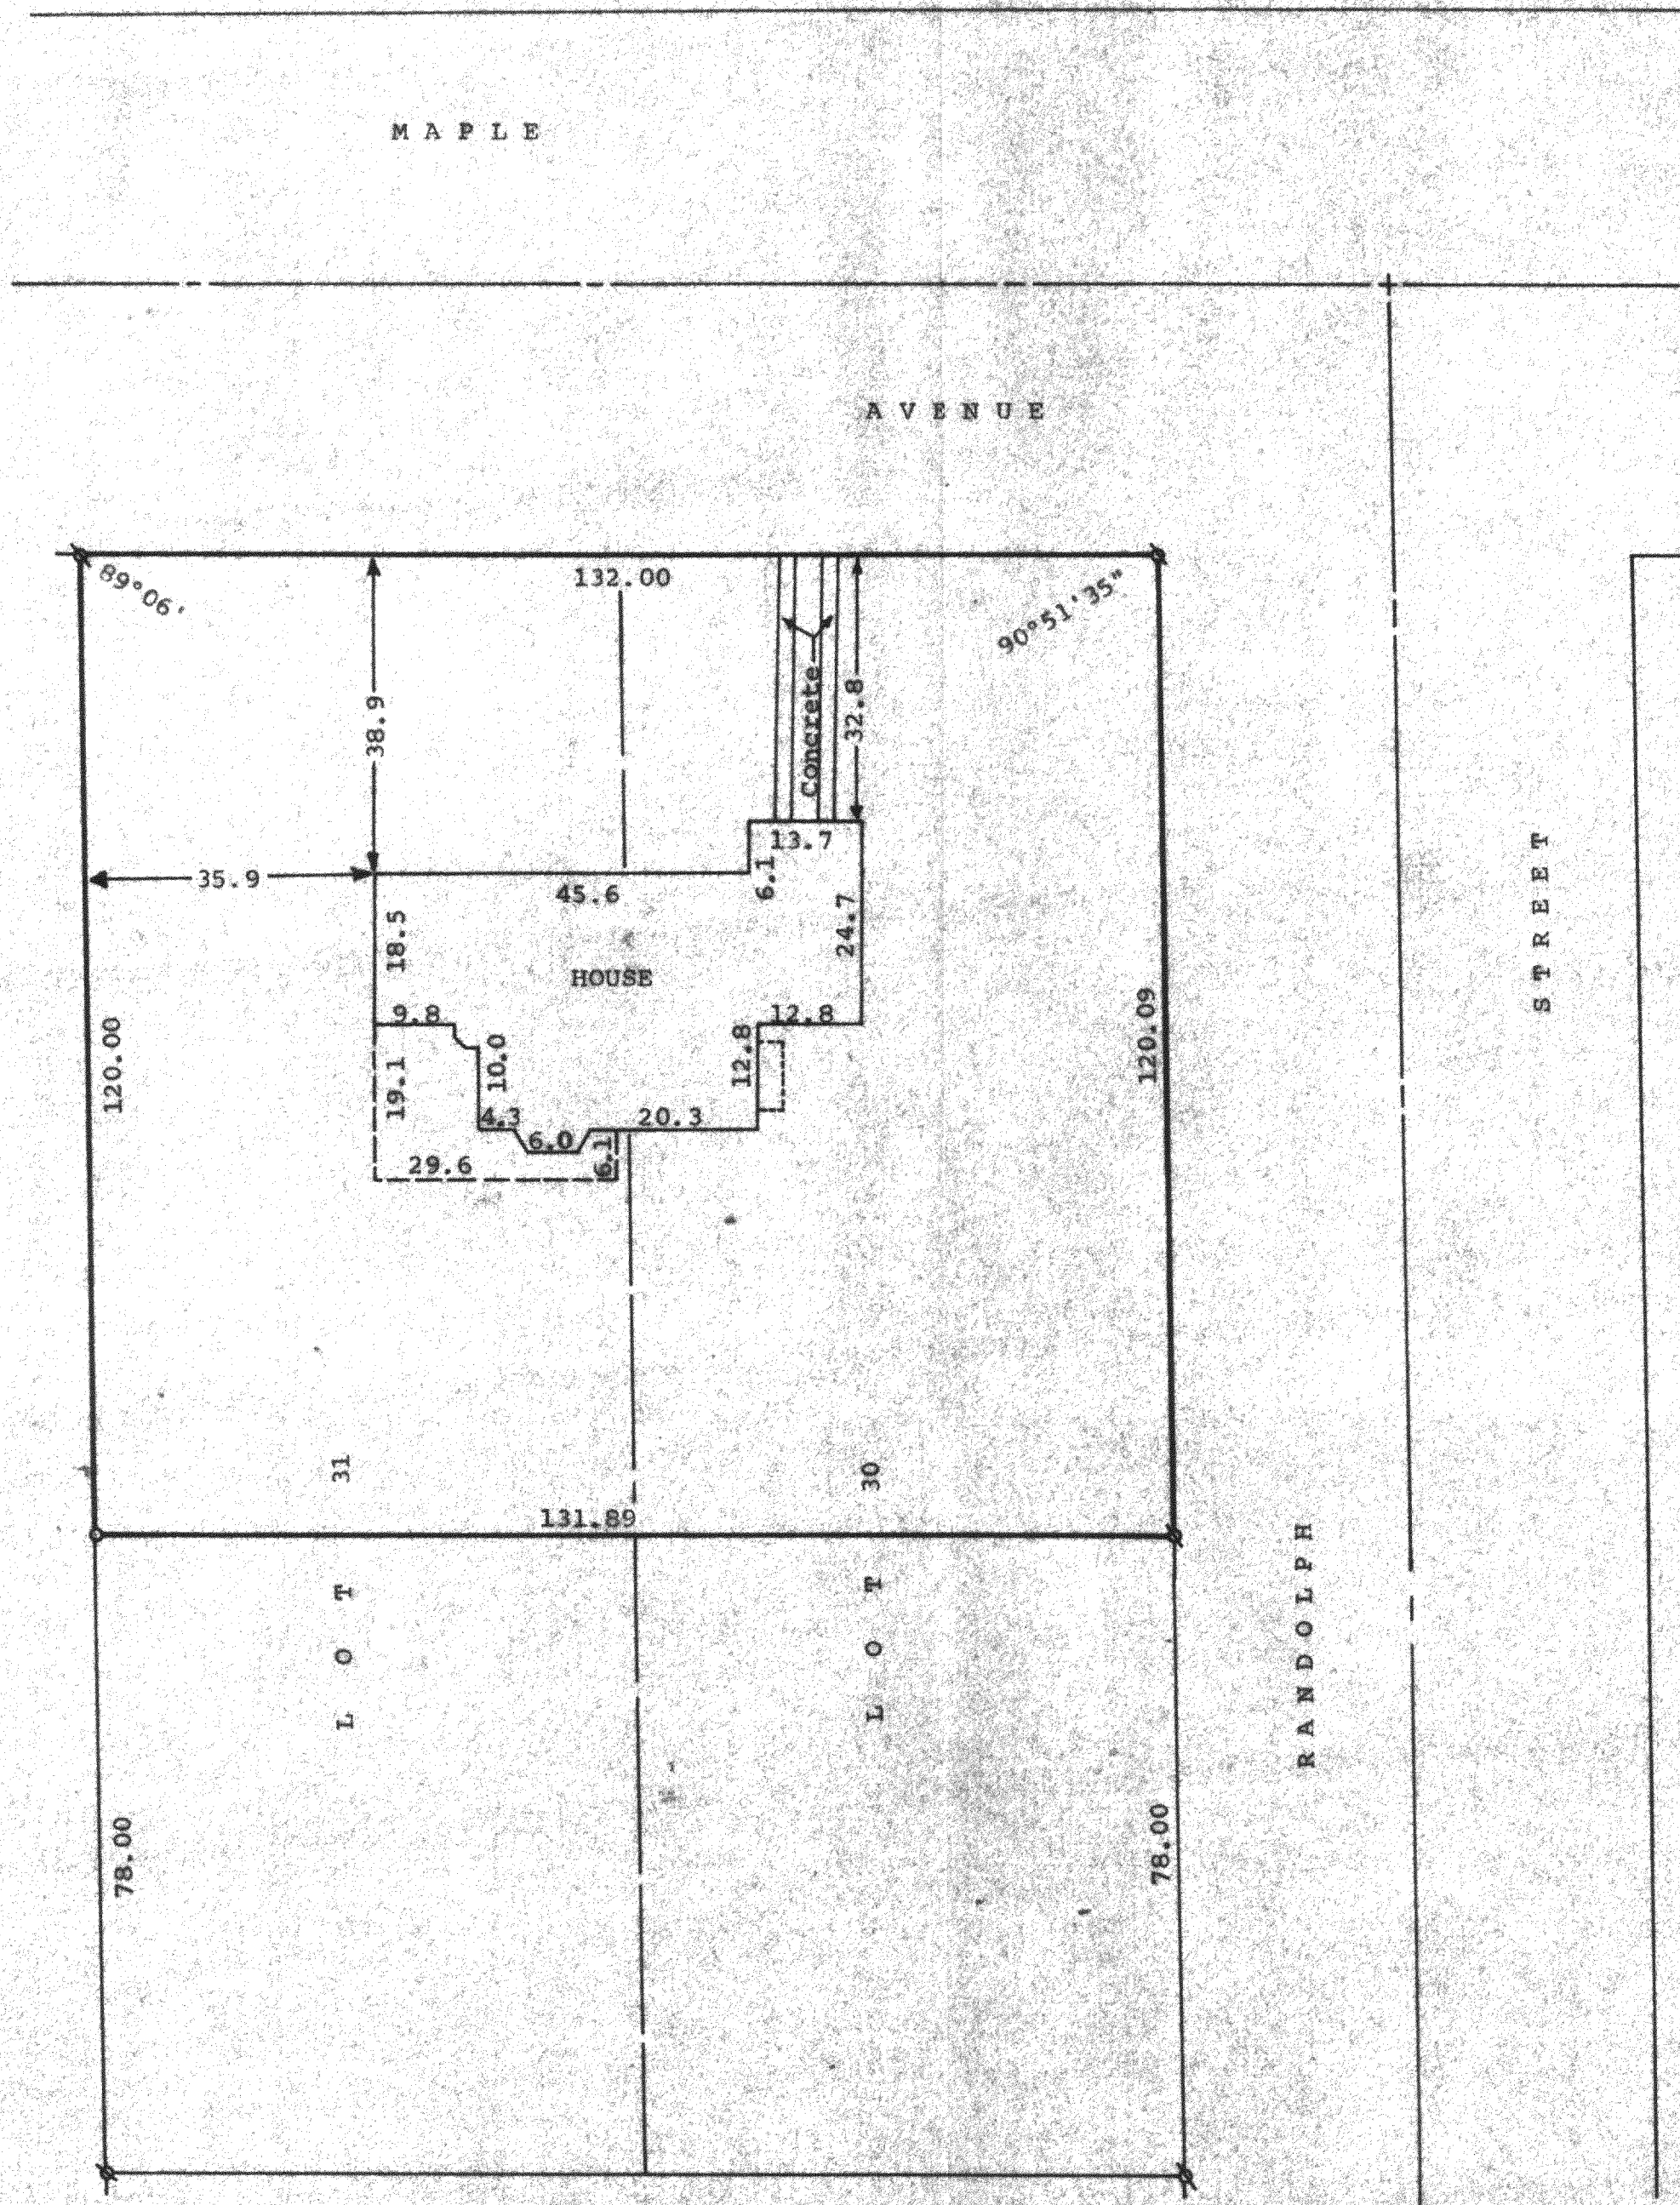

STATE OF WISCONSIN) SS
COUNTY OF WALWORTH)

I, George T. Dunham, Surveyor, certify that I have surveyed
the property described as follows:

Lots 30 and 31 of Clarke's Addition to the Village of
Walworth, Walworth County, Wisconsin, EXCEPTING therefrom
the South 78.00 feet of said Lots,


and that the above map is a true representation thereof and shows the
size and location of the property, its exterior boundaries, the location
of all visible structures and dimensions of all principal buildings
thereon, boundary fences, apparent easements, roadways and visible
encroachments, if any.

This survey is made for the use of the present owners of the property,
and also those who purchase, mortgage, or guarantee the title thereto
within one (1) year from date hereof.

March 10, 1981

Updated and recertified to
this 25th day of April, 1995

George T. Dunham
George T. Dunham, Surveyor

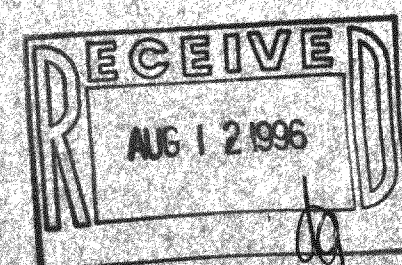

VCA-40
009-560