

AMERICAN SURVEYING COMPANY, INC.

LAND SURVEYORS

12207 C.T.H. "K" FRANKSVILLE, WISCONSIN 53126
TEL. (414) 835-4774 FAX: (414) 835-2379

PLAT OF SURVEY

PREPARED FOR: OAK KNOLLS, LLC
DESCRIPTION:

Lot 59 of "OAK KNOLLS OF WALWORTH, ADDITION NO. 1"A, Being a resubdivision of Outlot No. 1 of "OAK KNOLLS OF WALWORTH" being a subdivision of the Southeast 1/4 of the Southeast 1/4 of Section 22, Town 1 North, Range 16 East, in the Village of Walworth, County of Walworth, State of Wisconsin.

NOTE:



- PROPOSED HOUSE STAKED ON LINE.
- ELEVATIONS BASED ON MUNICIPAL DATUM.
- SUGGESTED YARD GRADE

- SUGGESTED GARAGE SLAB: 923.5

- - DENOTES IRON PIPE FOUND
- - DENOTES IRON ROD SET

LOT AREA: 9224 SF

NOTE: SUGGESTED YARD GRADE MUST BE APPROVED BY THE OWNER AND MUNICIPALITY.

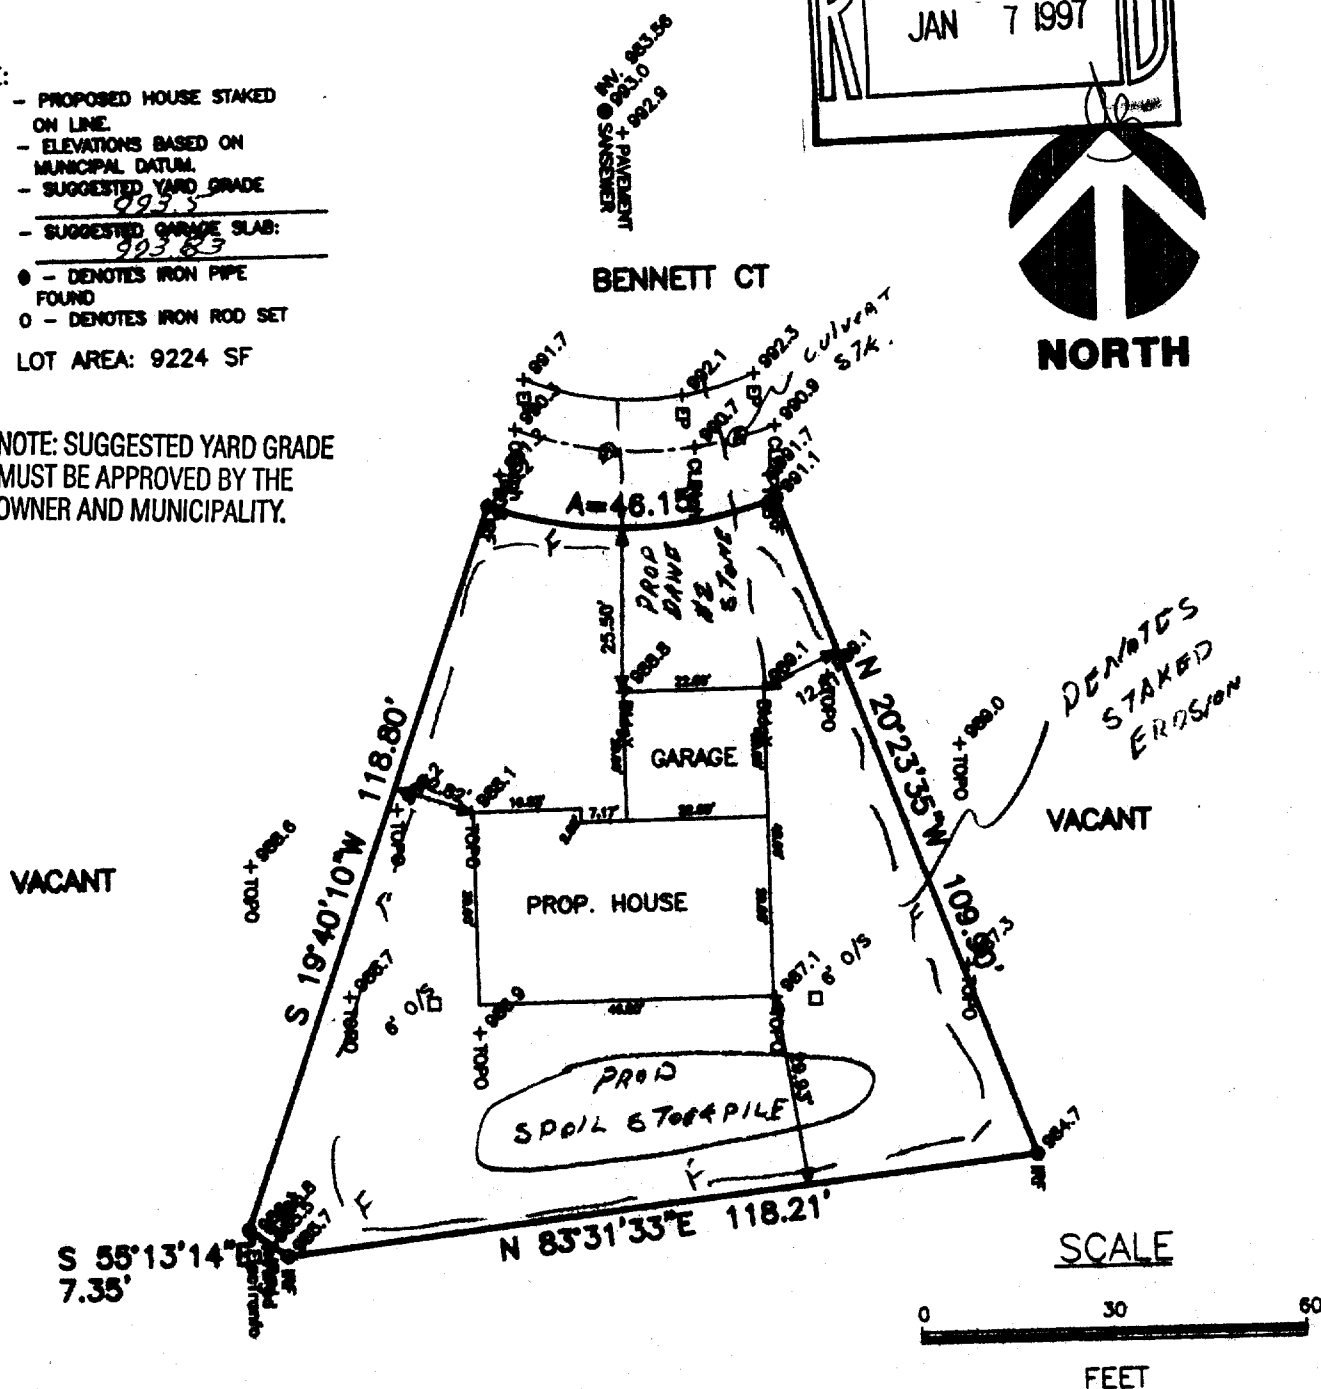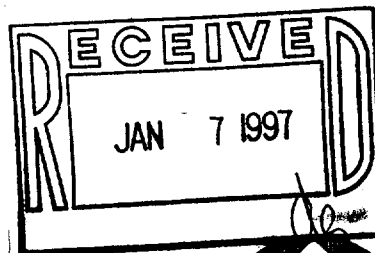

STATE OF WISCONSIN
COUNTY OF RACINE


The above described property has been surveyed under my direction and the above map is a correct representation thereof.

Dated at NORTH CAPE; this 15th day of AUGUST, 1996

Recertified xxxxxxxxxxxxxxxxxxxxxxxxxxxxxxx

Registered Land Surveyor

JOB NO. 96235
DRAWING NAME: 96235

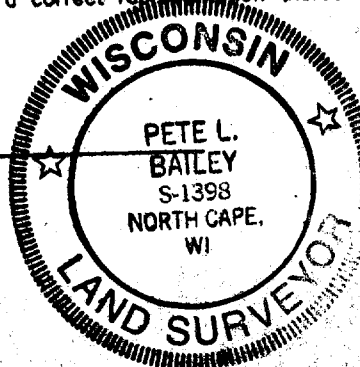

009-580
VOK1-32