


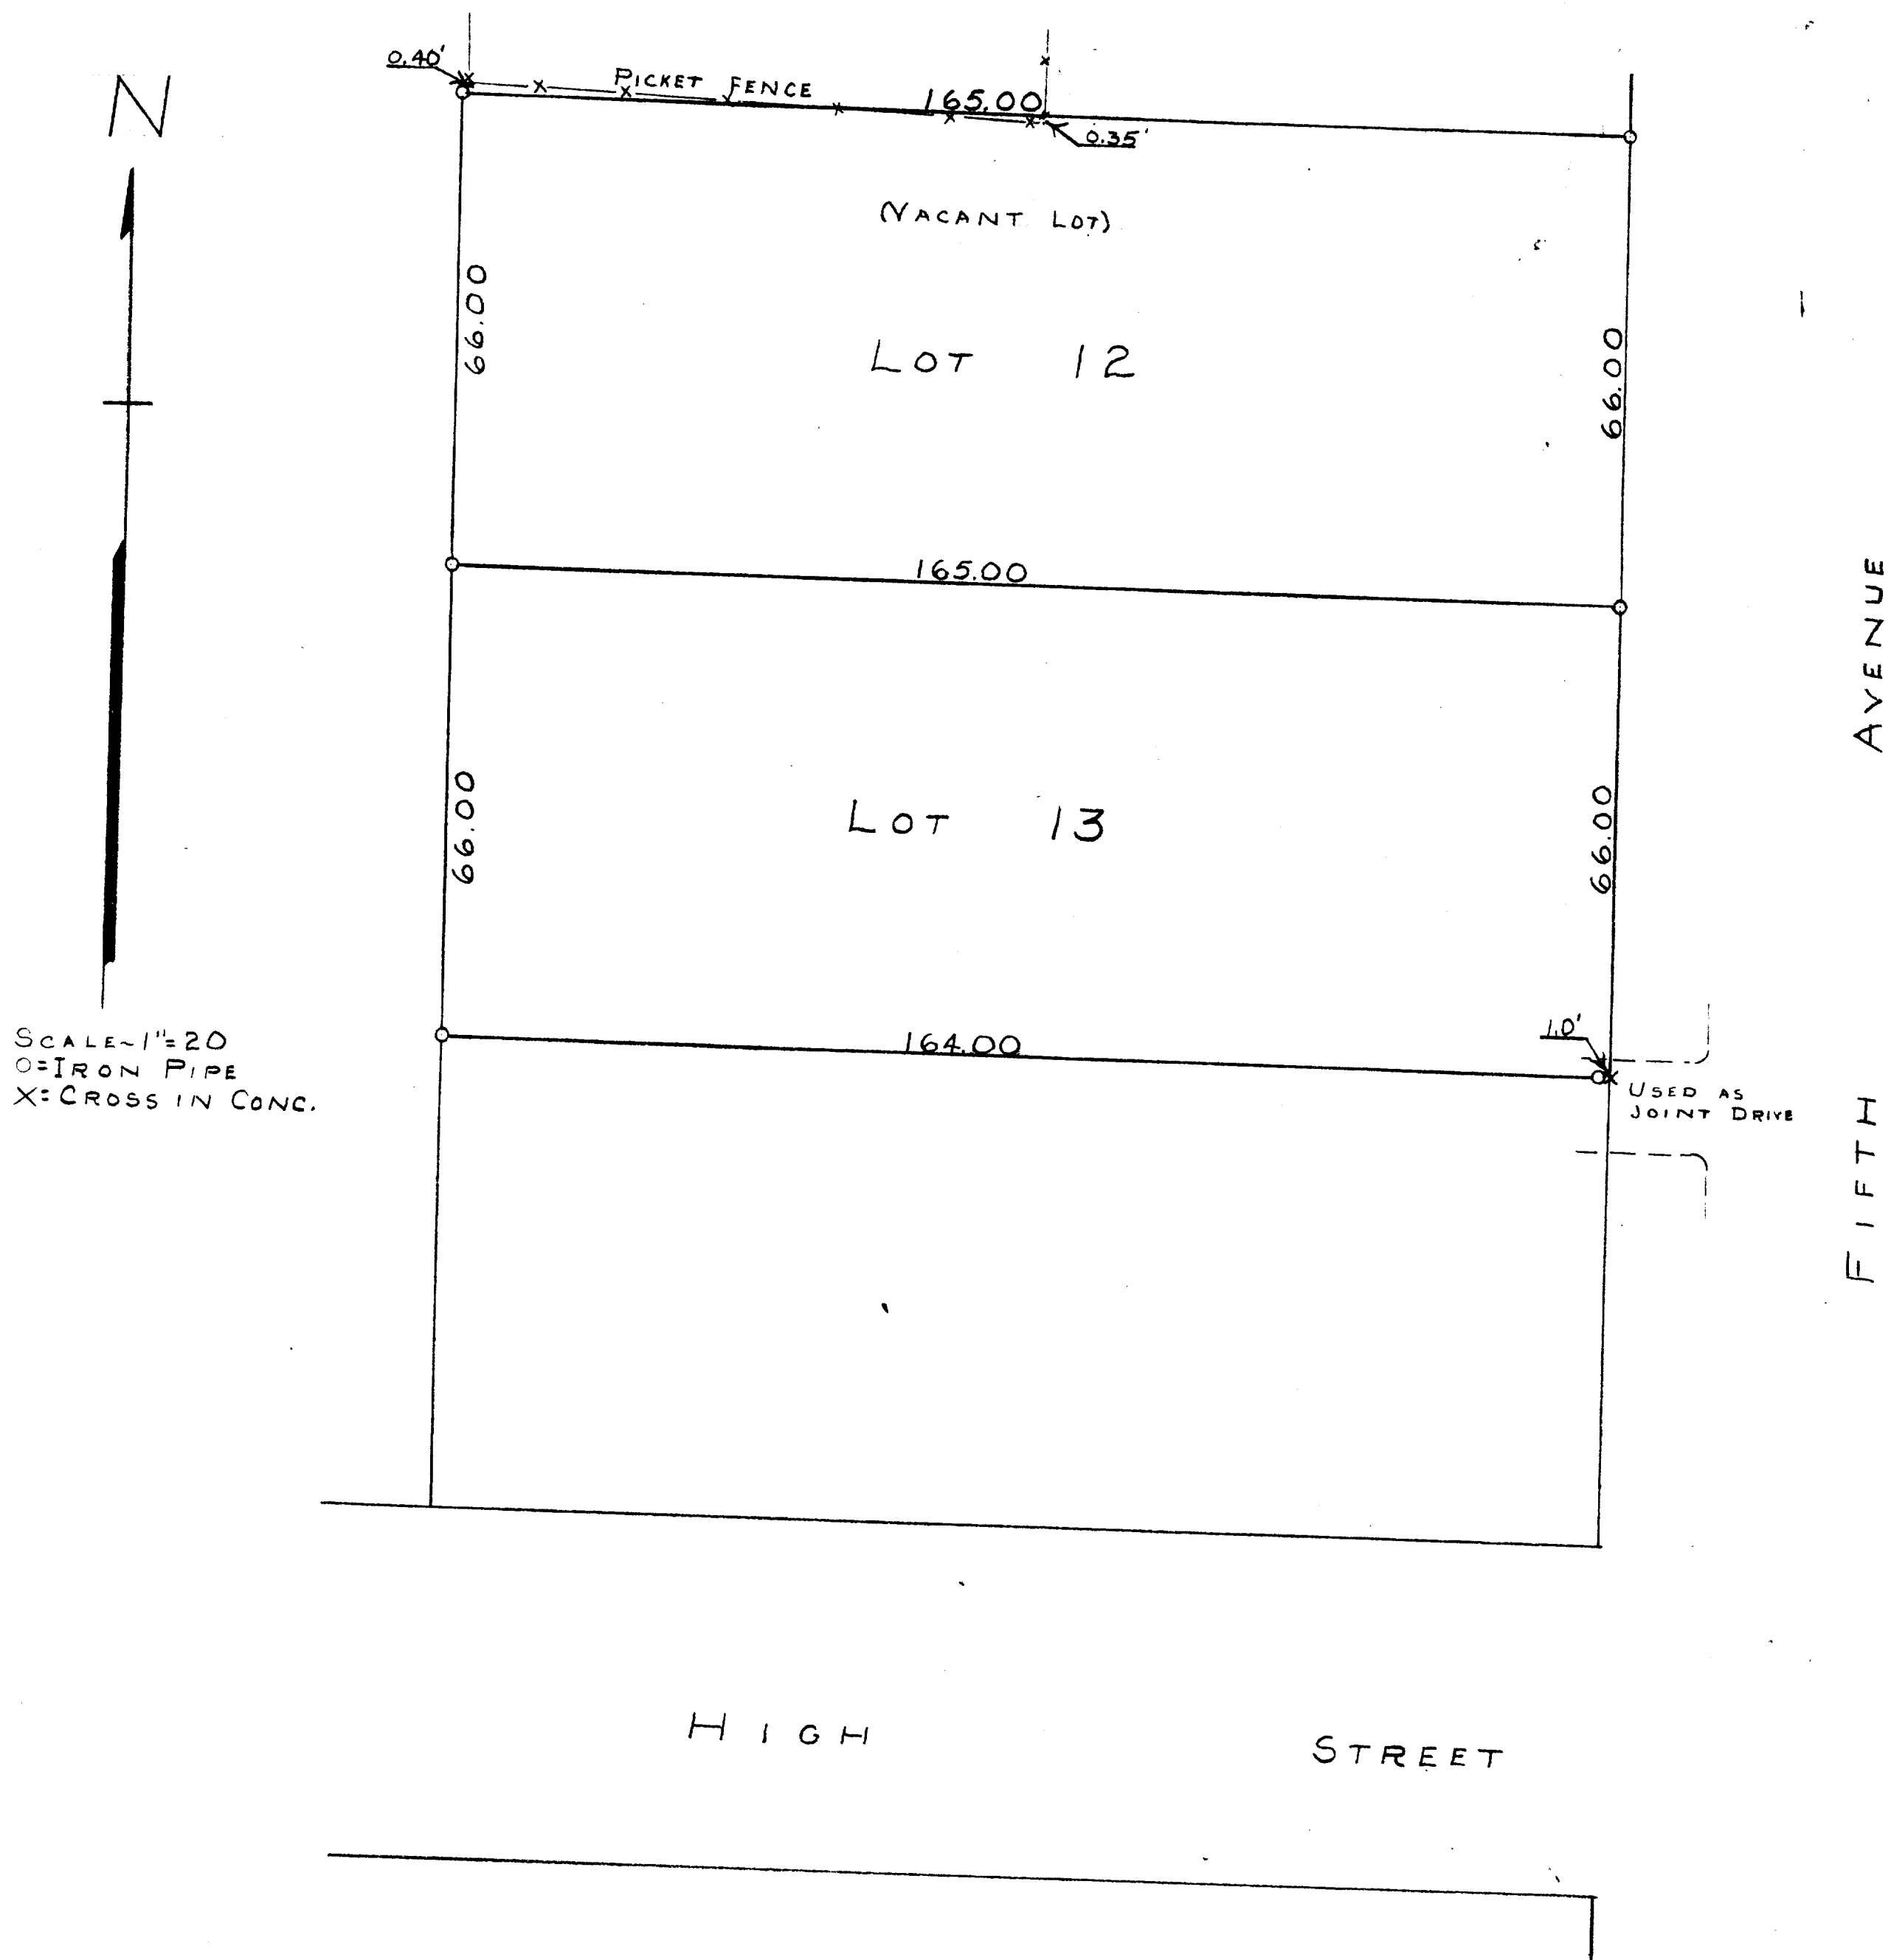

PLAT OF SURVEY OF LOTS 12 AND 13 IN BLOCK 1 OF
E. W. CRUMBS ADDITION TO THE VILLAGE OF WALWORTH,
WALWORTH COUNTY, WISCONSIN
AUGUST 11, 1954

VECR-8,9

George T. Dunham
GEORGE T. DUNHAM, SURVEYOR
DELAVER, WISCONSIN

9-6