


TOPOGRAPHIC SURVEY PLAT


OF A PARCEL OF LAND LOCATED IN THE SOUTHEAST 1/4 OF SECTION 22, T1N,
R16E, VILLAGE OF WALWORTH, WALWORTH COUNTY, WISCONSIN.

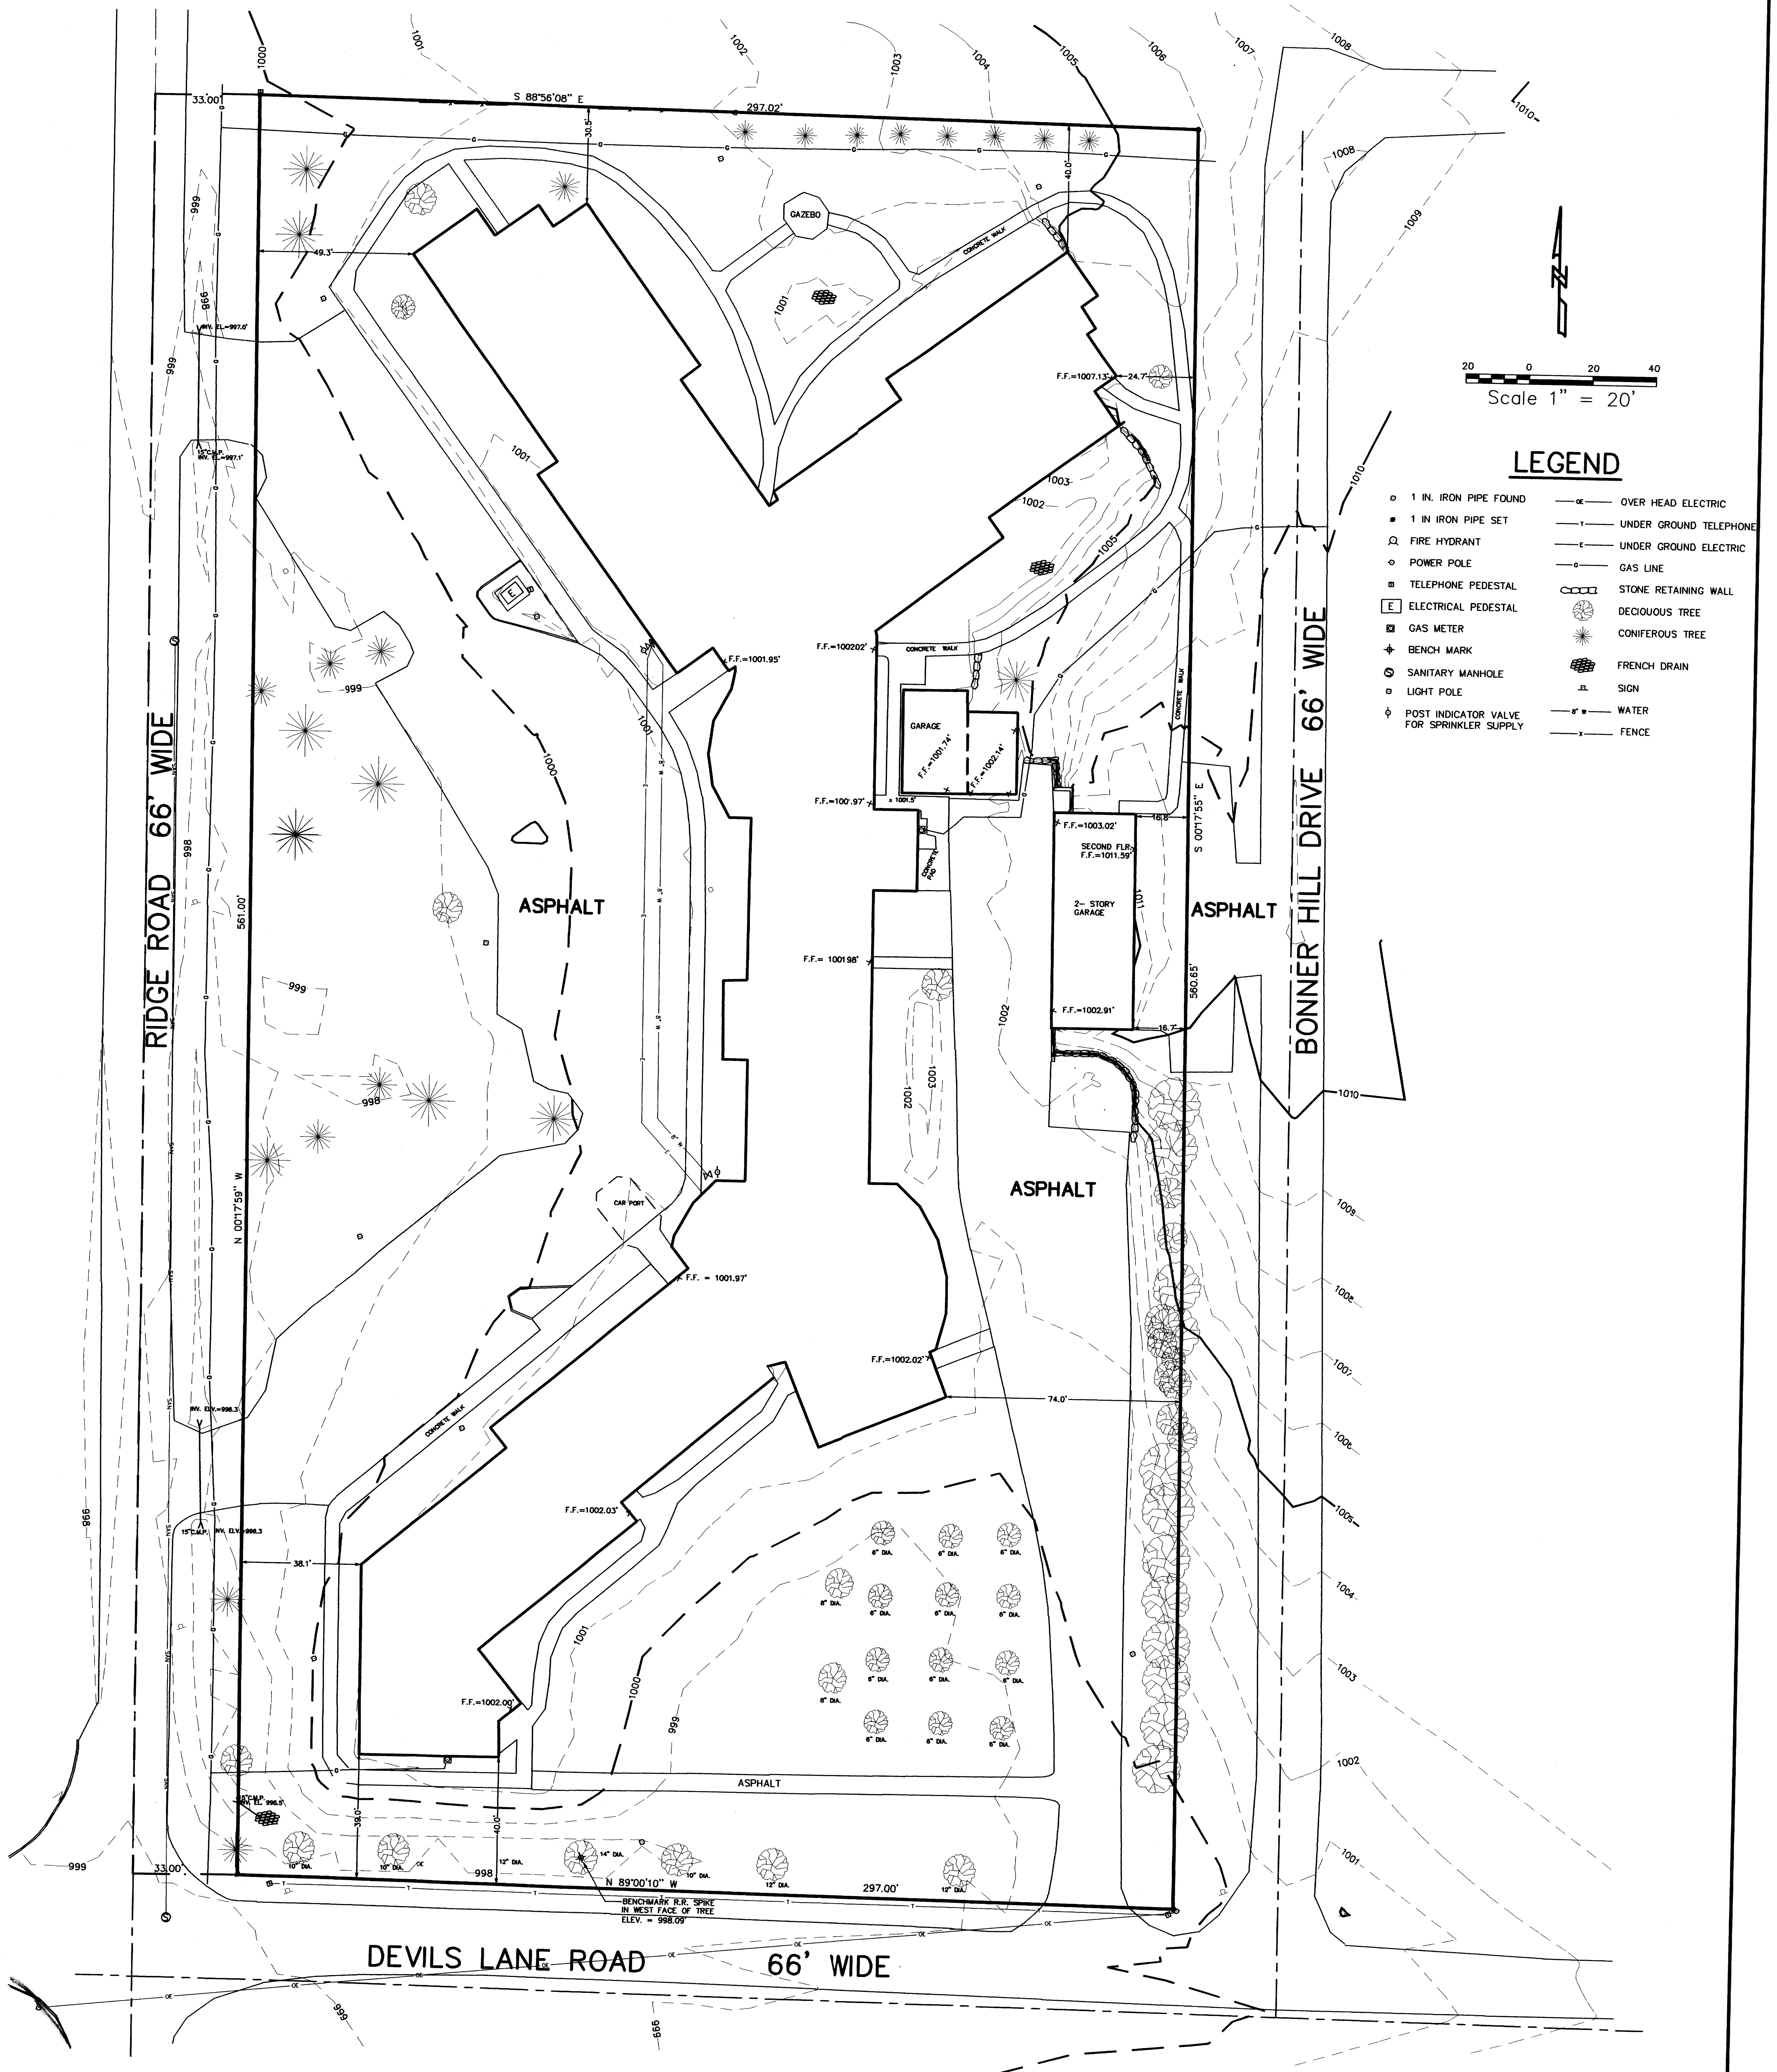

ORDERED BY: THE GOLDEN YEARS OF WALWORTH

RICHARD T. AUSTIN, EXECUTIVE DIRECTOR
270 RIDGE ROAD
WALWORTH, WISCONSIN 53184

PATHFINDER SURVEYING
FORMERLY KOLB LAND CONSULTING
929 WILLIAMS STREET, LAKE GENEVA, WI. 53147
(414)-248-3697

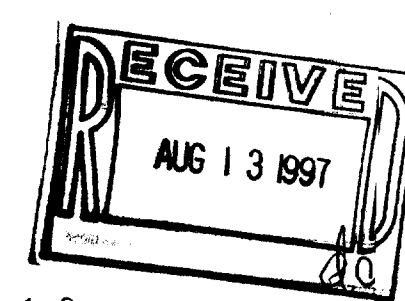

JOHN P. KROTT
WISCONSIN REGISTERED LAND SURVEYOR. S-2258
DATE: 7-15-1997



THIS IS NOT A CERTIFIED COPY
UNLESS SEAL IS IN RED.