

ABERNATHY and ASSOCIATES

Kenneth B. Abernathy Jr.


Wisconsin Registered Land Surveyor S-1594

Rt. 3, Box 273
Elkhorn, Wisconsin 53121
Phone: (414) 723-4260 (office)
(414) 723-4813 (residence)

PLAT OF SURVEY

LOT 81, OAK KNOLLS OF WALWORTH ADDITION
NO. 1, LOCATED IN THE SOUTHEAST 1/4 OF
SECTION 22, TOWN 1 NORTH, RANGE 16 EAST,
IN THE VILLAGE OF WALWORTH, WALWORTH
COUNTY, WISCONSIN.

GREGORY ST. 66' WIDE

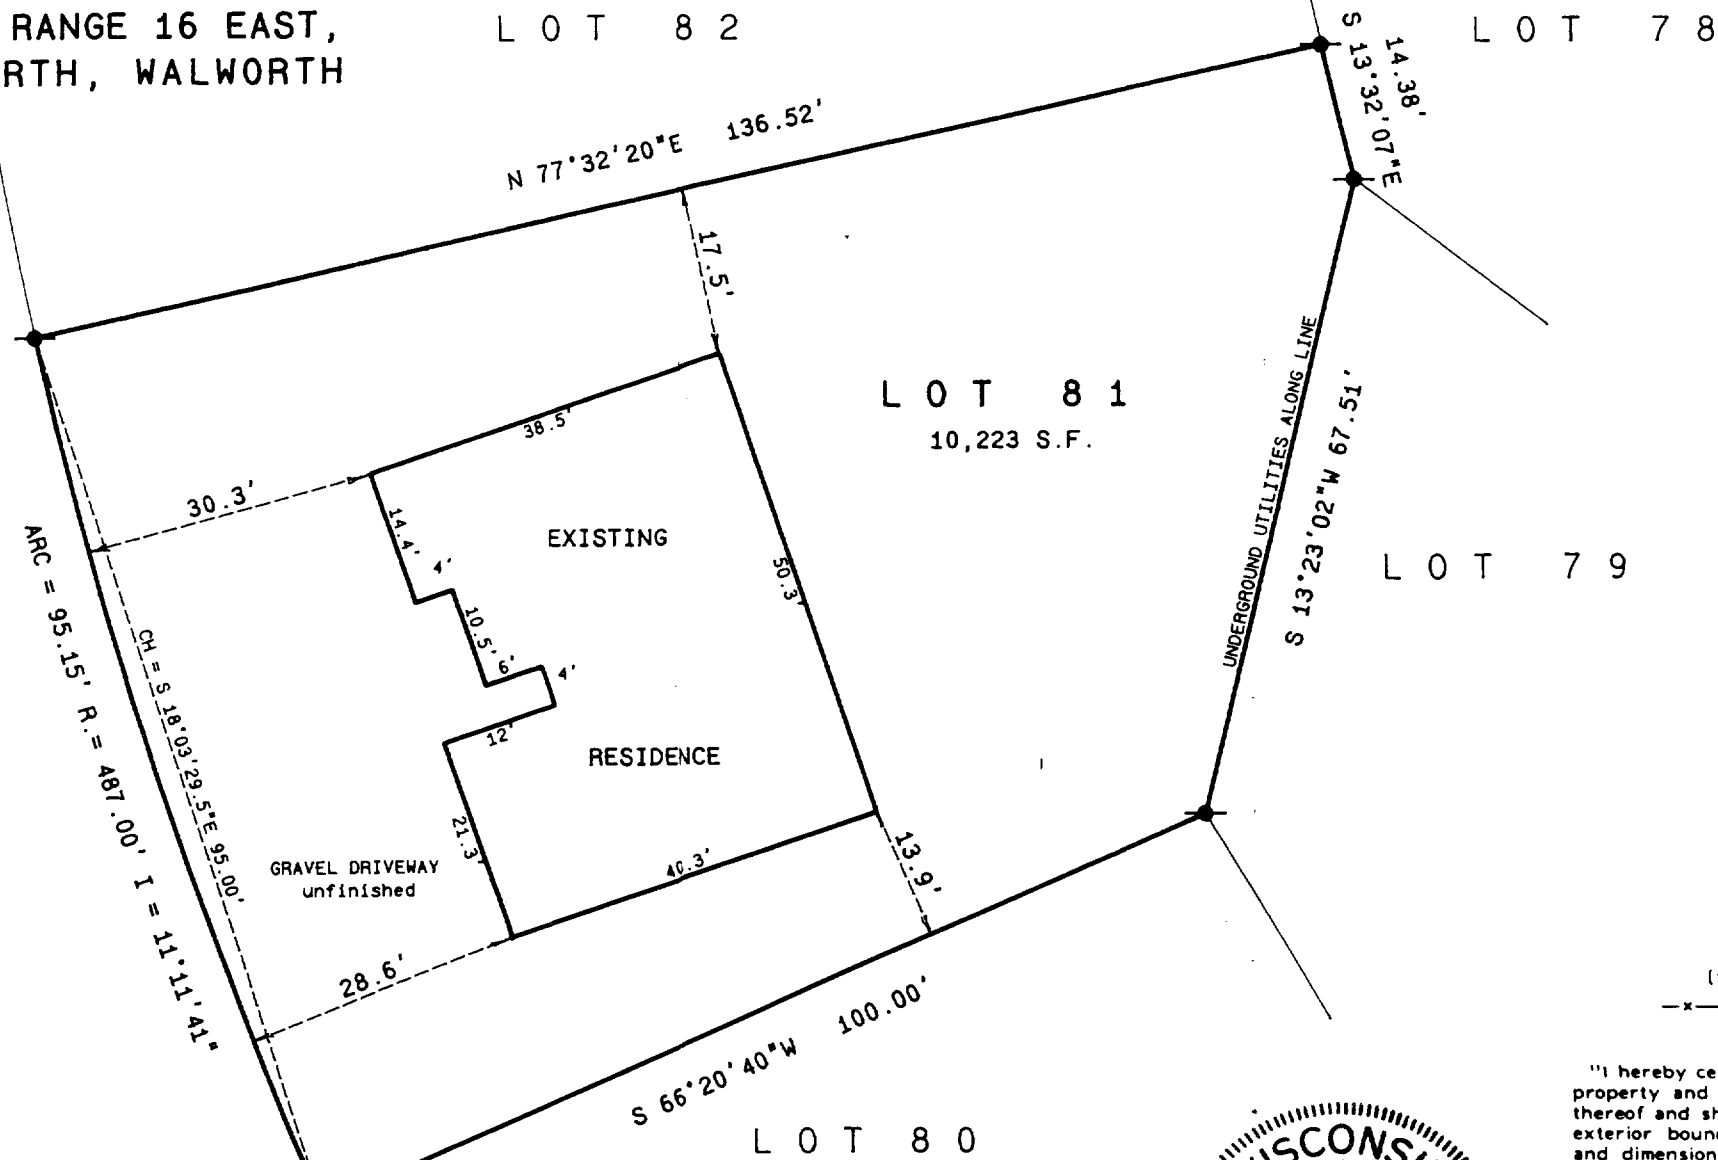

ORDERED BY: RAULAND AGENCY
P.O. BOX 159
WALWORTH, WI. 53184

OWNERS: OAK KNOLLS, L.L.C.



"I hereby certify that I have surveyed the above described property and that the above map is a true representation thereof and shows the size and location of the property, its exterior boundaries, the location of all visible structures and dimensions of all principal buildings thereon, boundary fences, apparent easements, roadways and visible encroachments, if any."

"This survey is made for the use of the present owners of the property, and also those who purchase, mortgage, or guarantee the title thereto within one year from date hereof."

Kenneth B. Abernathy, Jr.

KENNETH B. ABERNATHY, JR.
WISCONSIN REGISTERED LAND SURVEYOR,
S-1594

Date: 5/11/98 Job No. 98.509

VOKI-54 009-651