

AMERICAN SURVEYING COMPANY, INC.

LAND SURVEYORS



12207 C.T.H. "K" FRANKSVILLE, WISCONSIN 53126
TEL. (414) 835-4774 FAX: (414) 835-2379

PLAT OF SURVEY



PREPARED FOR: PEMBROOK HOME, LLC
OWNERS: BIATRIS VARA & ARMONDO GUZMAN

DESCRIPTION: LOT 2 OF "VALLEY SUBDIVISION", A RESUBDIVISION OF LOT 3 OF CERTIFIED SURVEY MAP NO. 1832 AS RECORDED IN VOLUME 8 OF CERTIFIED SURVEY MAPS AS PAGES 329- AND 330 AS DOCUMENT NO. 179574, AND PART OF CERTIFIED SURVEY MAP NO. 1335 AS RECORDED IN VOLUME 6 OF CERTIFIED SURVEY MAPS AS PAGE 192 AS DOCUMENT NO. 102850, LOCATED IN THE SOUTHWEST 1/4 OF THE SOUTHEAST 1/4 OF SECTION 22, TOWN 1 NORTH, RANGE 16 EAST, IN THE VILLAGE OF WALWORTH, COUNTY OF WALWORTH, STATE OF WISCONSIN.

-DWELLING UNDER CONSTRUCTION
-TOP OF WALL: 996.40

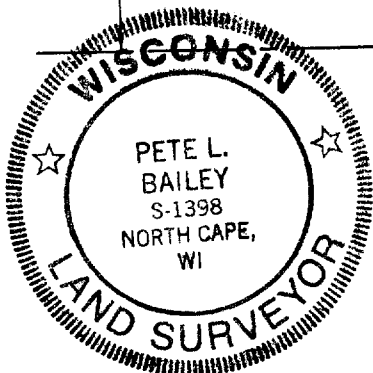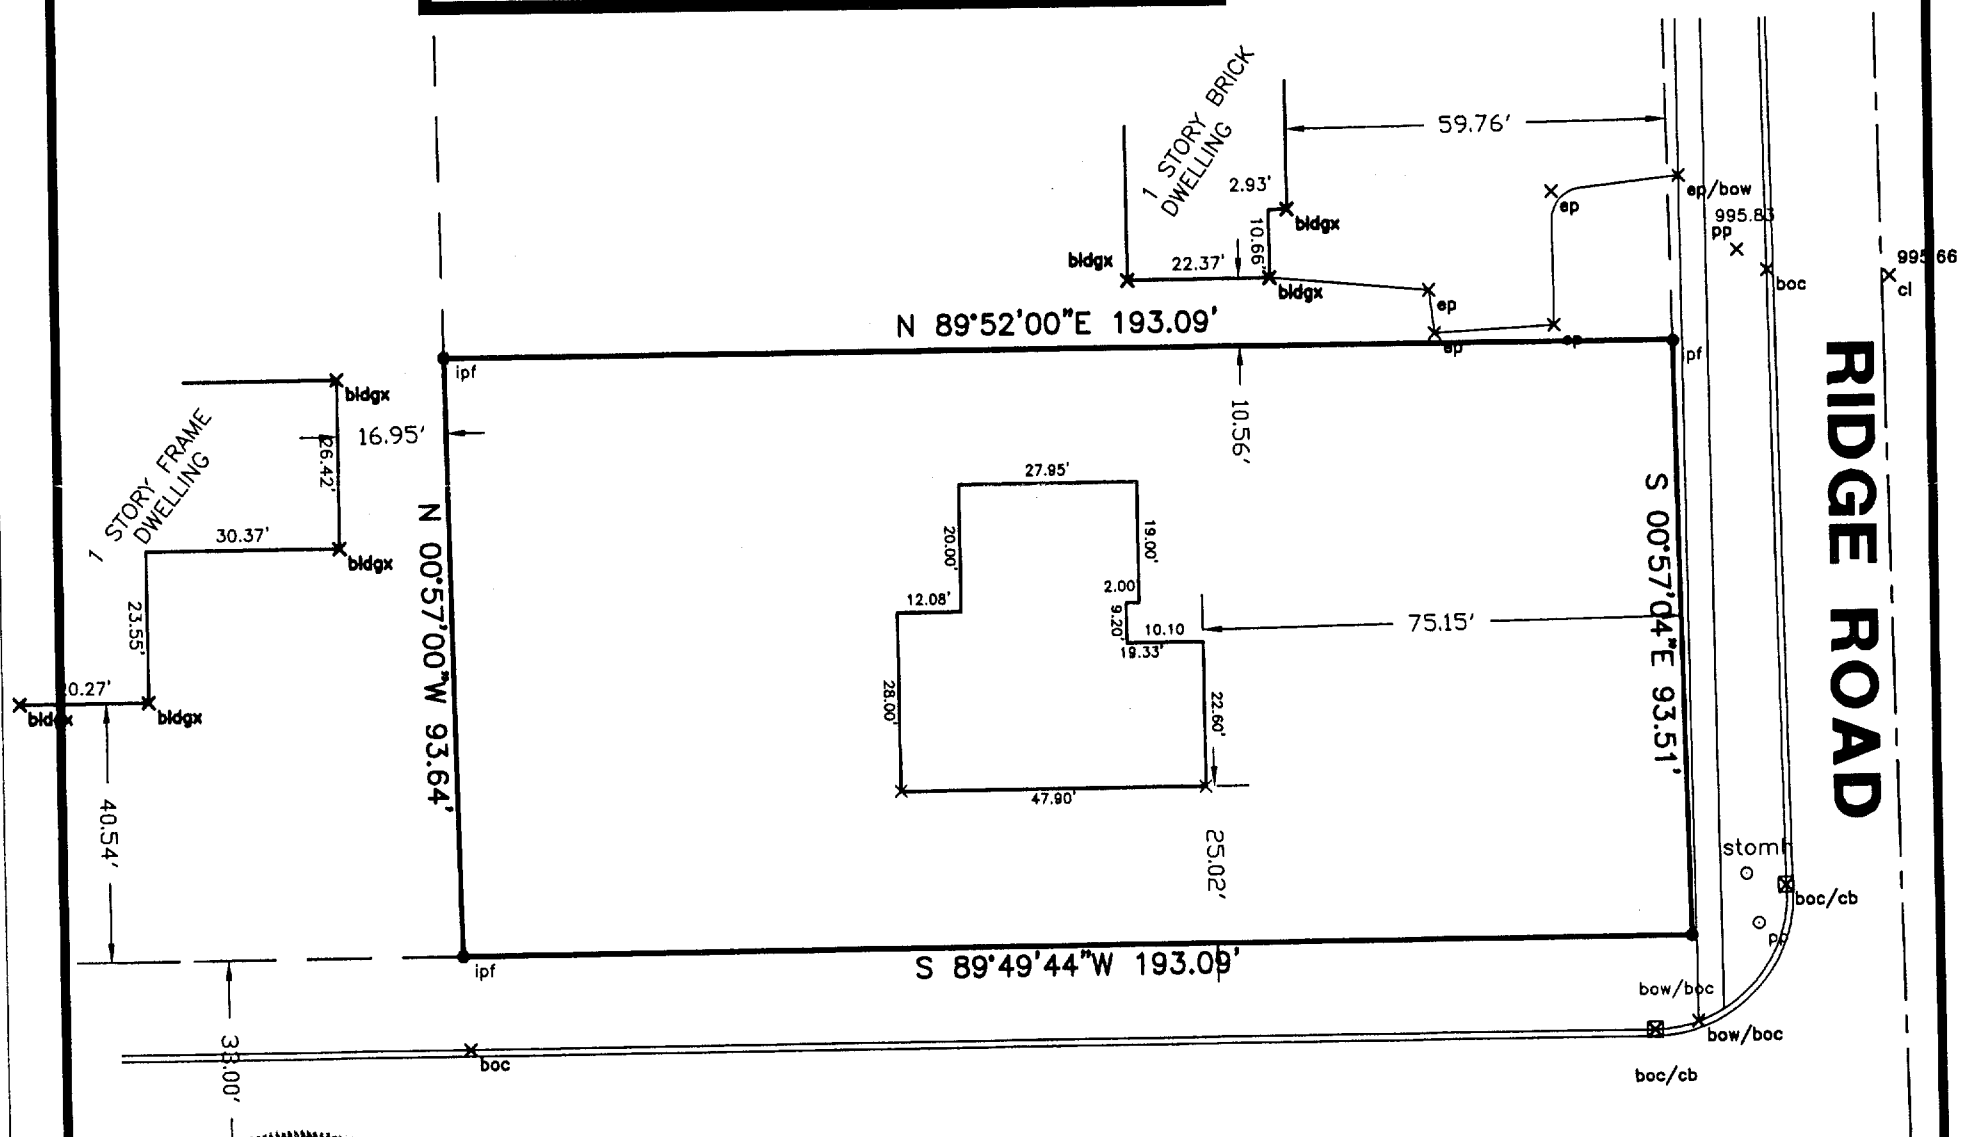

CASEY LANE

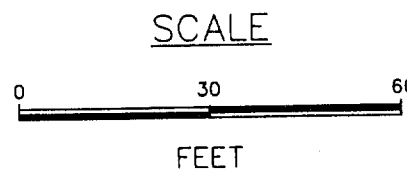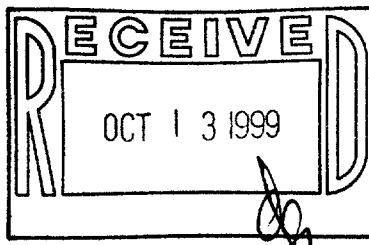

STATE OF WISCONSIN
COUNTY OF RACINE

I hereby certify that I have surveyed the above described property and the above map is a true representation thereof and shows the size and location of the property, its exterior boundaries, the location of all visible structures and dimensions of all principle buildings thereon, boundary fences, apparent easements, roadways and visible encroachments, if any.

This survey is made for the present owners of the property, and also those who purchase, mortgage, or guarantee the title thereto within one (1) year from the date thereof.

Dated at NORTH CAPE, WISCONSIN, this 2ND day of AUGUST, 1999.

Recertified SEPTEMBER 12TH, 1999

DRAWN BY: PLB
CHECKED BY: PLB

Registered Land Surveyor
JOB NO. 99201
DRAWING NAME: JN99218

VA-1832-2 009-695