

ABELL SURVEYING & MAPPING

1140 SEQUOIA STREET • DELAVAN, WISCONSIN 53115
414-728-6737

DEC 29 1999


HOWARD

STREET

AVENUE

FIFTH

ADDITIONAL IRON PIPE FOUND 0.02' NORTH AND 0.50' EAST OF THE NORTHWEST CORNER OF LOT 4

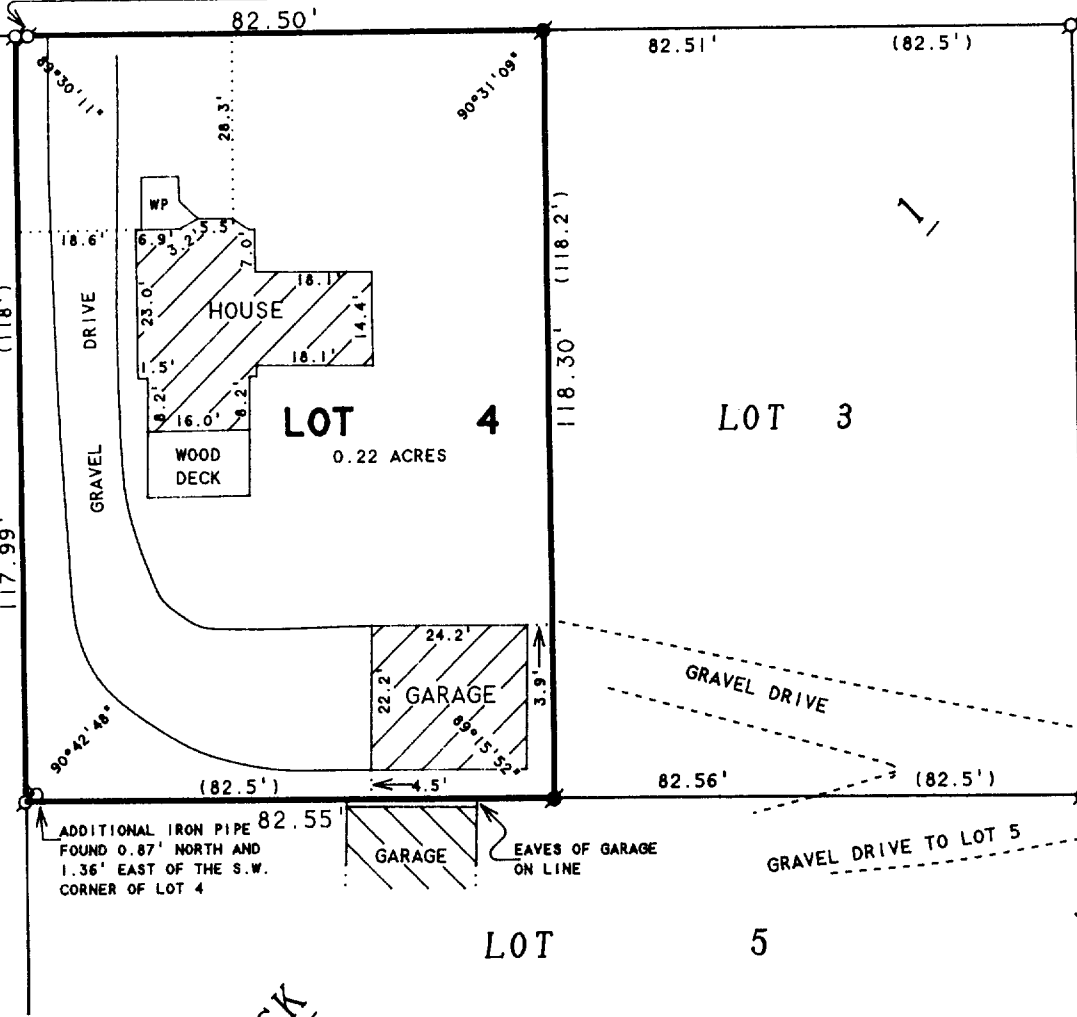

ORDERED BY: MIKE TRIESCHMANN
335 HOWARD ST.
WALWORTH, WI 53184

PLAT OF SURVEY OF

LOT 4, BLOCK 1, E.W. CRUMBS ADDITION TO THE VILLAGE OF WALWORTH, WALWORTH COUNTY, WISCONSIN.

N



SCALE 1"=30'

LEGEND

- - IRON PIPE FOUND
- - IRON ROD FOUND
- WP - WOOD PORCH
- () - RECORDED AS

I HEREBY CERTIFY THAT I HAVE SURVEYED THE ABOVE DESCRIBED PROPERTY AND THAT THE ABOVE MAP IS A TRUE REPRESENTATION THEREOF AND SHOWS THE SIZE AND LOCATION OF THE PROPERTY, ITS EXTERIOR BOUNDARIES, THE LOCATION OF ALL VISIBLE STRUCTURES AND DIMENSIONS OF ALL PRINCIPAL BUILDINGS THEREON, BOUNDARY FENCES, APPARENT EASEMENTS, ROADWAYS AND VISIBLE ENCROACHMENTS, IF ANY, TO THE BEST OF MY KNOWLEDGE AND BELIEF.

THIS SURVEY IS MADE FOR THE USE OF THE PRESENT OWNERS OF THE PROPERTY, AND ALSO THOSE WHO PURCHASE, MORTGAGE, OR GUARANTEE THE TITLE THERETO WITHIN ONE (1) YEAR FROM DATE HEREON.

David F. Abell

DAVID F. ABELL
WISCONSIN REGISTERED LAND SURVEYOR, S-1596

September 23, 1999

DATE: JOB NUMBER - 93199B
NOTE: THIS IS NOT A CERTIFIED COPY UNLESS SEALED.

VECR-2

009-699