


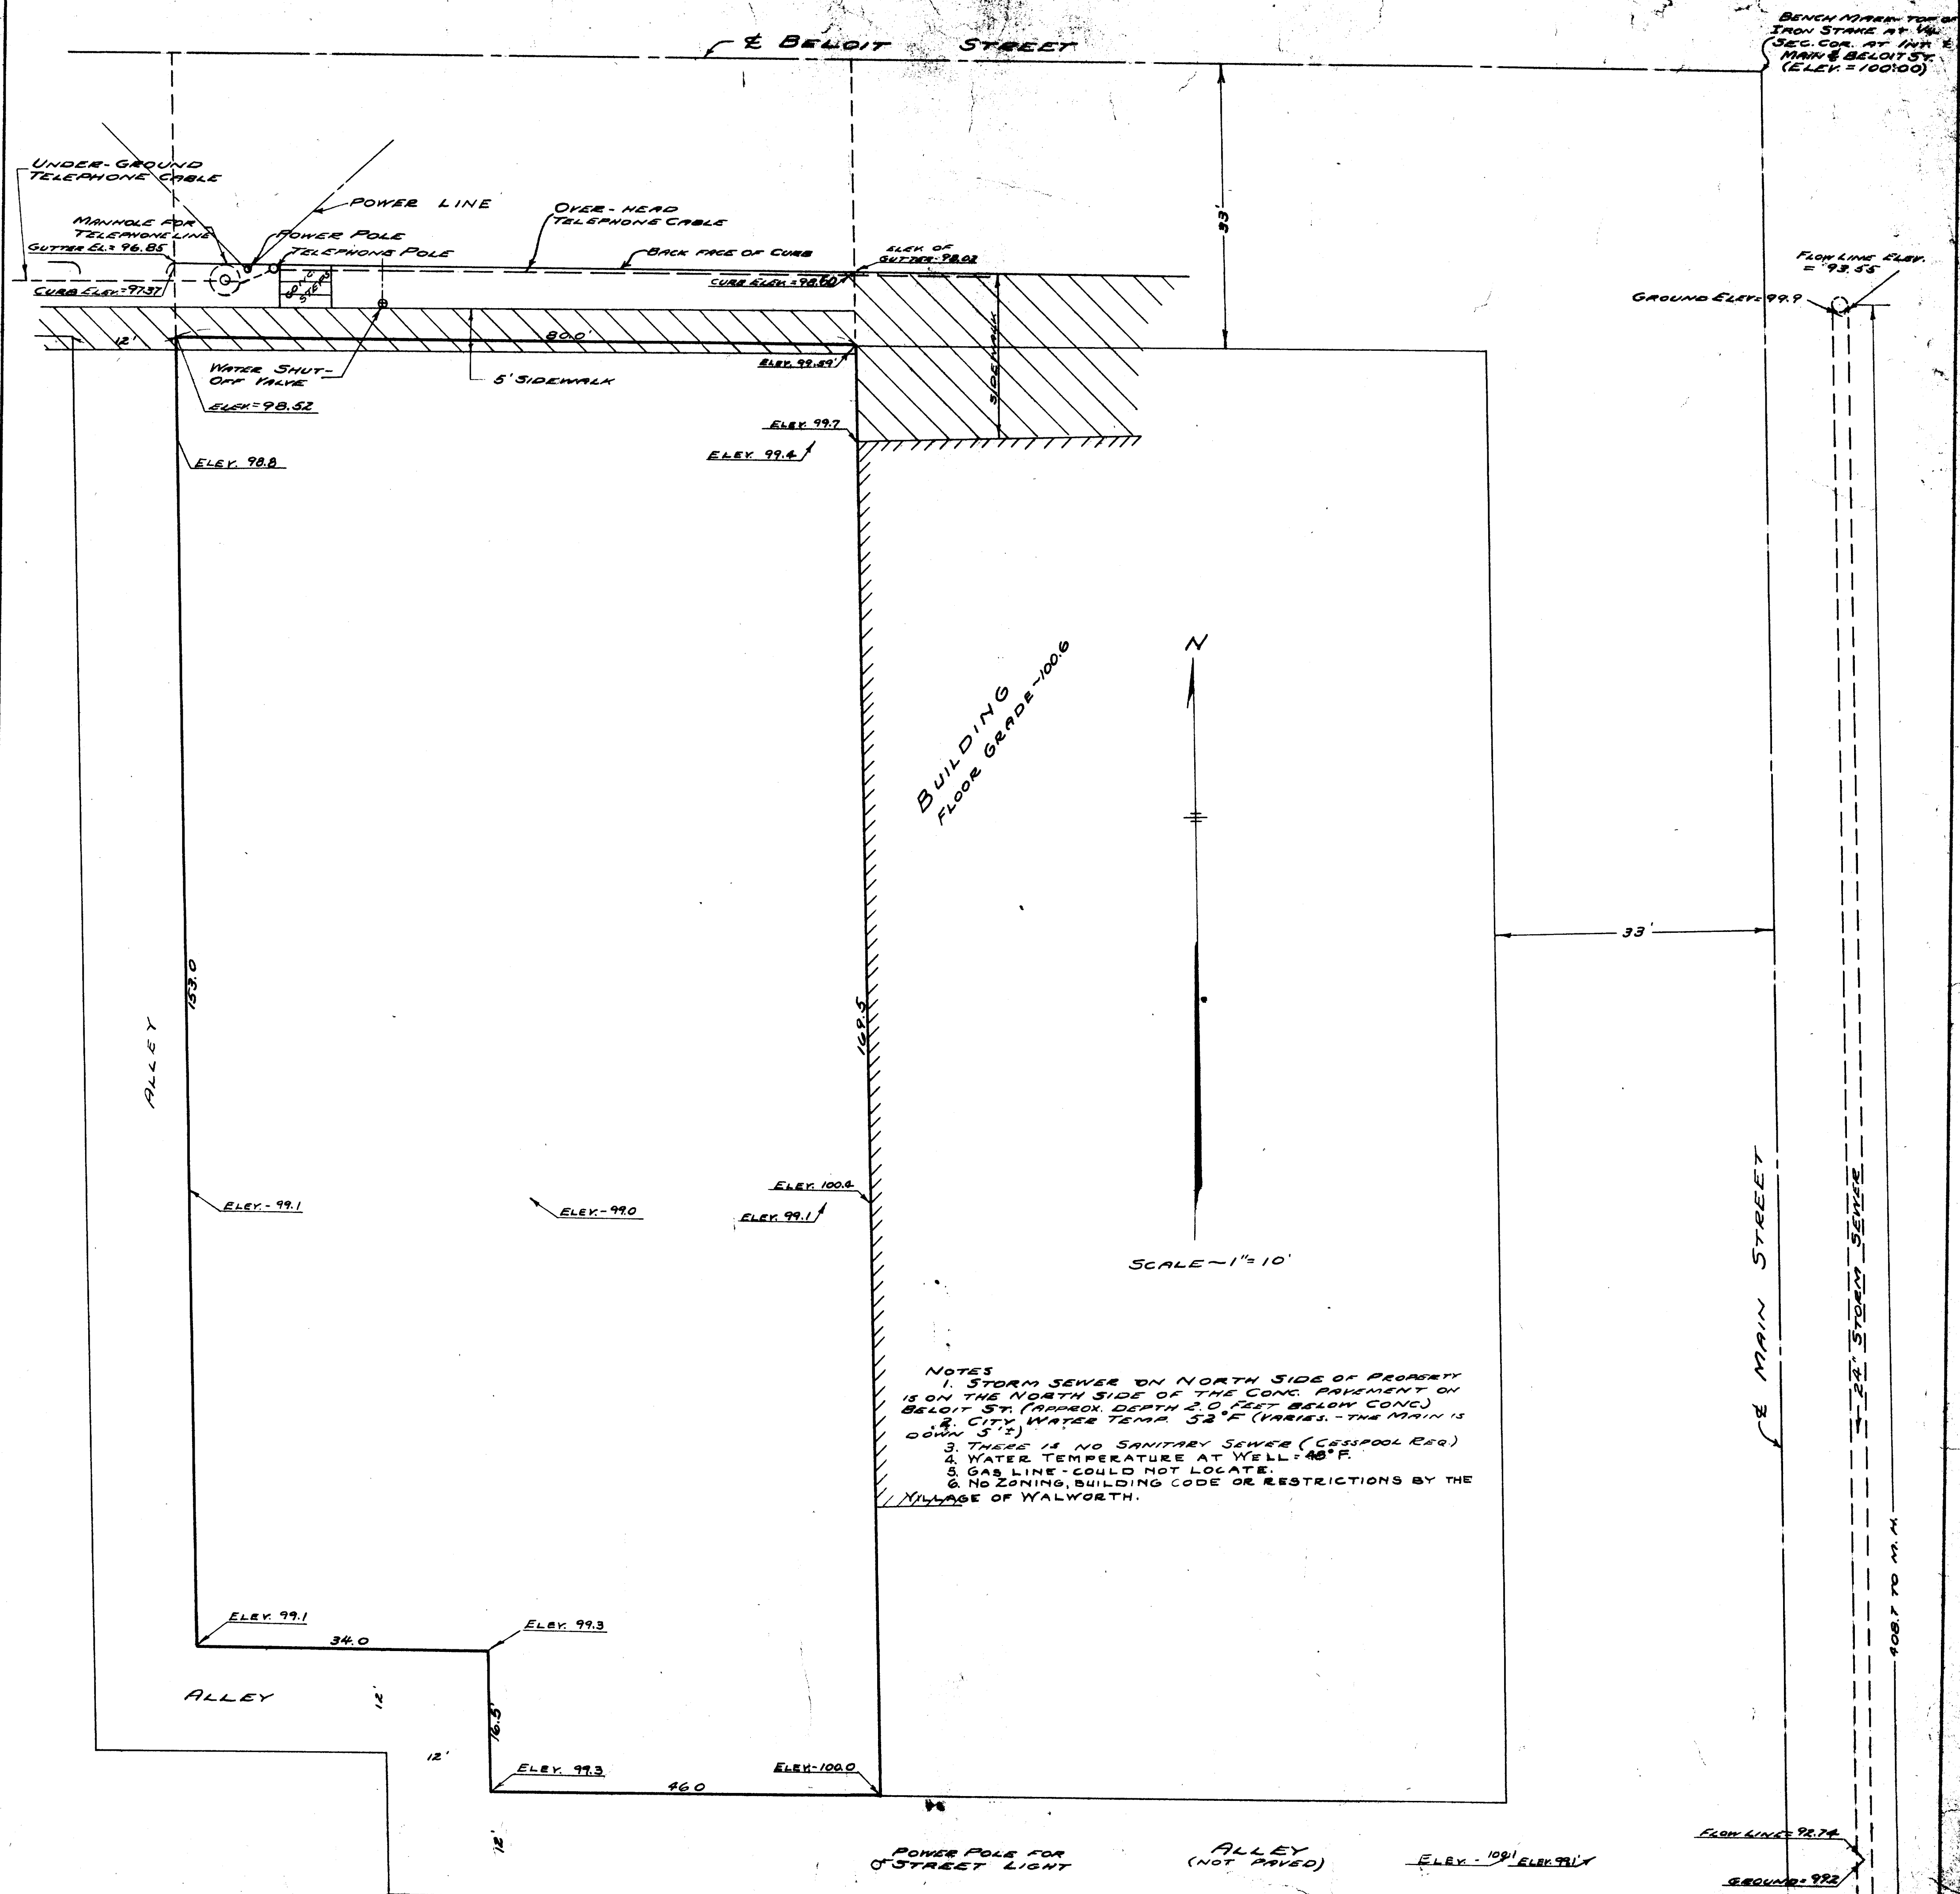

PLAT OF SURVEY TO SHOW ELEVATIONS AND INFORMATION
 FOR BUILDING ON OUTLOT 82 IN THE VILLAGE OF WALWORTH, WISC.

MARCH 7, 1946

H.E. Johnson
 SURVEYOR