


GEORGE T. DUNHAM
SURVEYING & SUBDIVIDING
DELAVER, WISCONSIN

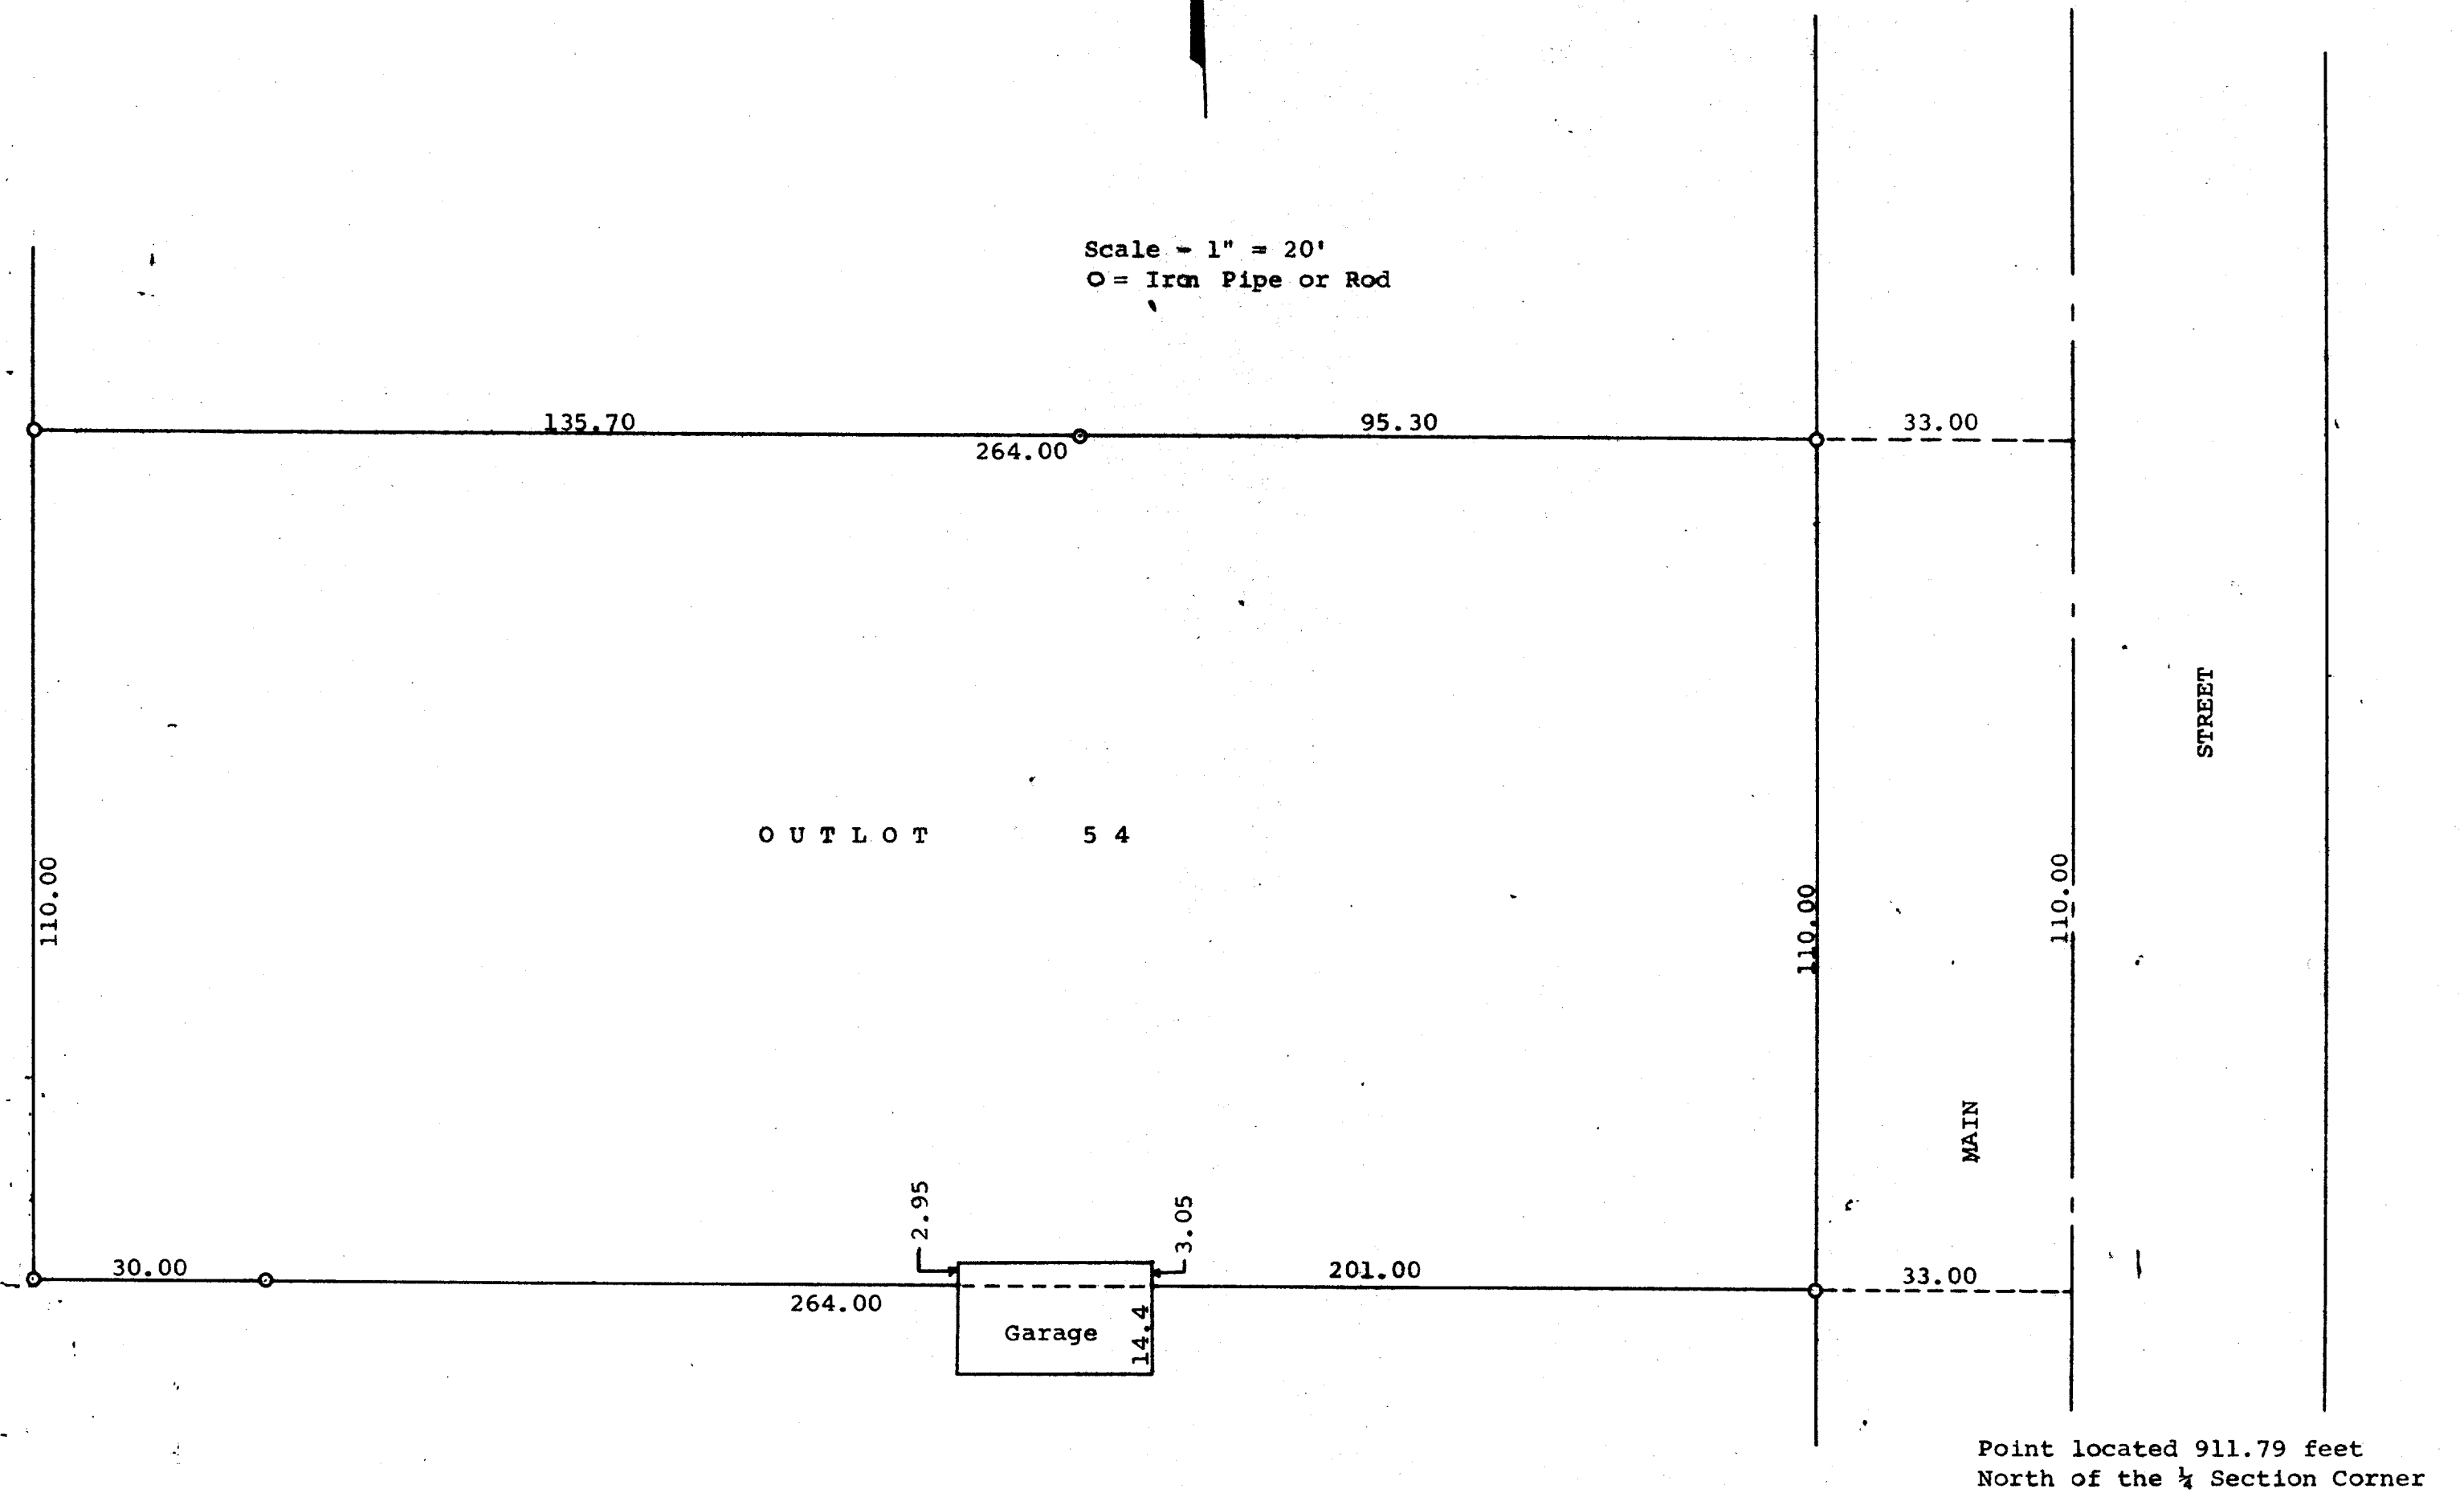

Scale - 1" = 20'
O = Iron Pipe or Rod



Plat of survey of Outlot 54 of the Assessors Plat
of the Village of Walworth, Walworth County, Wisconsin.
October, 1968

George T. Dunham
George T. Dunham, Surveyor