


WALWORTH COUNTY SURVEYING & MAPPING

P. O. BOX 1115
LAKE GENEVA, WISCONSIN
414-248-0505

ORDERED BY: THE RAULAND AGENCY
118 KENOSHA STREET
WALWORTH, WISCONSIN
53184

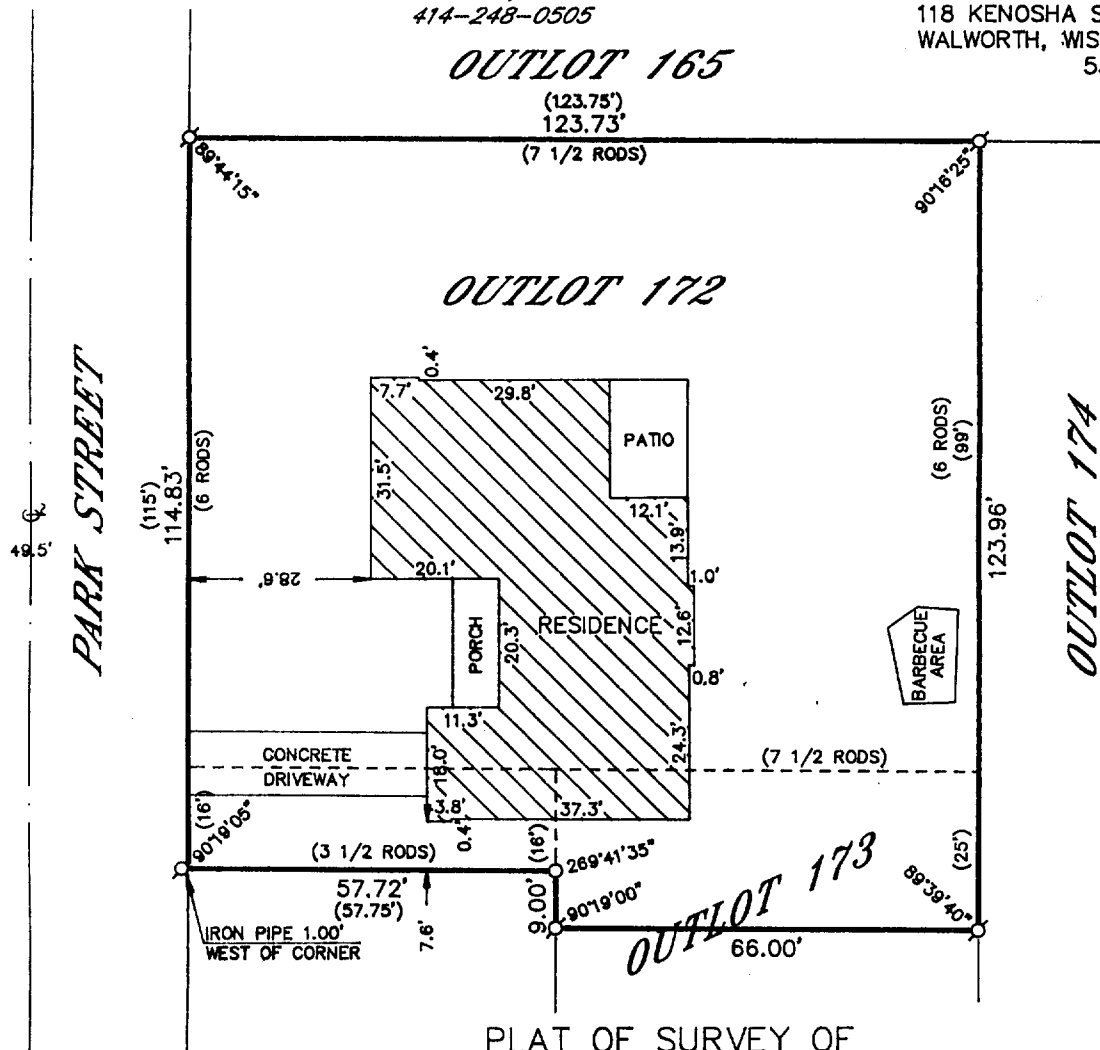

PLAT OF SURVEY OF

BEGINNING 34 1/2 RODS EAST AND 14 RODS N OF THE QUARTER POST BETWEEN SECTIONS 21 AND 22; THENCE RUNNING 6 RODS N, THENCE RUNNING 7 1/2 RODS E, THENCE RUNNING 6 RODS S, THENCE RUNNING 7 1/2 RODS W TO THE PLACE OF BEGINNING, ALL BEING IN SEC. 22, T 1 N, R 16 E, OF WALWORTH COUNTY, WISCONSIN.

ALSO: A PIECE OF REAL ESTATE DESCRIBED AS FOLLOWS, TO-WIT: A PART OF THE FOLLOWING DESCRIBED REAL ESTATE: BEGINNING 34 1/2 RODS E OF QUARTER POST BETWEEN SECTIONS 21 AND 22, THENCE RUNNING 14 RODS N, THENCE RUNNING 3 1/2 RODS E, THENCE RUNNING 14 RODS S, THENCE RUNNING 3 1/2 RODS W TO THE PLACE OF BEGINNING, ALL BEING IN SEC. 22, T 1 N, R 16 E, WHICH PORTION OF SAID REAL ESTATE SOLD AND CONVEYED BY THIS DEED IS DESCRIBED AS A RECTANGULAR PIECE OF REAL ESTATE LOCATED UPON THE N END OF THE REAL ESTATE HEREINBEFORE DESCRIBED WHICH IS BOUNDED ON THE S BY A LINE DRAWN PARALLEL TO THE N LINE OF THE REAL ESTATE HEREINBEFORE DESCRIBED AT A DISTANCE OF 16 FT FROM SAID N LINE AND ON THE N BY THE N LINE OF THE REAL ESTATE HEREINBEFORE DESCRIBED AND ON THE W BY THE W LINE OF THE REAL ESTATE HEREINBEFORE DESCRIBED AND ON THE E BY THE EAST LINE OF THE REAL ESTATE HEREINBEFORE DESCRIBED, SITUATED IN THE COUNTY OF WALWORTH AND STATE OF WISCONSIN.

ALSO: THE N 25 FT OF OUTLOT NO. 173, ASSESSOR'S PLAT OF THE VILLAGE OF WALWORTH, WALWORTH COUNTY, WISCONSIN.


I HEREBY CERTIFY THAT I HAVE SURVEYED THE ABOVE DESCRIBED PROPERTY AND THAT THE ABOVE MAP IS A TRUE REPRESENTATION THEREOF AND SHOWS THE SIZE AND LOCATION OF THE PROPERTY, ITS EXTERIOR BOUNDARIES, THE LOCATION OF ALL VISIBLE STRUCTURES AND DIMENSIONS OF ALL PRINCIPAL BUILDINGS THEREON, BOUNDARY FENCES, APPARENT EASEMENTS, ROADWAYS AND VISIBLE ENCROACHMENTS, IF ANY, TO THE BEST OF MY KNOWLEDGE AND BELIEF.

THIS SURVEY IS MADE FOR THE USE OF THE PRESENT OWNERS OF THE PROPERTY AND ALSO THOSE WHO PURCHASE, MORTGAGE OR GUARANTEE THE TITLE THERETO WITHIN ONE (1) YEAR FROM DATE HEREOF.

Robert M. Baerenwald
ROBERT M. BAERENWALD
WISCONSIN REGISTERED LAND SURVEYOR, S-1508

Oct. 3, 1997
DATE JOB NO. 5615

NOTE: THIS IS NOT A CERTIFIED COPY UNLESS SEALED.

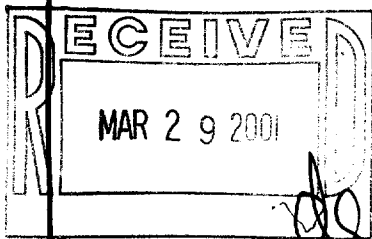

VWP-201

009-753