

HOGANSON & ROBERS, INC.
CONSULTING ENGINEERS & LAND SURVEYORS

PHONE (414) 763-2652


116 E. CHESTNUT ST.

BURLINGTON, WIS. 53105

**PLAT OF SURVEY
and
BUILDING LOCATION**
of

A parcel of land located in Outlots 118, 122, and 123 of the Assessors Plat of the Village of Walworth, Walworth County Wisconsin, described as follows, to wit: Beginning at the west line of said outlet 122 at a point located 156.05 feet north of the southwest corner of said outlet 122; thence north along the west line of said outlet 41.95 feet to the northwest corner of said outlet; thence continue northerly along the northerly extension of said west line 179.45 feet to the northerly line of said outlet 118; thence southeasterly along said northerly line 73.83 feet; thence southerly parallel with and 69.00 feet east of the aforementioned west line 195.75 feet to a point located 41.95 feet south of the north line of said outlet 123, thence westerly 69.00 feet to the place of beginning.

A perpetual easement is reserved for road right of way purposes for the use of grantors, their heirs and assigns over and along a strip of land 14.00 feet in width extending across the northerly end of the above described parcel and described as follows, to wit: Beginning at the northwest corner of the above described parcel of land, thence south along the west line of said land 14.99 feet; thence southeasterly parallel with the northerly line of said outlet 118, 73.83 feet; thence northerly parallel with the aforementioned west line 14.99 feet; thence northwesterly along the north line of said outlet 73.83 feet to the place of beginning.

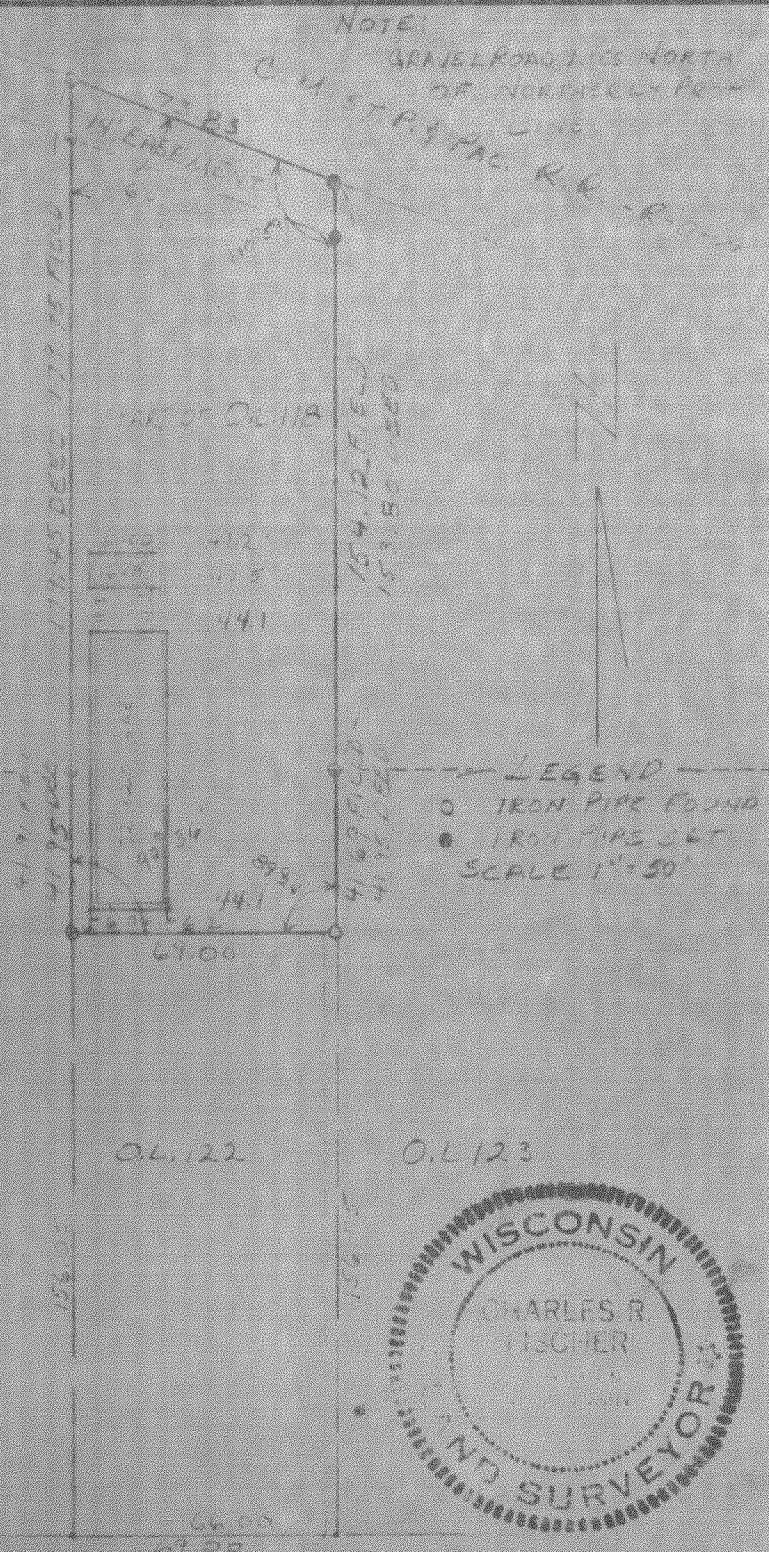

HARDY STR 44.5' WIDE

VWP 133A

I HEREBY CERTIFY THAT WE HAVE SURVEYED THE LANDS DESCRIBED ABOVE ACCORDING TO OFFICIAL RECORDS AND THAT THE PLAT DRAWN HEREON IS A CORRECT REPRESENTATION OF SAID SURVEY.

Charles R. Fischer
WIS. REG. LAND SURVEYOR 5821

DATE 5/6/70

JOB NO. 9-78
70046