

ROBERS & FISCHER, INC.
CONSULTING ENGINEERS & LAND SURVEYORS


PHONE (414) 763-2652

116 E. CHESTNUT ST.

BURLINGTON, WIS. 53105

Plat of Survey & Garage Location
of

The East 12.00 feet of the South 63.50 feet of the North 64.00 feet of
Lot 3, and the South 83.50 feet of the North 84.00 feet of Lot 4,
Colborns Subdivision, Village of Walworth, Walworth County, Wisconsin.

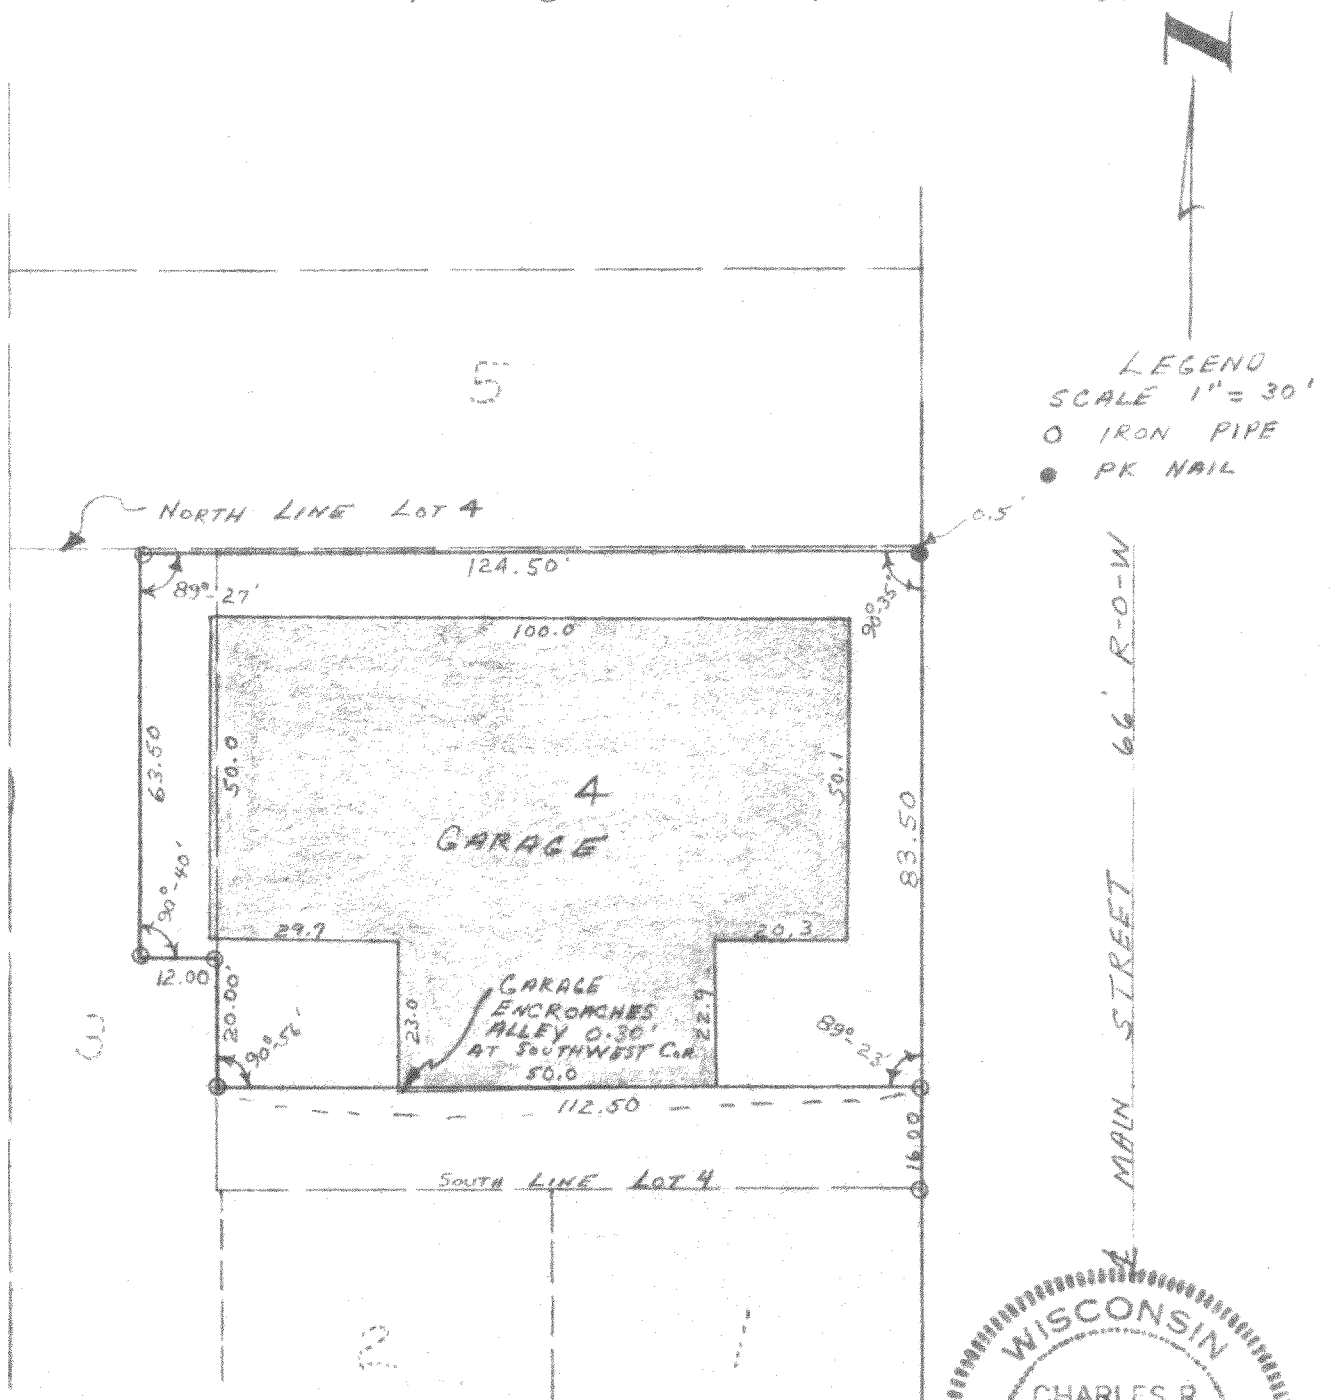

I HEREBY CERTIFY THAT WE HAVE SURVEYED THE LANDS DESCRIBED
ABOVE ACCORDING TO OFFICIAL RECORDS AND THAT THE PLAT
DRAWN HEREON IS A CORRECT REPRESENTATION OF SAID SURVEY.

Charles R. Fischer
WIS. REG. LAND SURVEYOR

DATE 12-24-70

JOB NO. 70-13

