


ABELL SURVEYING & MAPPING


1140 SEQUOIA STREET • DELAVAN, WISCONSIN 53115
262-728-6737

DEVILS LANE

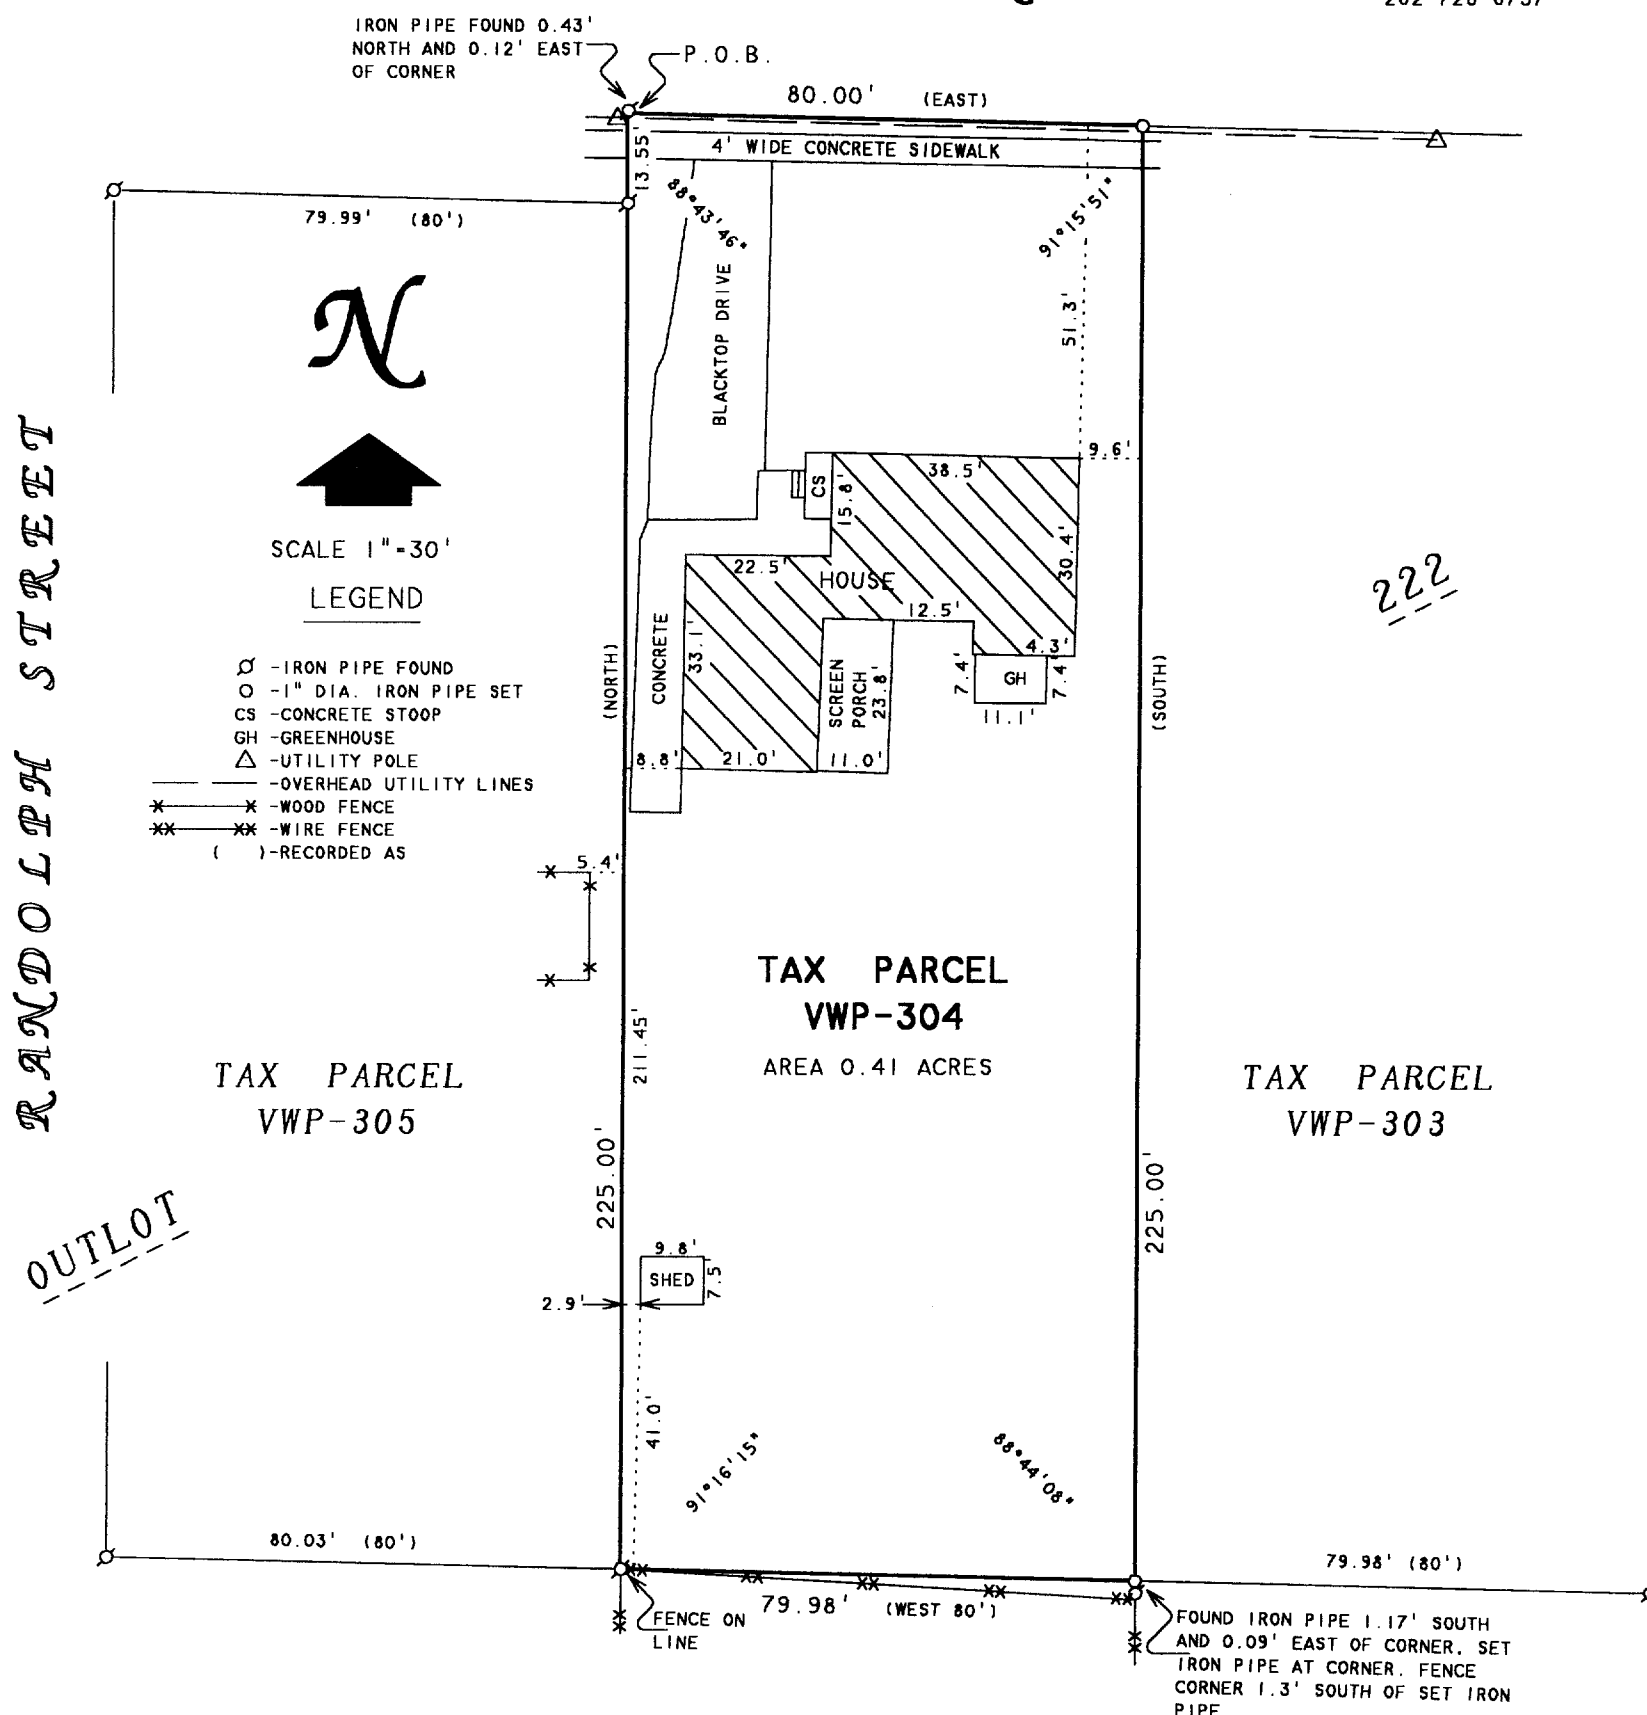

PLAT OF SURVEY OF

A PARCEL OF LAND LOCATED IN THE SW 1/4 OF THE SW 1/4 OF SECTION 22, T1N, R16E, VILLAGE OF WALWORTH, WALWORTH COUNTY, WISCONSIN AND DESCRIBED AS FOLLOWS:
COMMENCING AT THE NW CORNER OF SAID SW 1/4 OF THE SW 1/4 OF SECTION 22; THENCE SOUTH ALONG THE WEST LINE OF SAID SECTION, 33 FEET; THENCE EAST PARALLEL TO THE EAST/WEST 1/8 SECTION LINE IN SAID SW 1/4, 661 FEET TO THE PLACE OF BEGINNING; THENCE CONTINUE EAST ON SAME LINE 80 FEET; THENCE SOUTH PARALLEL TO THE WEST LINE OF SAID SECTION 22, A DISTANCE OF 225 FEET; THENCE WEST 80 FEET; THENCE NORTH 225 FEET TO THE PLACE OF BEGINNING.

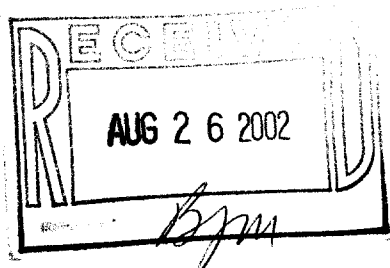

I HEREBY CERTIFY THAT I HAVE SURVEYED THE ABOVE DESCRIBED PROPERTY AND THAT THE ABOVE MAP IS A TRUE REPRESENTATION THEREOF AND SHOWS THE SIZE AND LOCATION OF THE PROPERTY, ITS EXTERIOR BOUNDARIES, THE LOCATION OF ALL VISIBLE STRUCTURES AND DIMENSIONS OF ALL PRINCIPAL BUILDINGS THEREON, BOUNDARY FENCES, APPARENT EASEMENTS, ROADWAYS AND VISIBLE ENCROACHMENTS, IF ANY, TO THE BEST OF MY KNOWLEDGE AND BELIEF.

THIS SURVEY IS MADE FOR THE USE OF THE PRESENT OWNERS OF THE PROPERTY, AND ALSO THOSE WHO PURCHASE, MORTGAGE, OR GUARANTEE THE TITLE THERETO WITHIN ONE (1) YEAR FROM DATE HEREON.

David F. Abell

DAVID F. ABELL
WISCONSIN REGISTERED LAND SURVEYOR, S-1596

ORDERED BY: RE/MAX GENEVA REALTY, LTD.
101 BROAD STREET
LAKE GENEVA, WI 53147

July 22, 2002

DATE: July 22, 2002 JOB NUMBER - 02107
NOTE: THIS IS NOT A CERTIFIED COPY UNLESS SEALED.

VWP 304

009-794