

FARRIS, HANSEN & ASSOC. INC.

7 RIDGWAY COURT- P.O. BOX 437
ELKHORN, WISCONSIN 53121
PHONE (262) 723-2098
FAX (262) 723-5886

PLAT OF SURVEY


LEGAL DESCRIPTION

OUTLOT 79, ASSESSOR'S PLAT, VILLAGE OF WALWORTH, WALWORTH COUNTY, WISCONSIN, ALSO A 33 FOOT PARCEL MEASURED EAST AND WEST LOCATED ADJACENT TO AND DIRECTLY WEST OF OUTLOT 79 IN THE VILLAGE OF WALWORTH, BEING MORE PARTICULARLY DESCRIBED AS FOLLOWS: BEGINNING AT THE SOUTHWEST CORNER OF SAID OUTLOT 79; THENCE WESTERLY ALONG THE NORTH LINE OF OUTLOT 78, A DISTANCE OF 33 FEET; THENCE NORTHERLY PARALLEL TO THE WEST LINE OF SOUTH MAIN STREET 78 FEET; THENCE EASTERLY IN A LINE PARALLEL TO THE SOUTH LINE OF OUTLOT 79, A DISTANCE OF 33 FEET TO THE NORTHWEST CORNER OF OUTLOT 79; THENCE SOUTHERLY ALONG THE WESTERLY LINE OF OUTLOT 79, 78 FEET TO THE PLACE OF BEGINNING.

ORDERED BY: THE RAULAND AGENCY
118 KENOSHA STREET
WALWORTH, WI. 53184

LEGEND
○ = FOUND IRON PIPE STAKE
● = FOUND IRON REBAR STAKE
(xxx) = RECORDED AS

ASSIGNED EAST LINE O.L. 79
S 00°39'58" W

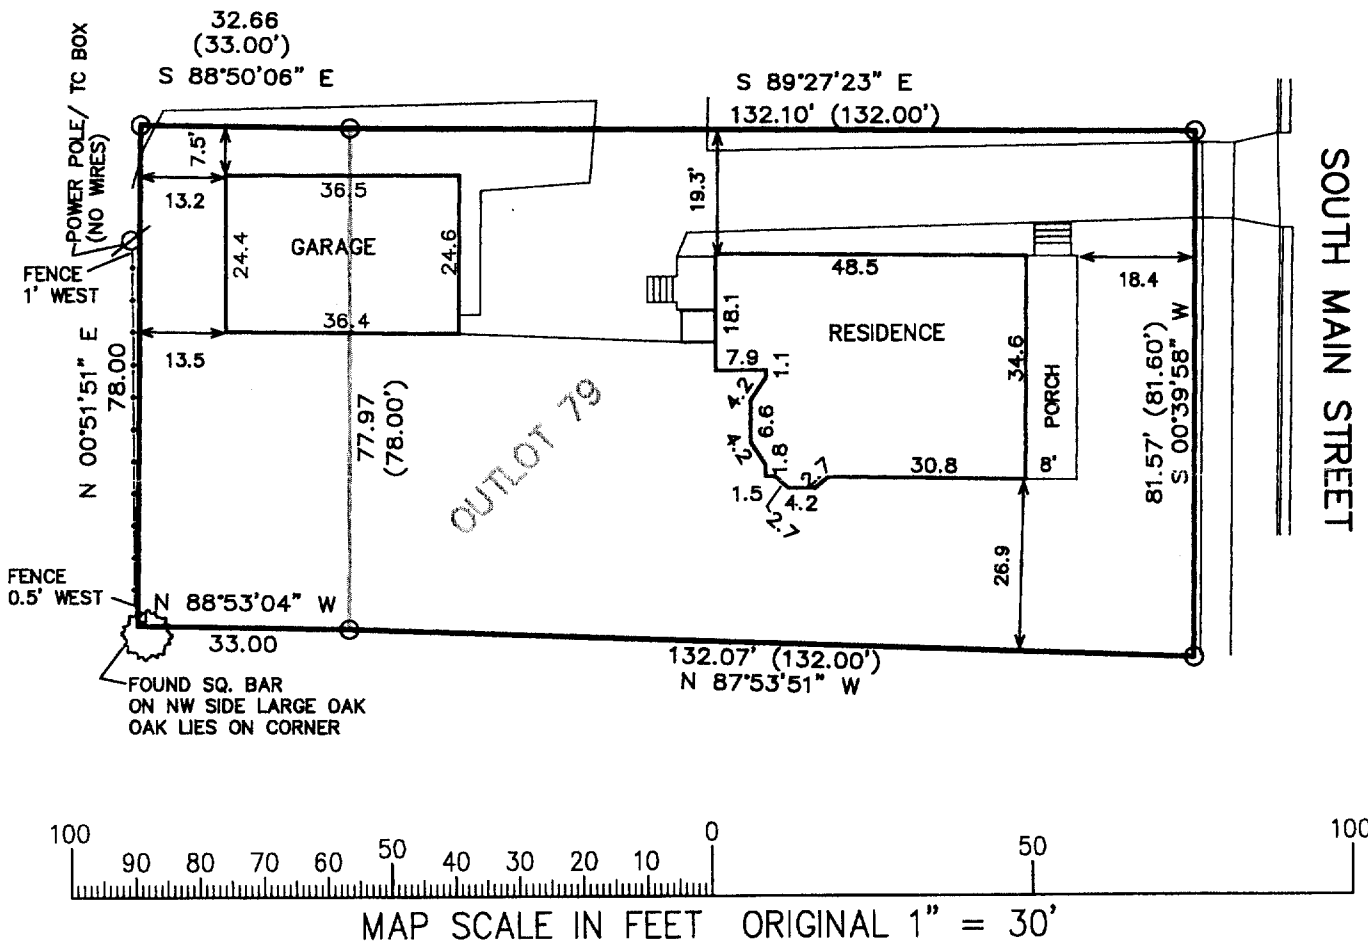

NOTE: COPIES OF THIS MAP TO WHICH THE FOLLOWING CERTIFICATE WILL APPLY SHOW SURVEYOR'S ORIGINAL SEAL AND SIGNATURE IN RED INK. COPIES BY ANY OTHER MEANS MAY HAVE ALTERATIONS WHICH DO NOT REPRESENT THE SURVEYOR'S WORK PRODUCT.

I HEREBY CERTIFY THAT THE ABOVE DESCRIBED PROPERTY HAS BEEN SURVEYED UNDER MY DIRECTION AND THAT THE ABOVE MAP IS A TRUE REPRESENTATION THEREOF AND SHOWS THE SIZE AND LOCATION OF THE PROPERTY, ITS EXTERIOR BOUNDARIES, THE LOCATION OF ALL VISIBLE STRUCTURES, AND DIMENSIONS OF ALL PRINCIPLE BUILDINGS THEREON, BOUNDARY FENCES, APPARENT EASEMENTS, ROADWAYS, AND VISIBLE ENCROACHMENTS, IF ANY. THIS SURVEY IS MADE FOR THE USE OF THE PRESENT OWNERS OF THE PROPERTY, AND ALSO THOSE WHO PURCHASE, MORTGAGE, OR GUARANTEE THE TITLE THERETO WITHIN ONE YEAR FROM THE DATE HEREOF.

DATED: DEC. 9, 2002

PETER S. GORDON R.L.S. 2101

PROJECT NO. 6176
DATED: 12-09-2002
SHEET 1 OF 1 SHEETS

JAN 3 2003

009-808