


# PLAT OF SURVEY

LOTS 1 THROUGH 5 OF BLOCK 8 OF EAST SIDE 2nd ADDITION  
AND THE SOUTHERLY 25' OF OUTLOT 217 OF ASSESSORS PLAT

LOCATED IN THE SOUTHWEST 1/4 OF SECTION 22, TOWN 1 NORTH, RANGE 16 EAST,  
VILLAGE OF WALWORTH, WALWORTH COUNTY, WISCONSIN

ASSIGNED WEST LINE OF 5th AVENUE  
S 00 00'00" E


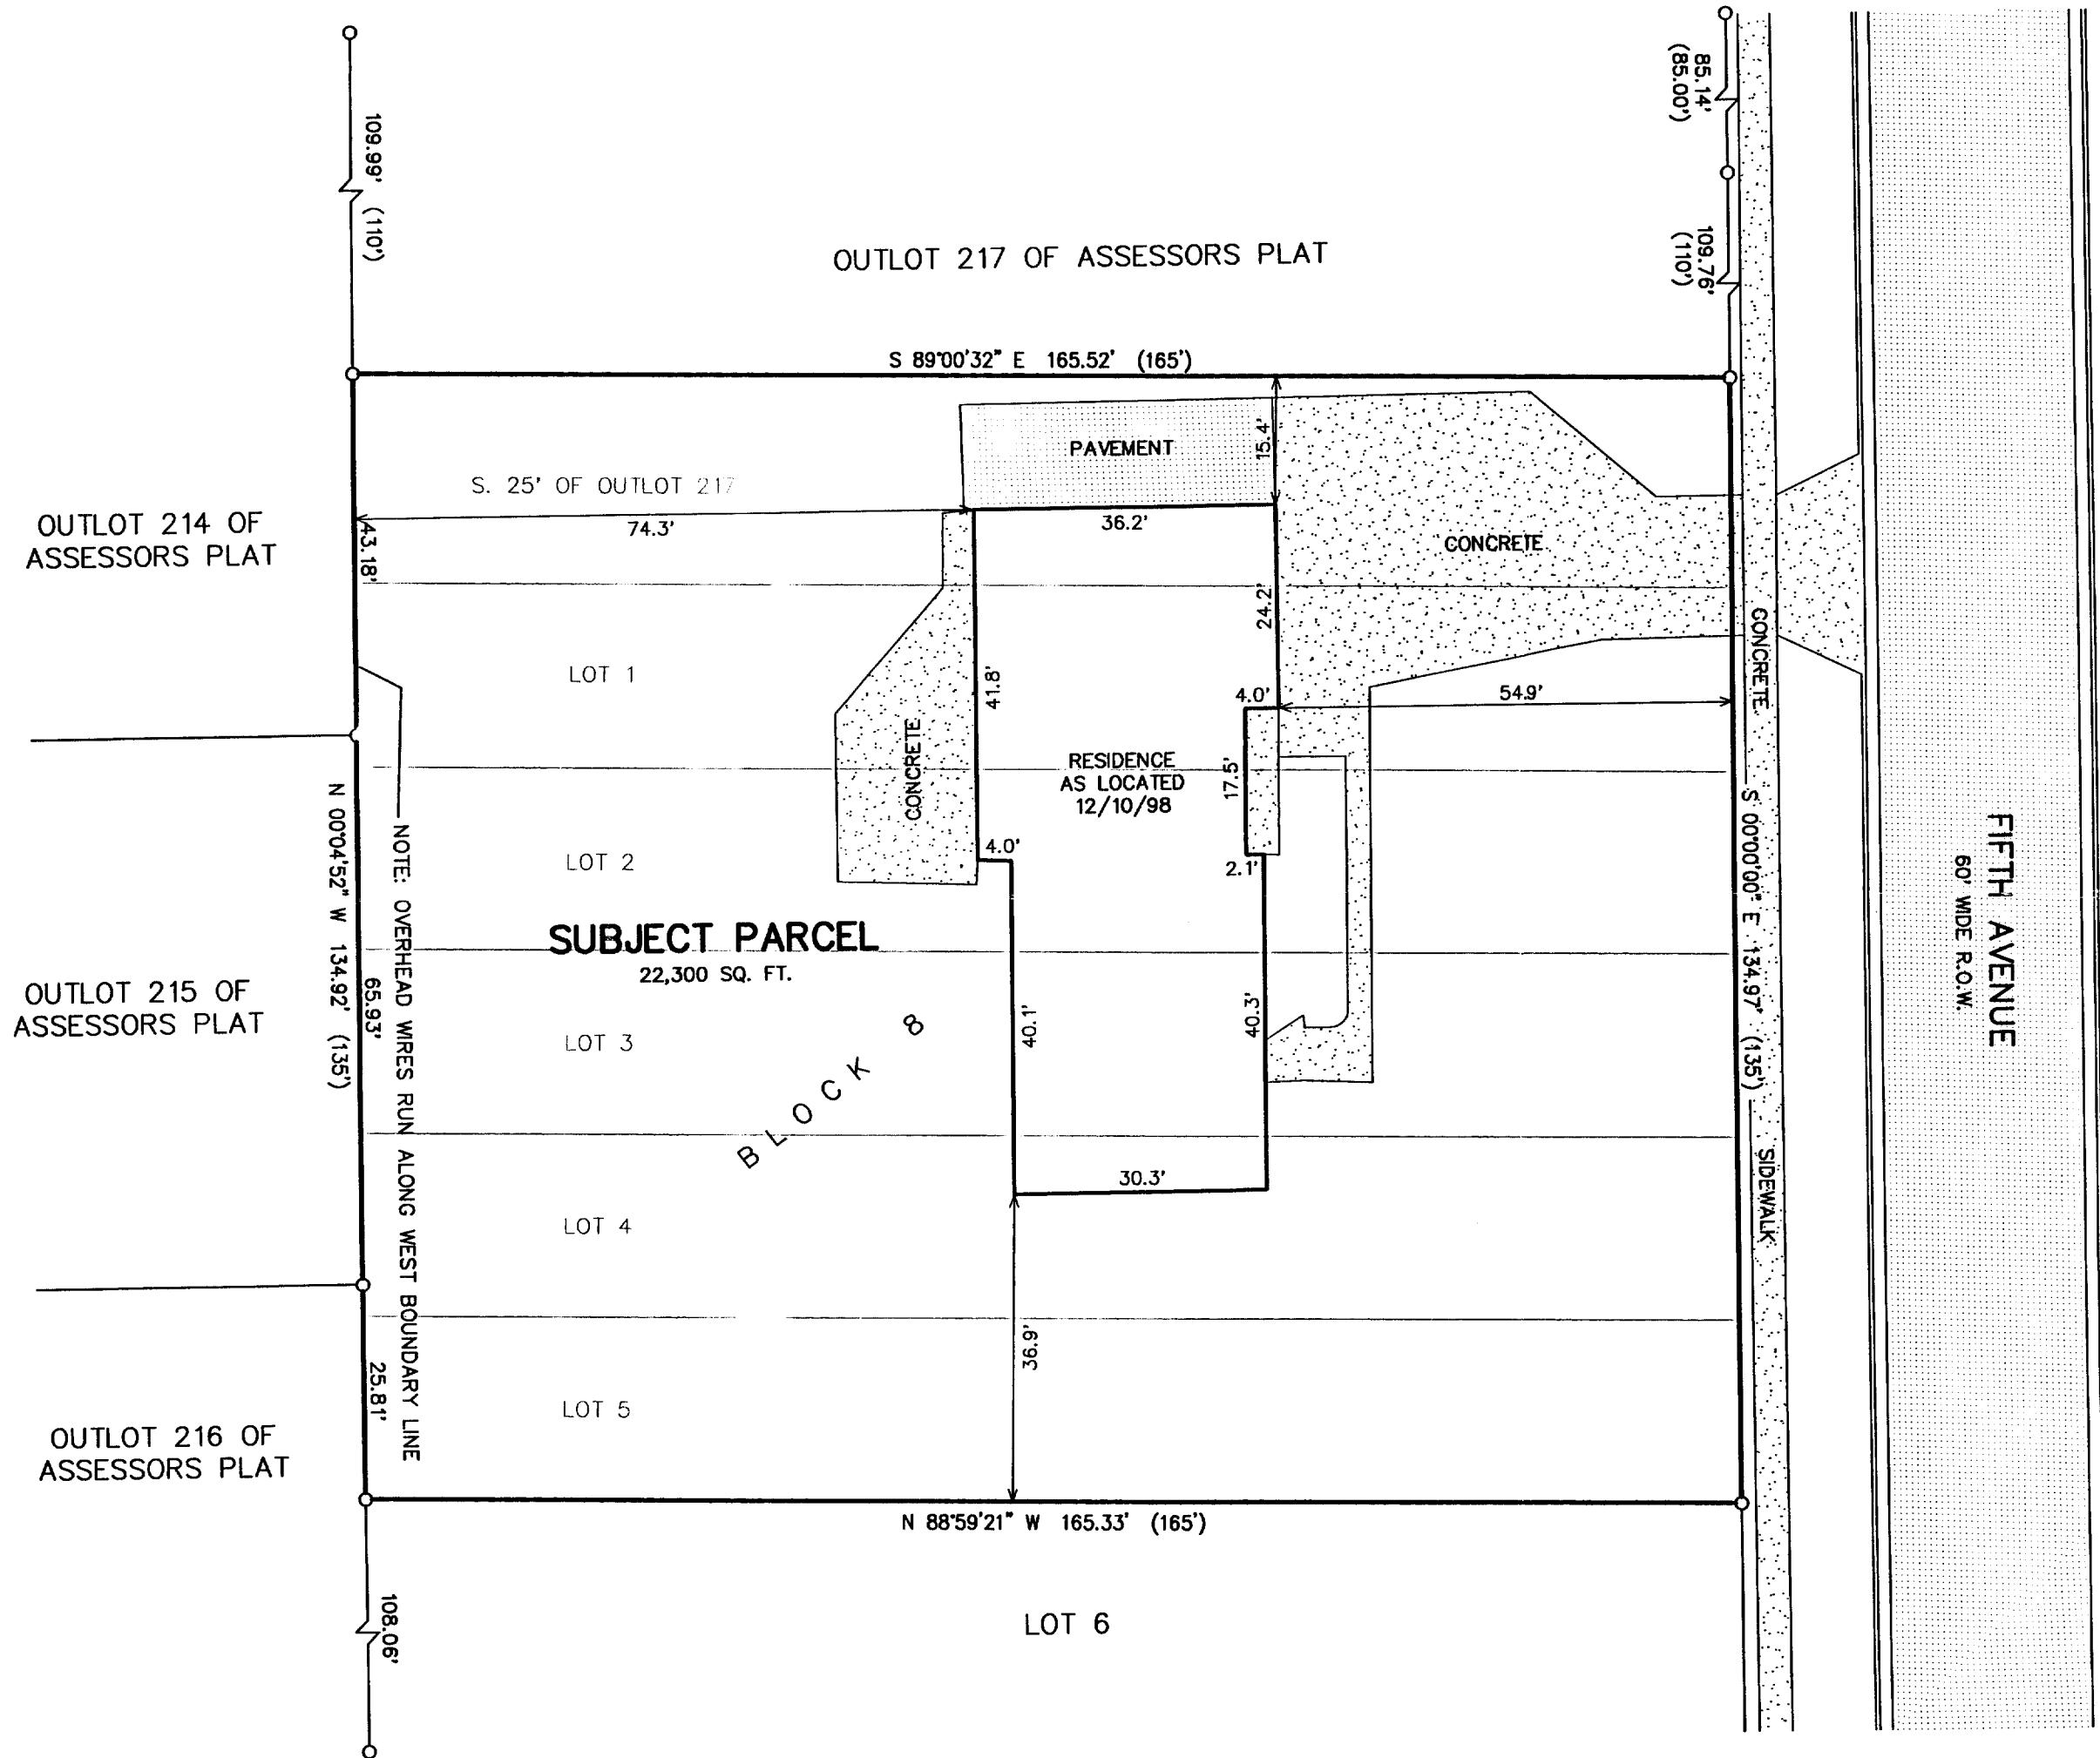


NOTE: COPIES OF THIS MAP TO WHICH THE FOLLOWING CERTIFICATE WILL APPLY SHOW SURVEYOR'S ORIGINAL SEAL AND SIGNATURE IN RED INK. COPIES BY ANY OTHER MEANS MAY HAVE ALTERATIONS WHICH DO NOT REPRESENT THE SURVEYOR'S WORK PRODUCT.

I HEREBY CERTIFY THAT THE ABOVE DESCRIBED PROPERTY HAS BEEN SURVEYED UNDER MY DIRECTION AND THAT THE ABOVE MAP IS A TRUE REPRESENTATION THEREOF AND SHOWS THE SIZE AND LOCATION OF THE PROPERTY, ITS EXTERIOR BOUNDARIES, THE LOCATION OF ALL VISIBLE STRUCTURES, AND DIMENSIONS OF ALL PRINCIPLE BUILDINGS THEREON, BOUNDARY FENCES, APPARENT EASEMENTS, ROADWAYS, AND VISIBLE ENCROACHMENTS, IF ANY. THIS SURVEY IS MADE FOR THE USE OF THE PRESENT OWNERS OF THE PROPERTY, AND ALSO THOSE WHO PURCHASE, MORTGAGE, OR GUARANTEE THE TITLE THERETO WITHIN ONE YEAR FROM THE DATE HEREOF.

DATED: DEC. 5, 200

PETER S. GORDON R.L.S. 2101

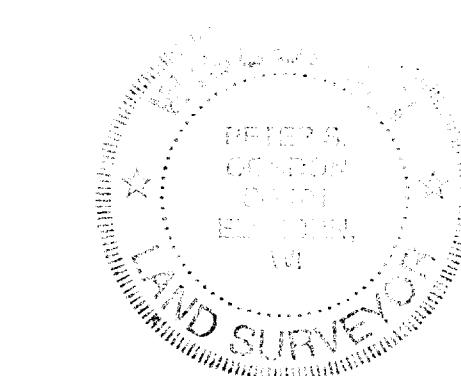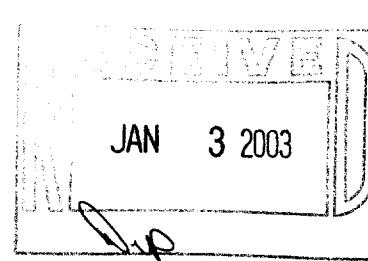

44-52-16  
W.M. 2-2

6H

# LAT OF SURVEY VILLAGE OF WALWORTH WALWORTH COUNTY, WISCONSIN

WALWORTH COUNTY, WISCONSIN

- PREPARED FOR -  
CHRIS SEVERT  
P.O. BOX 122  
WALWORTH, WISCONSIN  
53184

Engineering, Architecture, Surveying  
Ridgway Court P.O. Box 437  
ELKHORN, WISCONSIN 53121  
Office: (414) 723-2098  
Fax: (414) 723-5886

## REVIEWS

PROJECT NO  
E17E

DATE:  
12/14/98

SHEET NO.

009-815