


ABELL
SURVEYING & MAPPING

1140 SEQUOIA STREET • DELAVAN, WISCONSIN 53115
262-728-6737

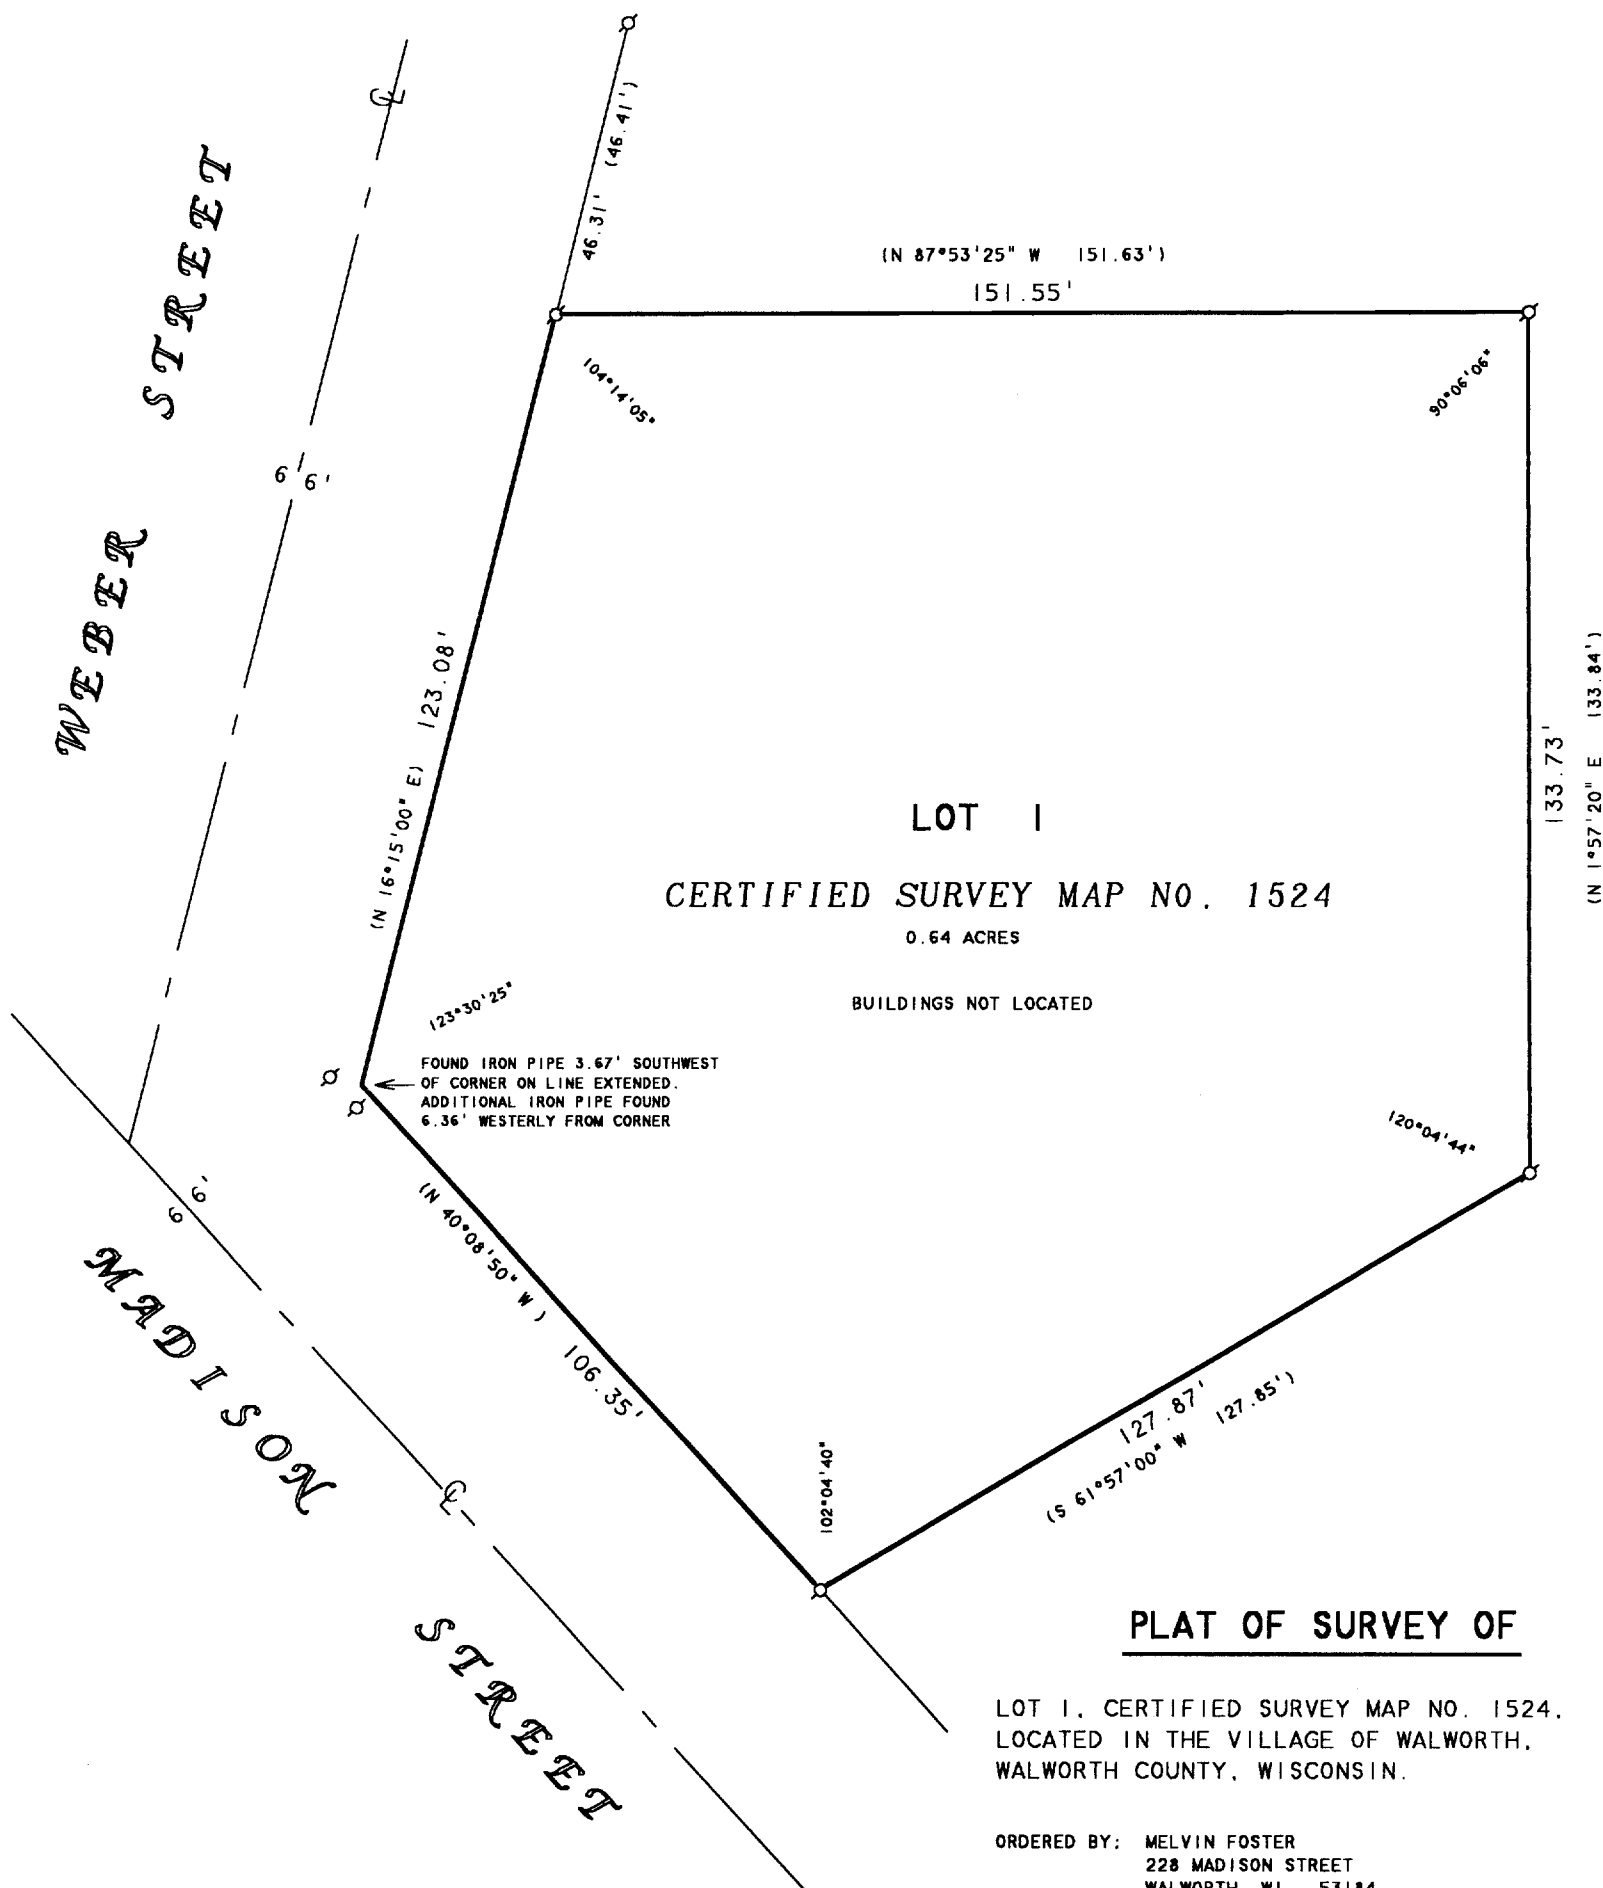


PLAT OF SURVEY OF

LOT 1, CERTIFIED SURVEY MAP NO. 1524,
LOCATED IN THE VILLAGE OF WALWORTH,
WALWORTH COUNTY, WISCONSIN.

ORDERED BY: MELVIN FOSTER
228 MADISON STREET
WALWORTH, WI 53184

NOTE: THIS PLAT REPRESENTS A BOUNDARY
SURVEY ONLY AT THE DIRECTION OF:
MELVIN FOSTER.

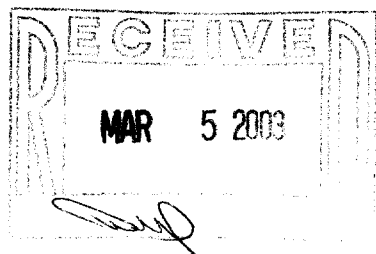

N



SCALE 1"=30'

LEGEND

Ø - IRON PIPE FOUND
() - RECORDED AS

I, DAVID F. ABELL, DO HEREBY CERTIFY THAT I HAVE SURVEYED THE PROPERTY HEREON DESCRIBED ACCORDING TO THE OFFICIAL RECORDS AND THAT THE PLAT HEREON IS A CORRECT REPRESENTATION OF THE PROPERTY LINES TO THE BEST OF MY KNOWLEDGE AND BELIEF.

David F. Abell

DAVID F. ABELL
WISCONSIN REGISTERED LAND SURVEYOR, S-1596

August 7, 2002

DATE: _____ JOB NUMBER - 02111
NOTE: THIS IS NOT A CERTIFIED COPY UNLESS SEALED.

YA1524-1

009-817