


DUNHAM SURVEYING, S. C.
SURVEYING & SUBDIVIDING
DELAVER, WISCONSIN 53115

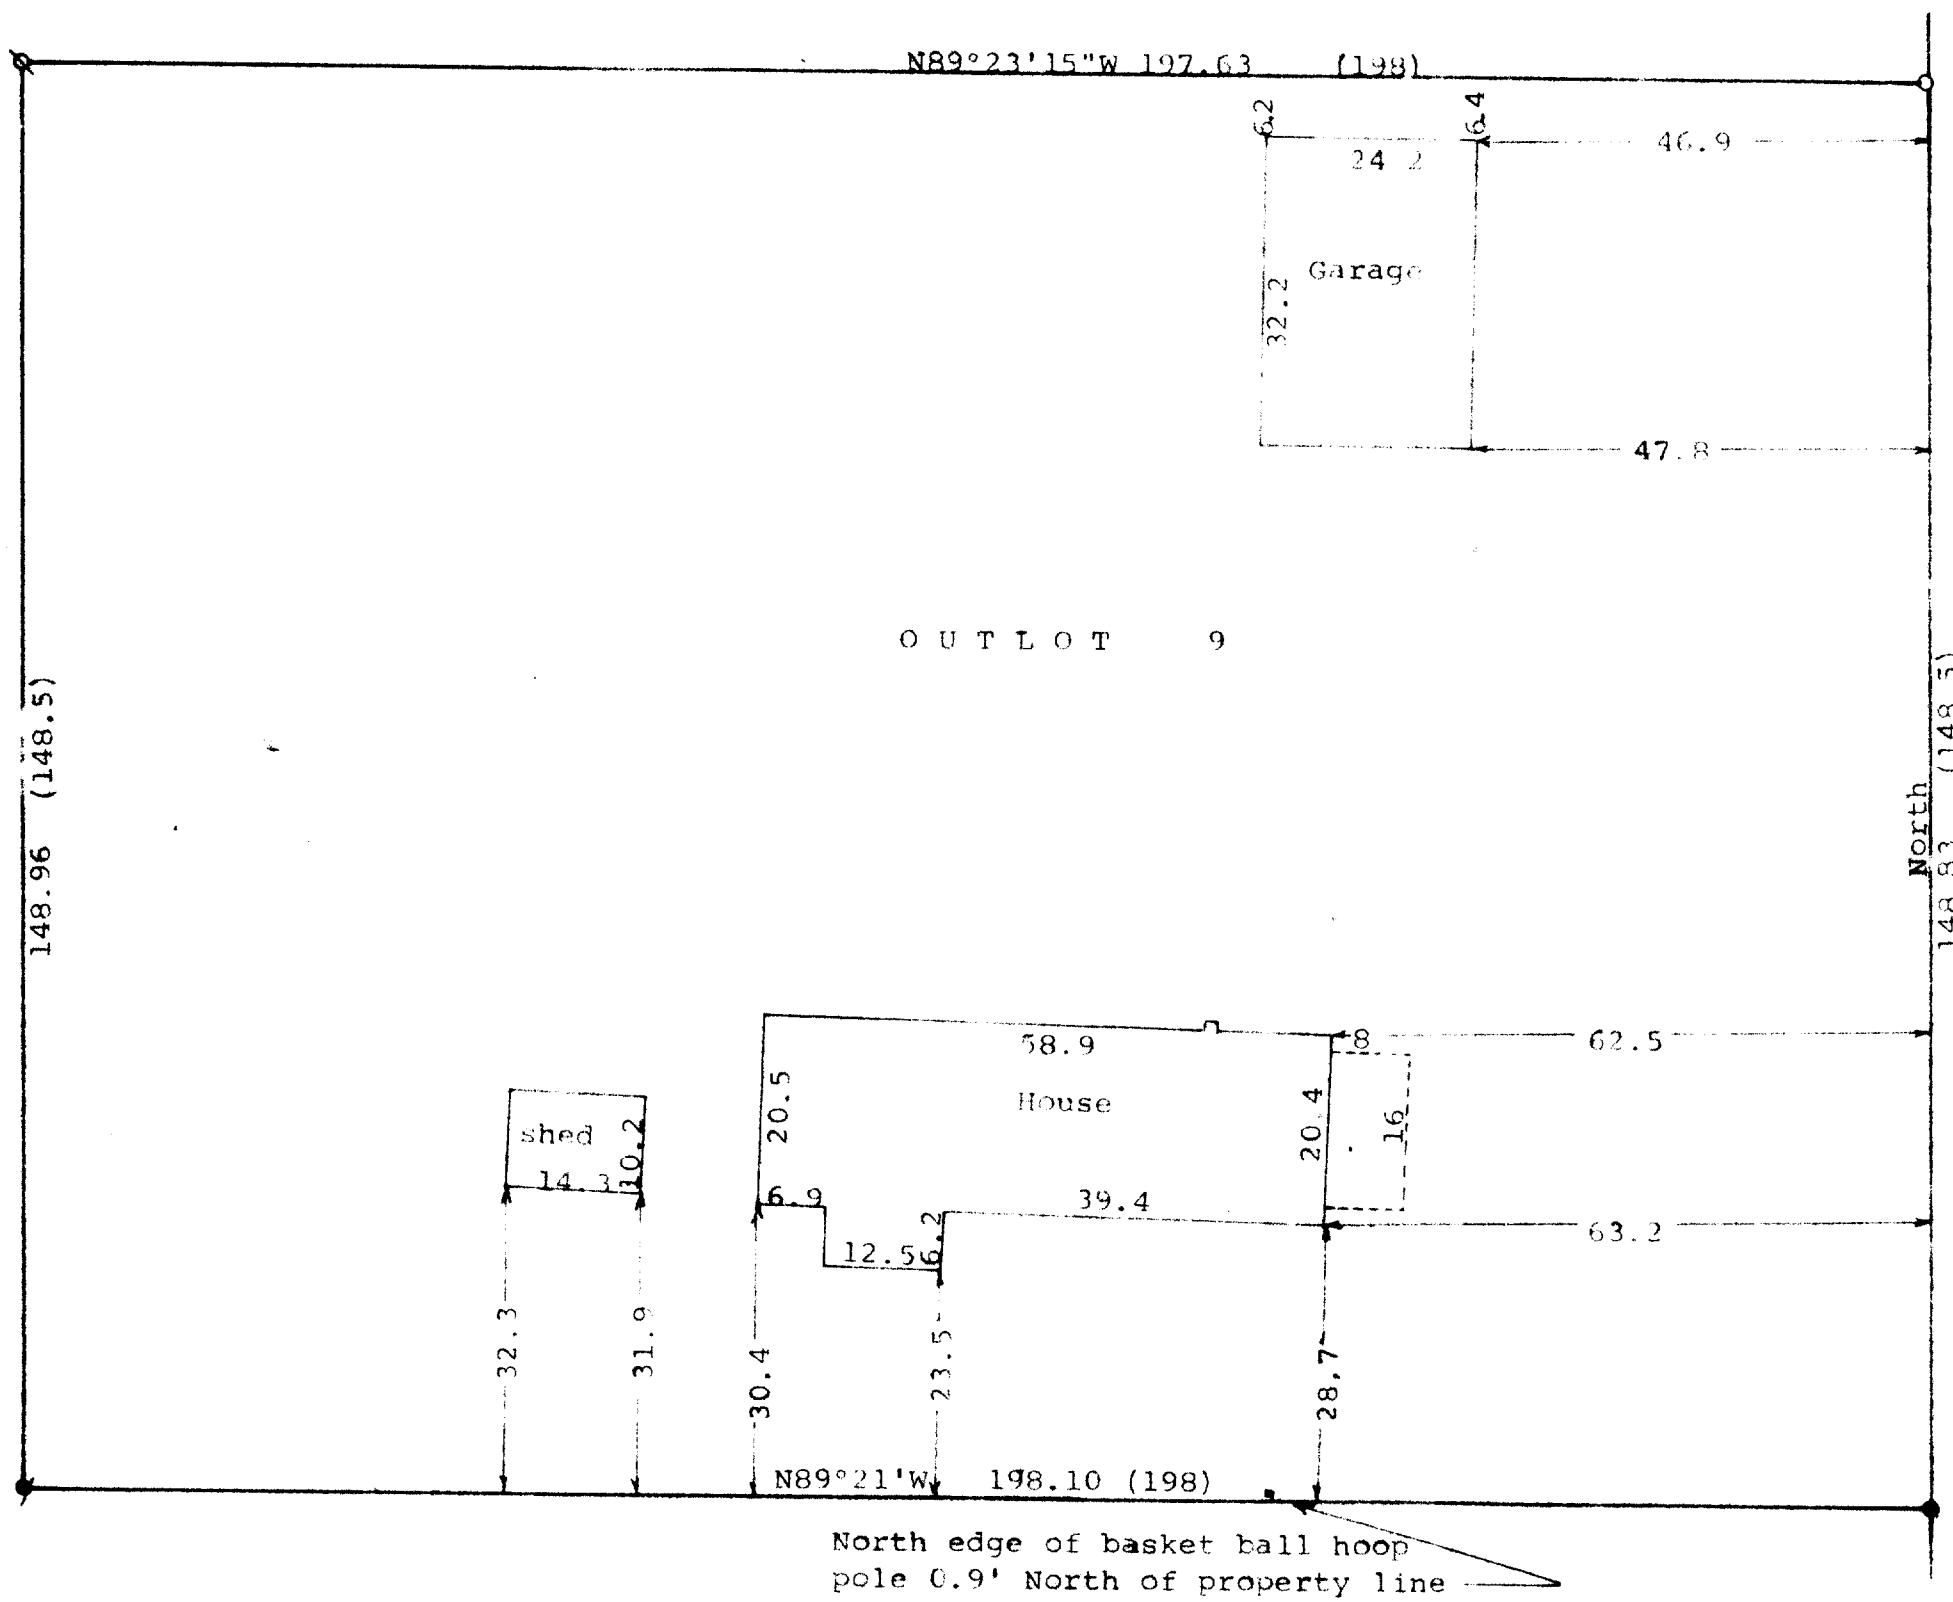

STREET

N

Scale - 1" = 20'
 * = Iron Bolt Found
 • = Iron Rod Found
 O = 1" Iron Pipe Found
 Q = 3/4" Iron Pipe Found
 Survey ordered by:
 Churchill Real Estate
 Walworth, WI 53184

STATE OF WISCONSIN)
 COUNTY OF WALWORTH) SS

I, George T. Dunham, Surveyor, certify that I have surveyed the property described as follows:

Outlot 9, Assessor's Plat, Village of Walworth, Walworth County, Wisconsin

and that the plat shown hereon is a correct representation thereof and shows the size and location of the property, its exterior boundaries, the location of all visible structures and dimensions of all principal buildings thereon, boundary fences, apparent easements, roadways and visible encroachments, if any, and that I have surveyed the property hereon described, according to the official records to the best of my knowledge and belief.
 April 13, 1999

George T. Dunham
 George T. Dunham, Surveyor

