



HAROLD N. KOLB
REGISTERED PROFESSIONAL LAND SURVEYOR
LAKE GENEVA, WISCONSIN

ADELINE STREET

NORTH ELM STREET

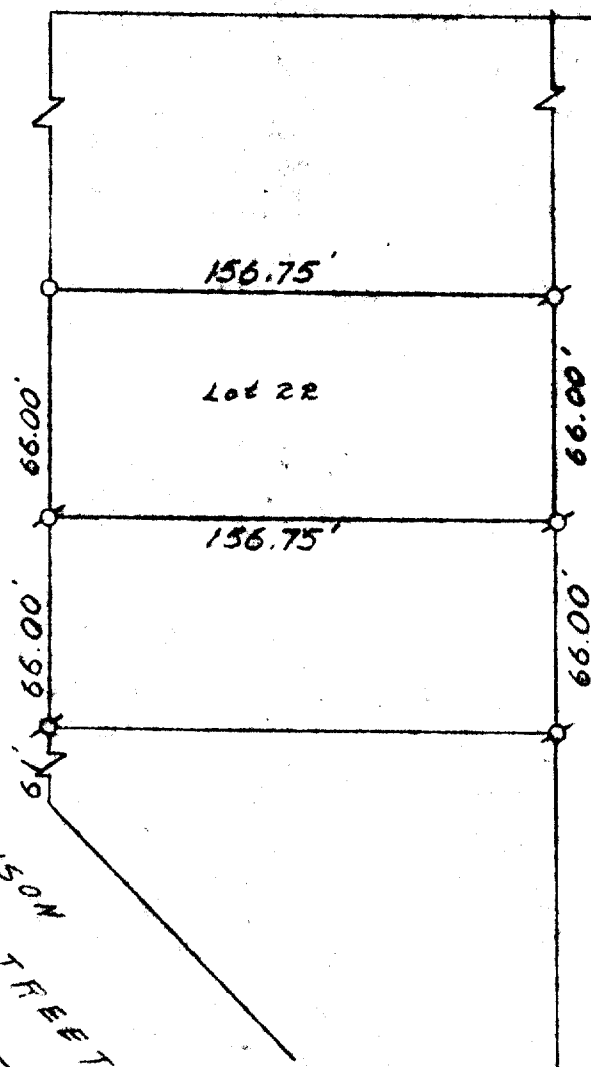

BLOCK 1

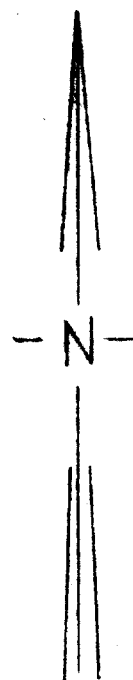

SCALE: 1" = 60'

WEBER STREET

MADISON STREET

PLAT OF SURVEY OF

Lot 22, Block 1, Crandall and Swinney's Subdivision, located
in the Village of Walworth, Walworth County, Wisconsin.

Harold N. Kolb

Harold N. Kolb, Wisconsin Surveyor, S-187
DATE: June 20, 1964

6 Iron Pipe Found
0 Iron Pipe Placed

VC-23

9-87