


HAROLD H. KOLB
REGISTERED PROFESSIONAL LAND SURVEYOR
LAKE GENEVA, WISCONSIN

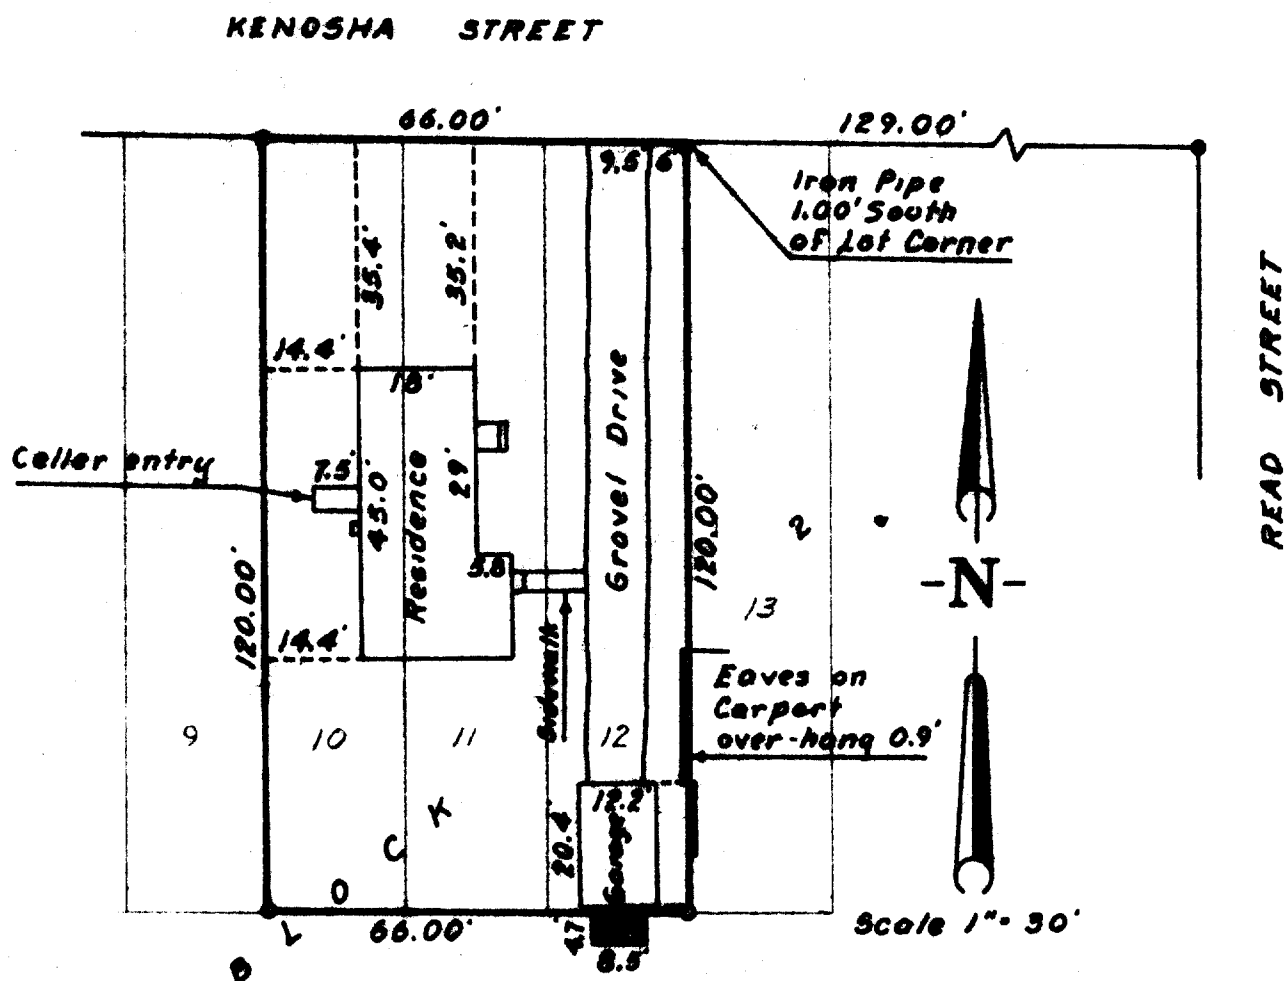

PLAT OF SURVEY OF

Lots 10, 11 and 12, Block 2, East Side Addition to the Village
of Walworth, Walworth County, Wisconsin

State of Wisconsin)
County of Walworth) SS

I, Harold H. Kolb, do hereby certify that I have surveyed
the property hereon described according to the official records,
and that the plat hereon is a correct representation of the lot
lines and the principal lines of the buildings thereon.

Date- 4-25-89

Harold H. Kolb

Harold H. Kolb, Wisconsin Surveyor, S-187

- - Conc. Monument
- - Iron Pipe

VES-14

9-89