


FARRIS, HANSEN & ASSOC. INC.

7 RIDGWAY COURT- P.O. BOX 437
ELKHORN, WISCONSIN 53121
PHONE (262) 723-2098
FAX (262) 723-5886

ORDERED BY: CUSTOM CONSTRUCTION & DEVELOPMENT
PO BOX 1143
WILLIAMS BAY, WI. 53191

NOV 4 2004

PLAT OF SURVEY

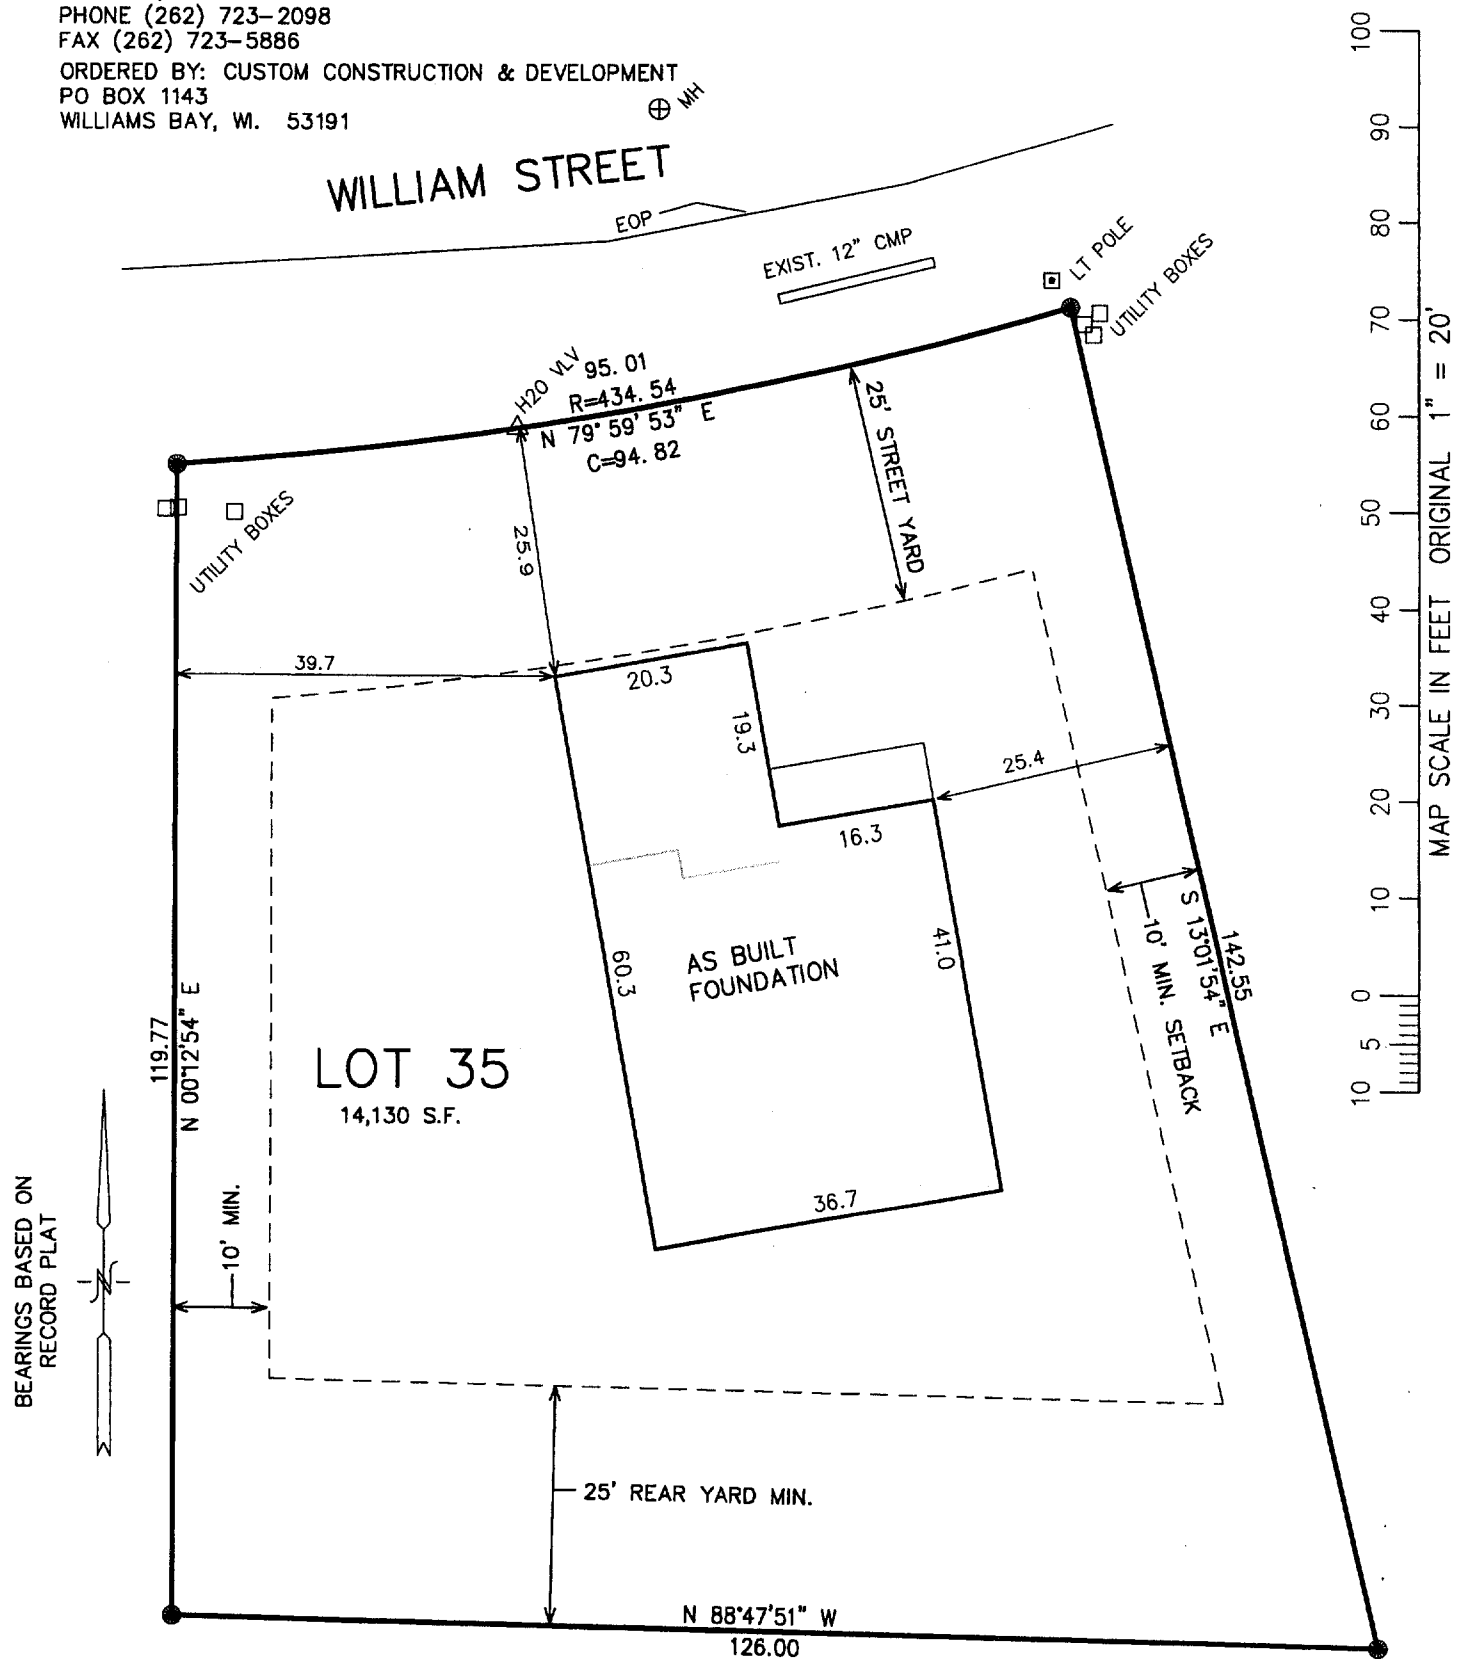

LEGAL DESCRIPTION

LOT 35 OF OAK KNOLLS OF WALWORTH ADDITION 1, BEING PART OF THE SE 1/4 OF THE SE 1/4 OF SEC. 22, TOWN 1 NORTH, RANGE 16 EAST, VILLAGE OF WALWORTH, WALWORTH COUNTY, WI.

LEGEND

● = FOUND IRON REBAR STAKE

NOTE: COPIES OF THIS MAP TO WHICH THE FOLLOWING CERTIFICATE WILL APPLY SHOW SURVEYOR'S ORIGINAL SEAL AND SIGNATURE IN RED INK. COPIES BY ANY OTHER MEANS MAY HAVE ALTERATIONS WHICH DO NOT REPRESENT THE SURVEYOR'S WORK PRODUCT.

I HEREBY CERTIFY THAT THE ABOVE DESCRIBED PROPERTY HAS BEEN SURVEYED UNDER MY DIRECTION AND THAT THE ABOVE MAP IS A TRUE REPRESENTATION THEREOF AND SHOWS THE SIZE AND LOCATION OF THE PROPERTY AND ITS EXTERIOR BOUNDARIES. THIS SURVEY IS MADE FOR THE USE OF THE PRESENT OWNERS OF THE PROPERTY, AND ALSO THOSE WHO PURCHASE, MORTGAGE, OR GUARANTEE THE TITLE THERETO WITHIN ONE YEAR FROM THE DATE HEREOF.

REVISED 10-04-04
TO SHOW SIZE &

DATED: AUGUST 4, 2004

LOCATION OF
AS BUILT FOUNDATION

PROJECT NO. 6620
DATED: 08-04-2004
SHEET 1 OF 1 SHEETS

PETER S. GORDON R.L.S. 2101

VOR1 00008

009-943