

LAND-MARK SURVEYING

Mark L. Miritz

Wisconsin Registered Land Surveyor S-2582



N9330 Knuteson Drive
Whitewater, WI 53190
Phone: (262) 495-3284
FAX: (262) 495-8421
LAND-MARKSURVEYING.COM

PLAT OF SURVEY


**LOT 14 OF BLOCK 1 OF CRANDALL'S AND
SWINNEY'S SUBDIVISION LOCATED IN
SECTION 21, TOWN 1 NORTH, RANGE 16
EAST, VILLAGE OF WALWORTH, WALWORTH
COUNTY, WISCONSIN.**

ORDERED BY: KEEFE REALTY
SALLY PRIO
P.O. BOX 460
LAKE GENEVA, WI. 53147

OWNER: PHILIP L. ZIMMERMAN
127 WEBER ST.
WALWORTH, WI. 53184

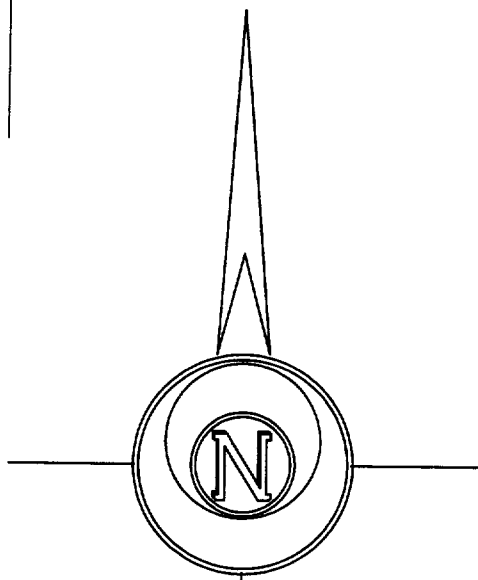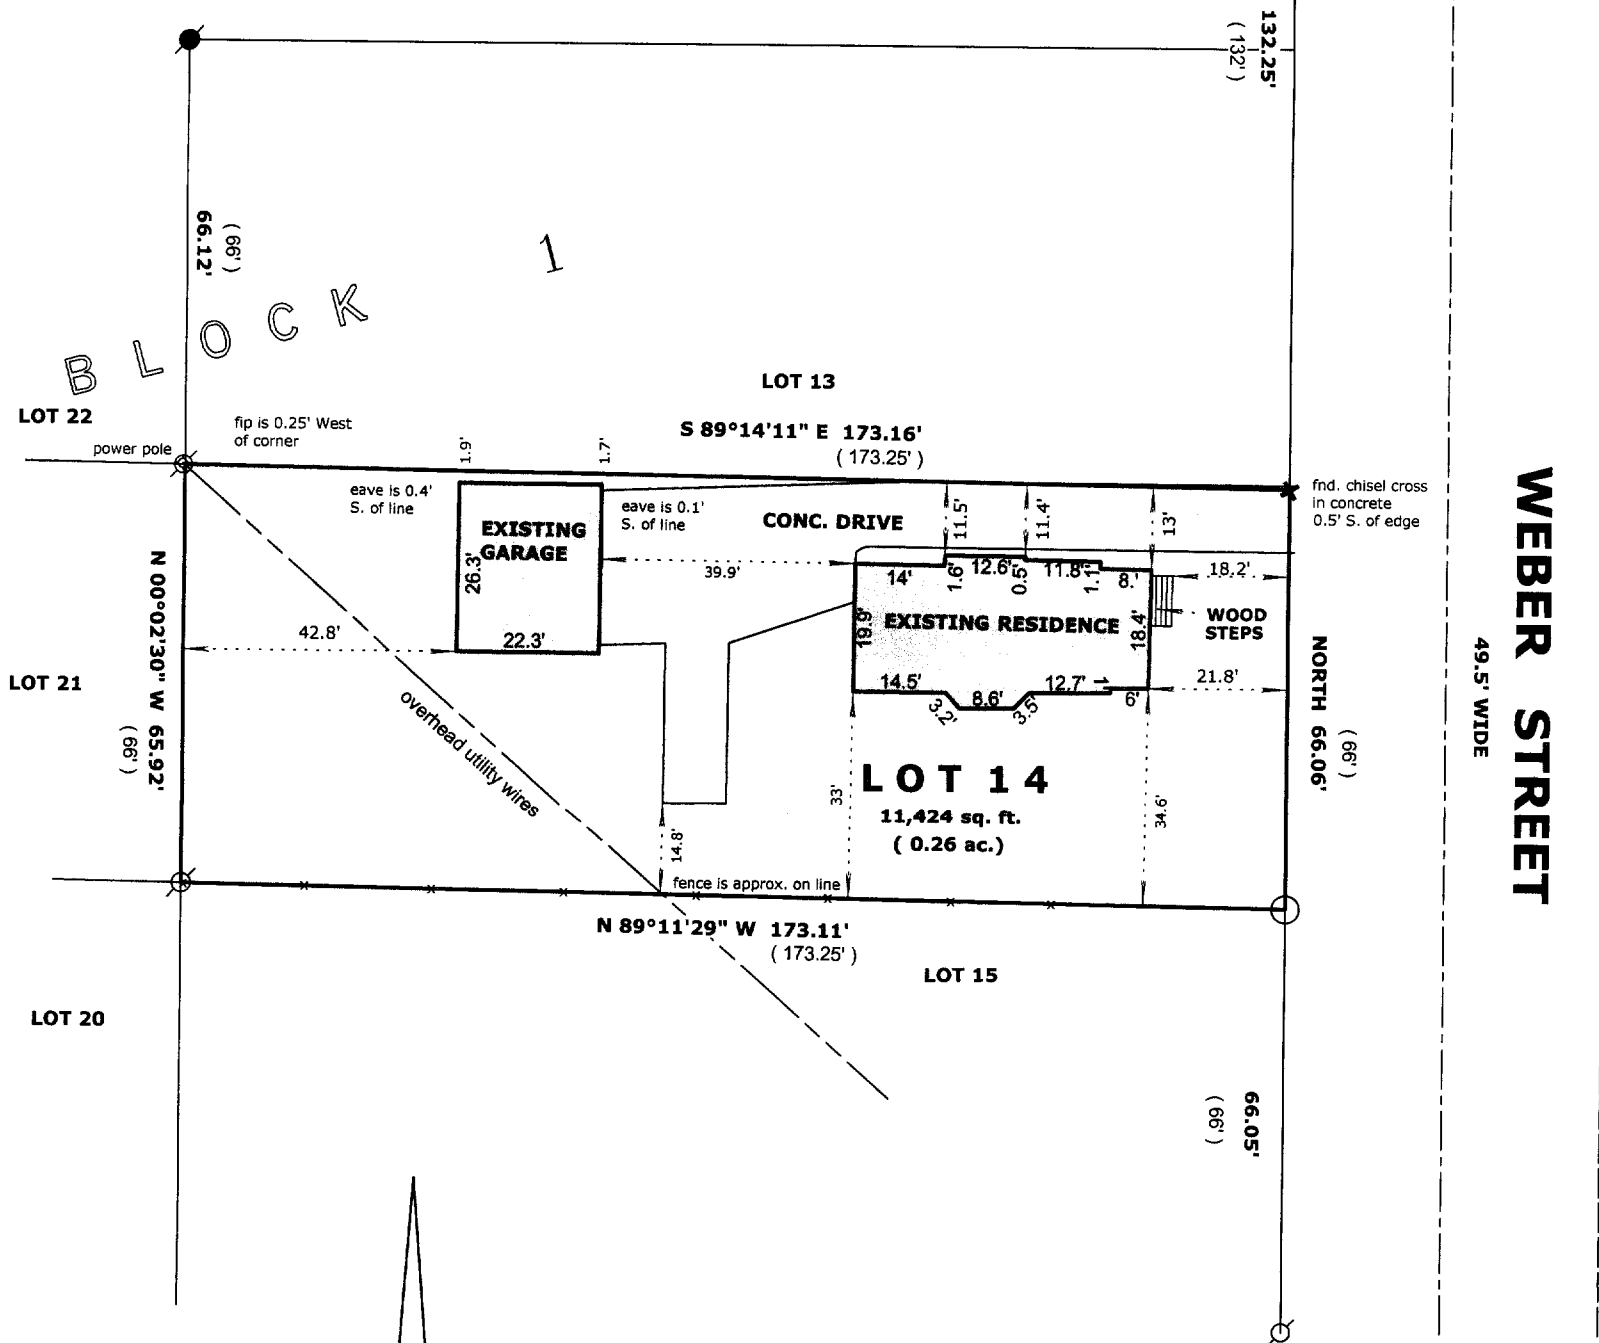

THE WEST LINE OF WEBER ST.
WAS ASSUMED TO BEAR NORTH

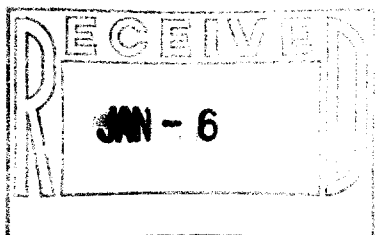

LEGEND

- FOUND IRON PIPE
- FOUND IRON ROD
- FOUND COUNTY MONUMENT
- FOUND CONCRETE MONUMENT
- CHISEL CUT IN CONCRETE
- SET IRON PIPE, 24" LONG, WEIGHING 1.13 LBS./LINEAL FT., 1" DIA.
- RECORDED AS DIMENSION
- EXISTING FENCE

SCALE: 1" = 30 FEET

"I hereby certify that the above described property has been surveyed by me or under my direction and that the above map is a true representation thereof and shows the size and location of the property, its exterior boundaries, the location of all visible structures and dimensions of all principal buildings thereon, boundary fences, apparent easements, roadways and visible encroachments, if any."

"This survey is made for the use of the present owners of the property, and also those who purchase, mortgage, or guarantee the title thereto within one year from date hereof."

Mark L. Miritz
MARK L. MIRITZ
WISCONSIN REGISTERED
LAND SURVEYOR S-2582

DATE: OCT. 21, 2004 JOB NO. 04.1014

VCS-14

009-953