



Mark L. Miritz

**N9330 Knuteson Drive
Whitewater, WI 53190
Phone: (262) 495-3284
FAX : (262) 495-8421
LAND-MARKSURVEYING.COM**

**LOT 2 OF SUHR'S SUBDIVISION, LOCATED IN THE
SW 1/4 OF SECTION 22, AND THE NW 1/4 OF
SECTION 27, T 1 N, R 16 E., VILLAGE OF WALWORTH,
WALWORTH COUNTY, WISCONSIN.**

**ORDERED BY: THE RAULAND AGENCY
P.O. BOX 159
WALWORTH, WI. 53184
ATTN: SHARI RAULAND MOHR**

**OWNER: JOHN AND VERONICA A. HOGUE
130 PLAFIELD CT.
WALWORTH, WI. 53184**

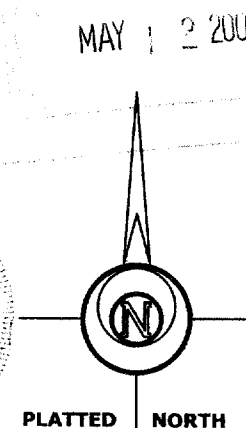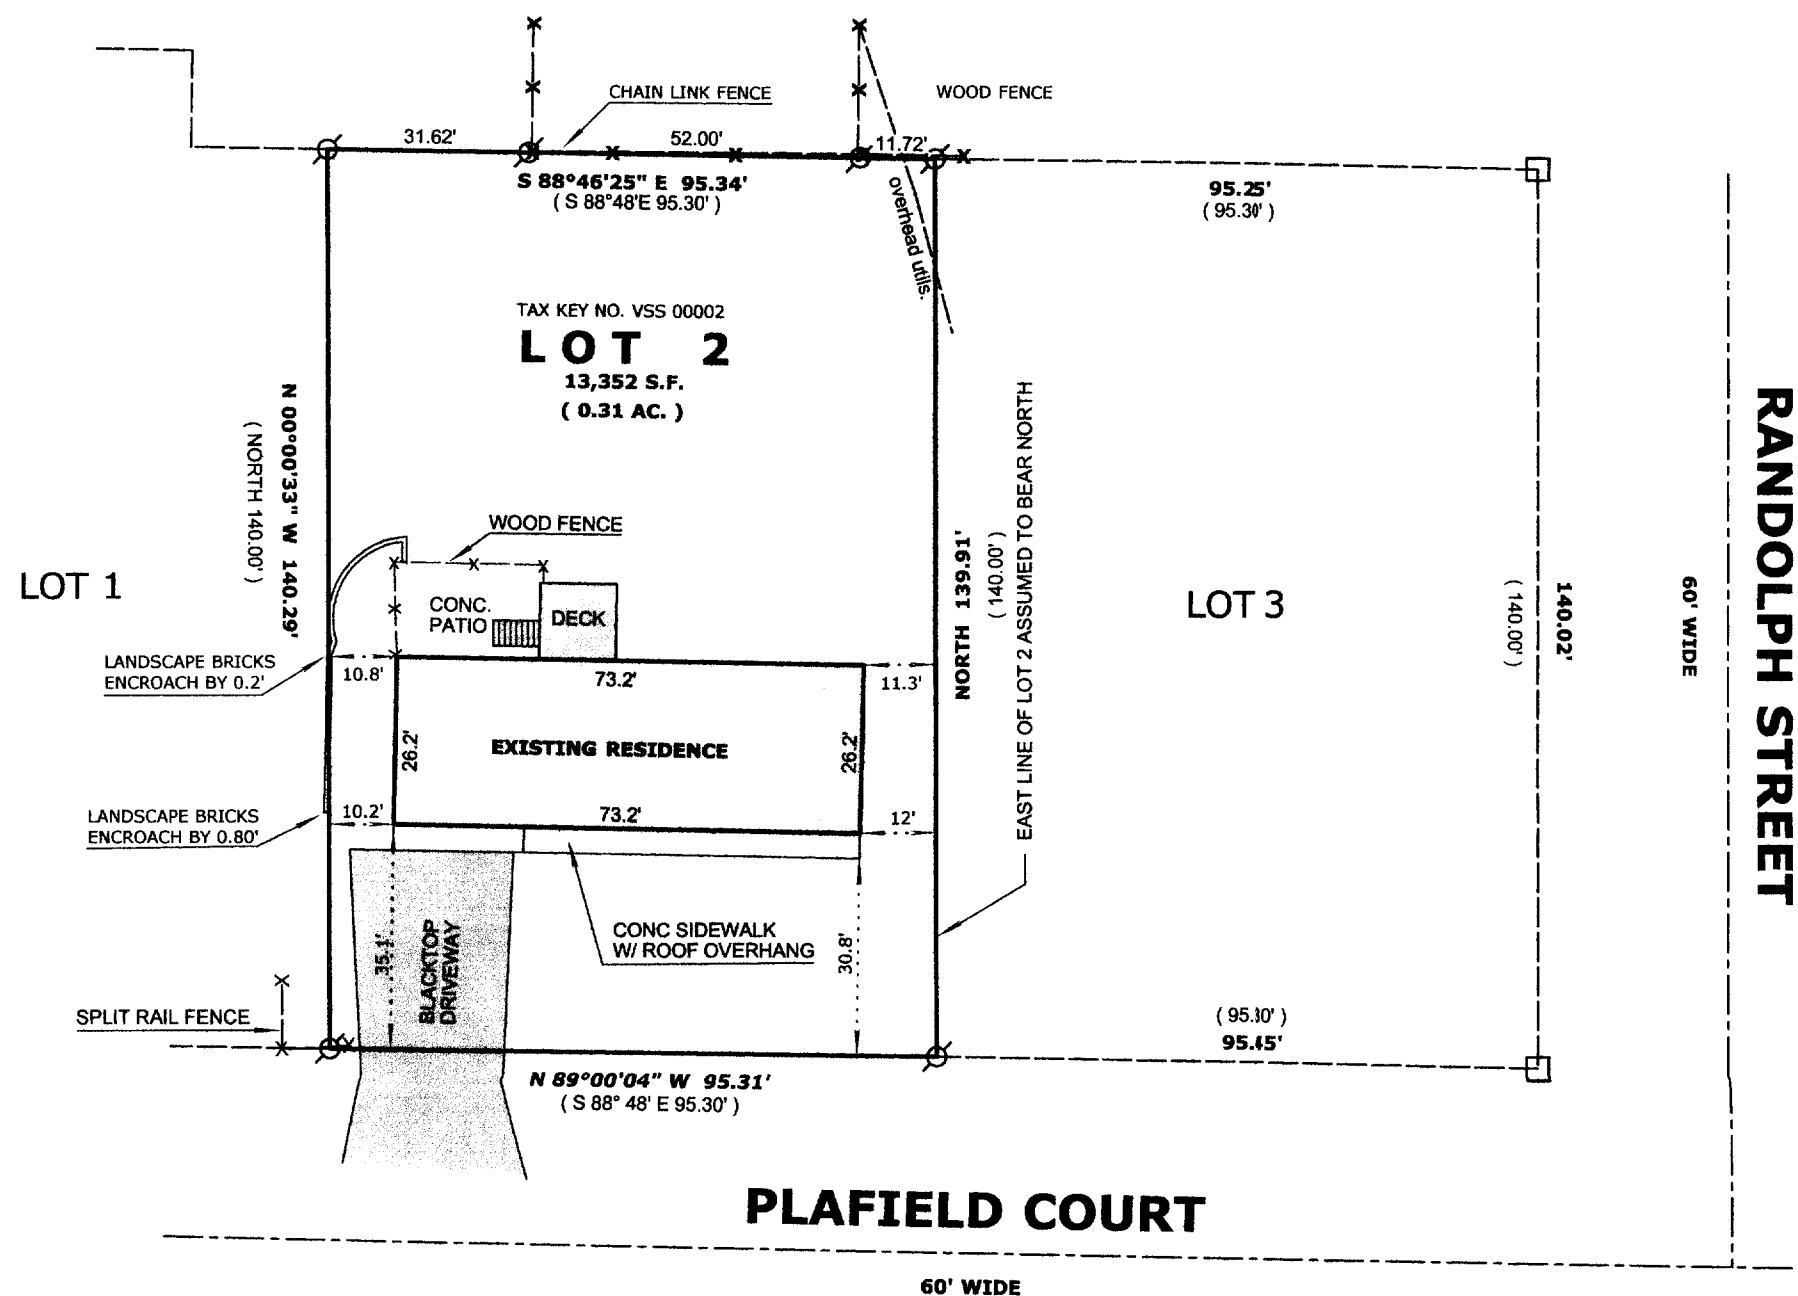

LEGEND

- | | |
|---|--|
|  | FOUND IRON PIPE |
|  | FOUND IRON ROD |
|  | FOUND COUNTY MONUMENT |
|  | FOUND CONCRETE MONUMENT |
|  | CHISEL CUT IN CONCRETE |
|  | SET IRON ROD, 24" LONG, WEIGHING
1.5 LBS./LINEAL FT., 3/4" DIA. |
| (x x) | RECORDED AS DIMENSION |
|  | EXISTING FENCE |

SCALE: 1" = 30 FEET

"I hereby certify that the above described property has been surveyed by me or under my direction and that the above map is a true representation thereof and shows the size and location of the property, its exterior boundaries, the location of all visible structures and dimensions of all principal buildings thereon, boundary fences, apparent easements, roadways and visible encroachments, if any."

"This survey is made for the use of the present owners of the property, and also those who purchase, mortgage, or guarantee the title thereto within one year from date hereof."

Mark L. Miritz
MARK L. MIRITZ
WISCONSIN REGISTERED
LAND SURVEYOR S-2582

DATE: APRIL 28, 2005 JOB NO. 05.417

VSS - 2

009-969