 


LOCATED IN THE NW 1/4 OF SECTION 27,
TOWN 1 NORTH, RANGE 16 EAST,
WALWORTH COUNTY, WISCONSIN

WISCONSIN STATE PLANE COORDINATE SYSTEM - NORTH ZONE

GRID NORTH

WEST LINE OF THE NW 1/4 OF SECTION 27-1-16
BEARS N 01°42'46" W
NAD 1927



● = FOUND IRON REBAR STAKE
(XXX) = RECORDED AS
G.E. = GARAGE ENTRY ELEVATION
T.C. = TOP OF FOUNDATION ELEVATION
XXX.X = EXISTING GROUND ELEVATION

PETER S. GORDON R.L.S. 2101

N 01°03'22" E 89.70'

OUTLOT 5

10 5 0 10 20 30 40 50 60 70 80 90 100

MAP SCALE IN FEET ORIGINAL 1" = 20'

PROJECT: 5189.39
DATE: 04/14/2005
SHEET 1 OF 1

UIP-0039

009-974