


GEORGE T. DUNHAM
SURVEYING & SUBDIVIDING
DELAVAN, WISCONSIN



Plat of survey of a parcel of land located in the Northeast $\frac{1}{4}$ of Section 21, T 1 N, R 16 E, and being a part of Outlot No. 3 of the Assessors Plat of the Village of Walworth, Walworth County, Wisconsin.
May 5, 1972
Revised 5/27/72

George T. Dunham
George T. Dunham, Surveyor

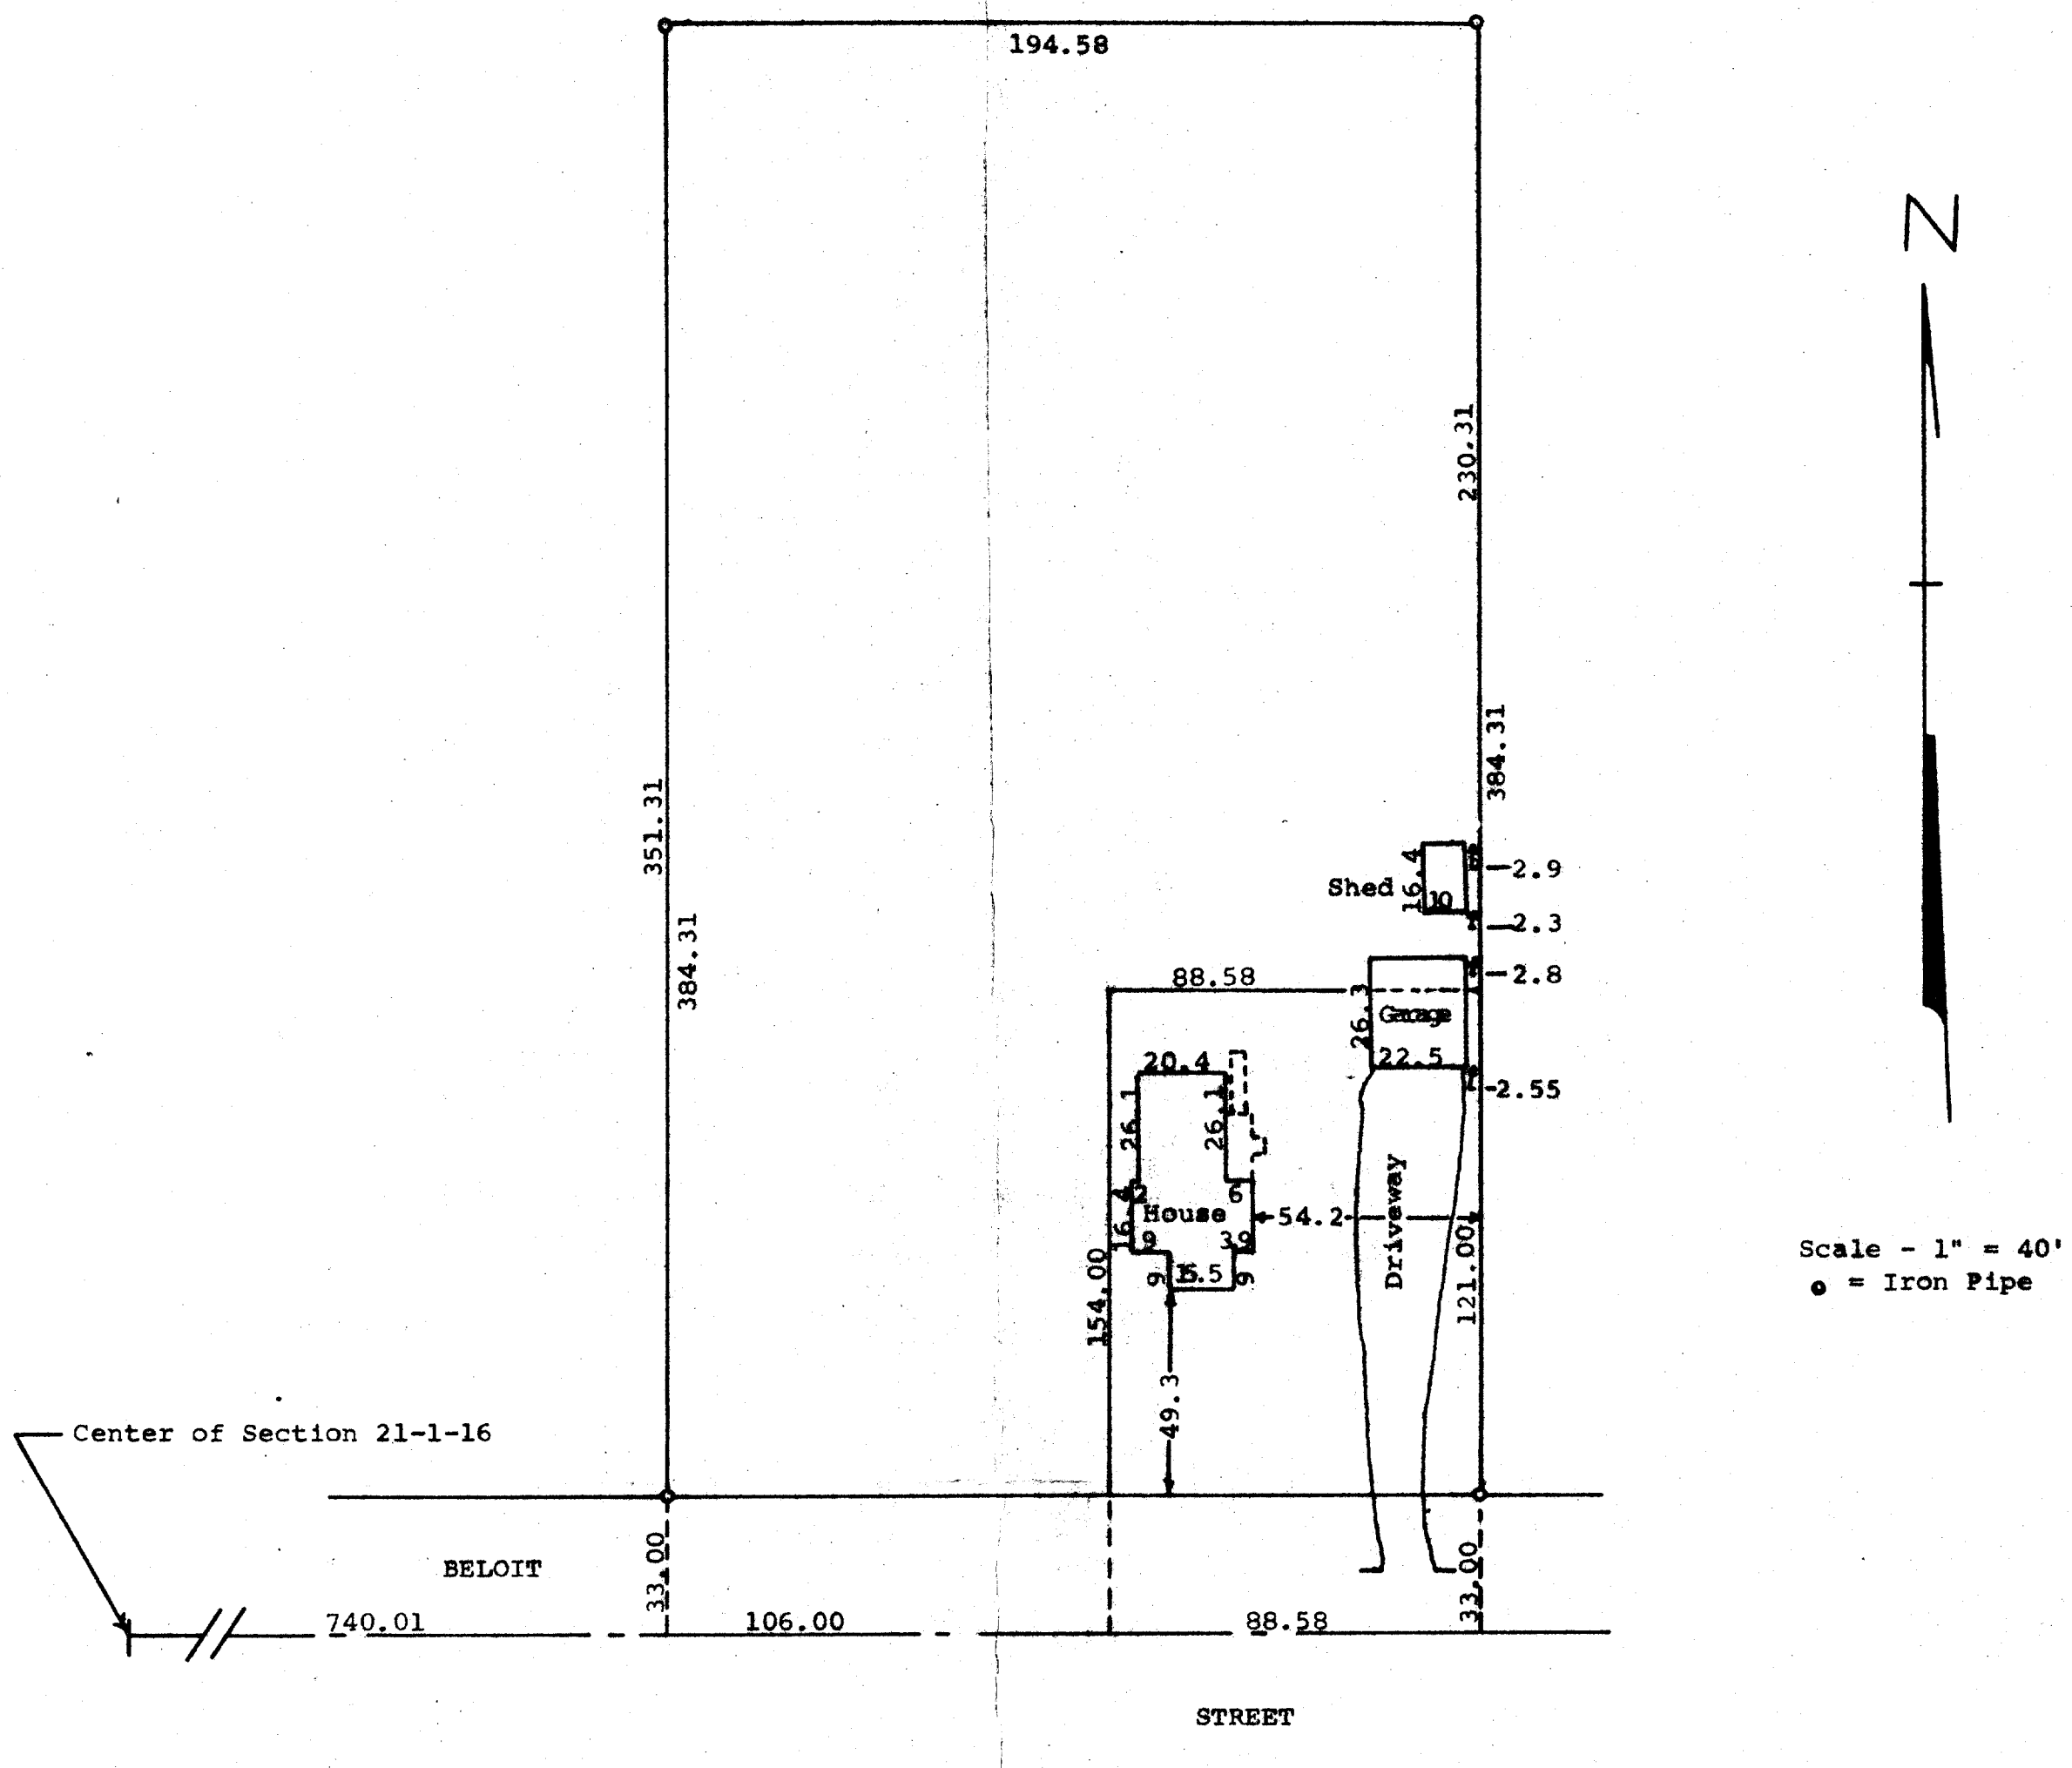