

ROBERS & BOYD, INC.
CONSULTING ENGINEERS & LAND SURVEYORS

PHONE (414) 763-2652

116 E. CHESTNUT ST.


BURLINGTON, WIS. 53105

PLAT OF SURVEY AND BUILDING LOCATION

OF

Part of Outlot 222 of Assessors Plat, located in the Southwest 1/4 of the Southwest 1/4 of Section 22, T1N., R16E., Village of Walworth, Walworth County, Wisconsin.

(See description attached)

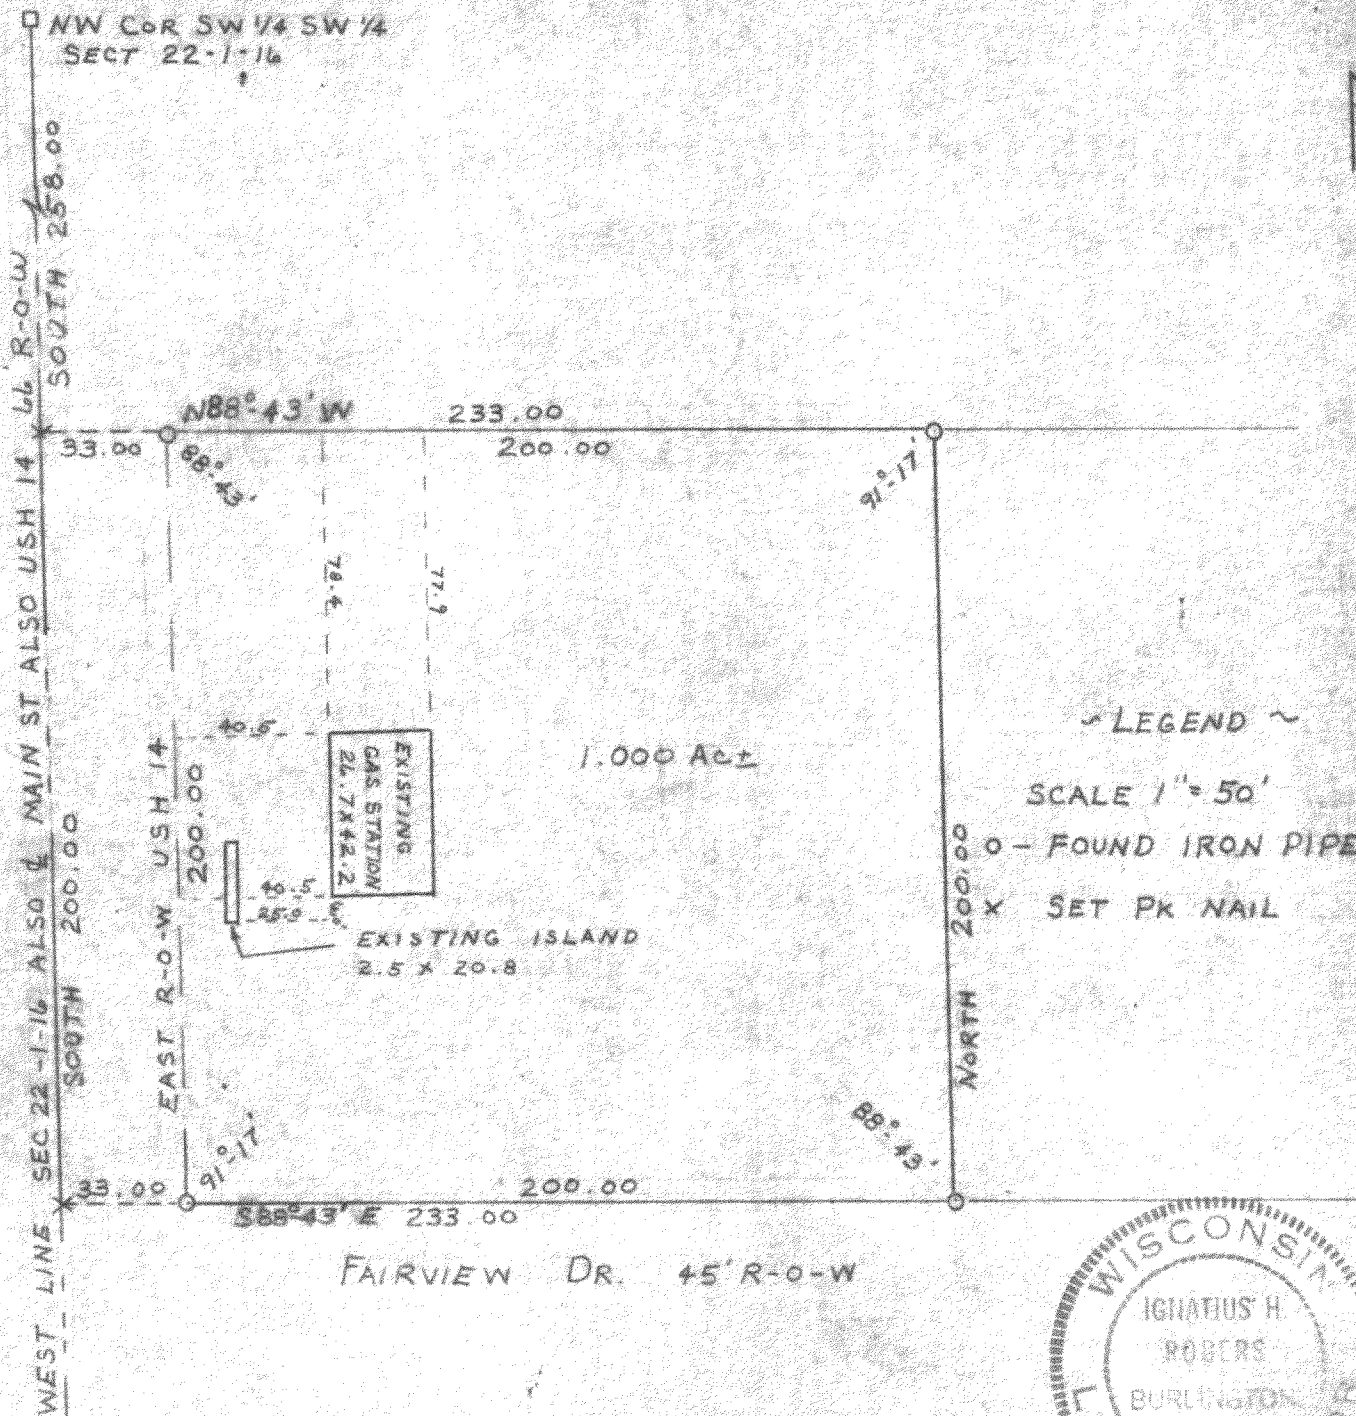

I HEREBY CERTIFY THAT WE HAVE SURVEYED THE LANDS DESCRIBED ABOVE ACCORDING TO OFFICIAL RECORDS AND THAT THE PLAT DRAWN HEREON IS A CORRECT REPRESENTATION OF SAID SURVEY.

Ignatius H. Rober
WIS. REG. LAND SURVEYOR
5007P7

DATE 10-12-72

JOB NO. 72163

ROBERS & BOYD, INC.
CONSULTING ENGINEERS AND LAND SURVEYORS
116 E. CHESTNUT STREET
BURLINGTON, WISCONSIN 53108
PHONE 414-783-2682

LEGAL DESCRIPTION

Commencing at a point in West section line which point is 258 feet South of the NW corner of the SW 1/4 of the SW 1/4 of Section 22 Twp 1 N; R. 16 E; thence East 233 feet to a point; thence South 200 feet to a point; thence West 233 feet to a point in West line of said Section 22; thence North 200 feet to place of beginning, all said Real Estate being a portion of Outlot 222 of Assessor's Plat, Village of Walworth, Walworth County, State of Wisconsin.


Subject to all Highways, Easements and Restrictions of Record.

DESCRIPTION BY SURVEY

Part of Outlot 222 of Assessor's Plat, located in the SW 1/4 of the SW 1/4 of Section 22, T1N., R16E., Village of Walworth, Walworth County, Wisconsin and more particularly described as follows:

Commence at the NW corner of the SW 1/4 of the SW 1/4 of said section, run thence South along the West line of said section which is also the center-line of Main Street (United States Highway 14) 258.00 feet to the place of beginning; thence continue South along said section line 200.00 feet, thence South 88°43' East 233.00 feet, thence North 200.00 feet, thence North 88°43' West 233.00 feet to the place of beginning.

Containing 1.070 acres more or less and subject to right-of-way of Main Street (United States Highway 14).

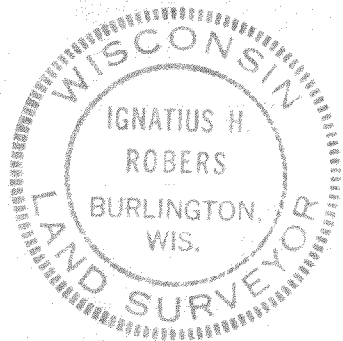

Ignatius H. Robers
Ignatius H. Robers
October 13, 1972
Survey # 72163