


GEORGE T. DUNHAM
SURVEYING & SUBDIVIDING
DELAVER, WISCONSIN

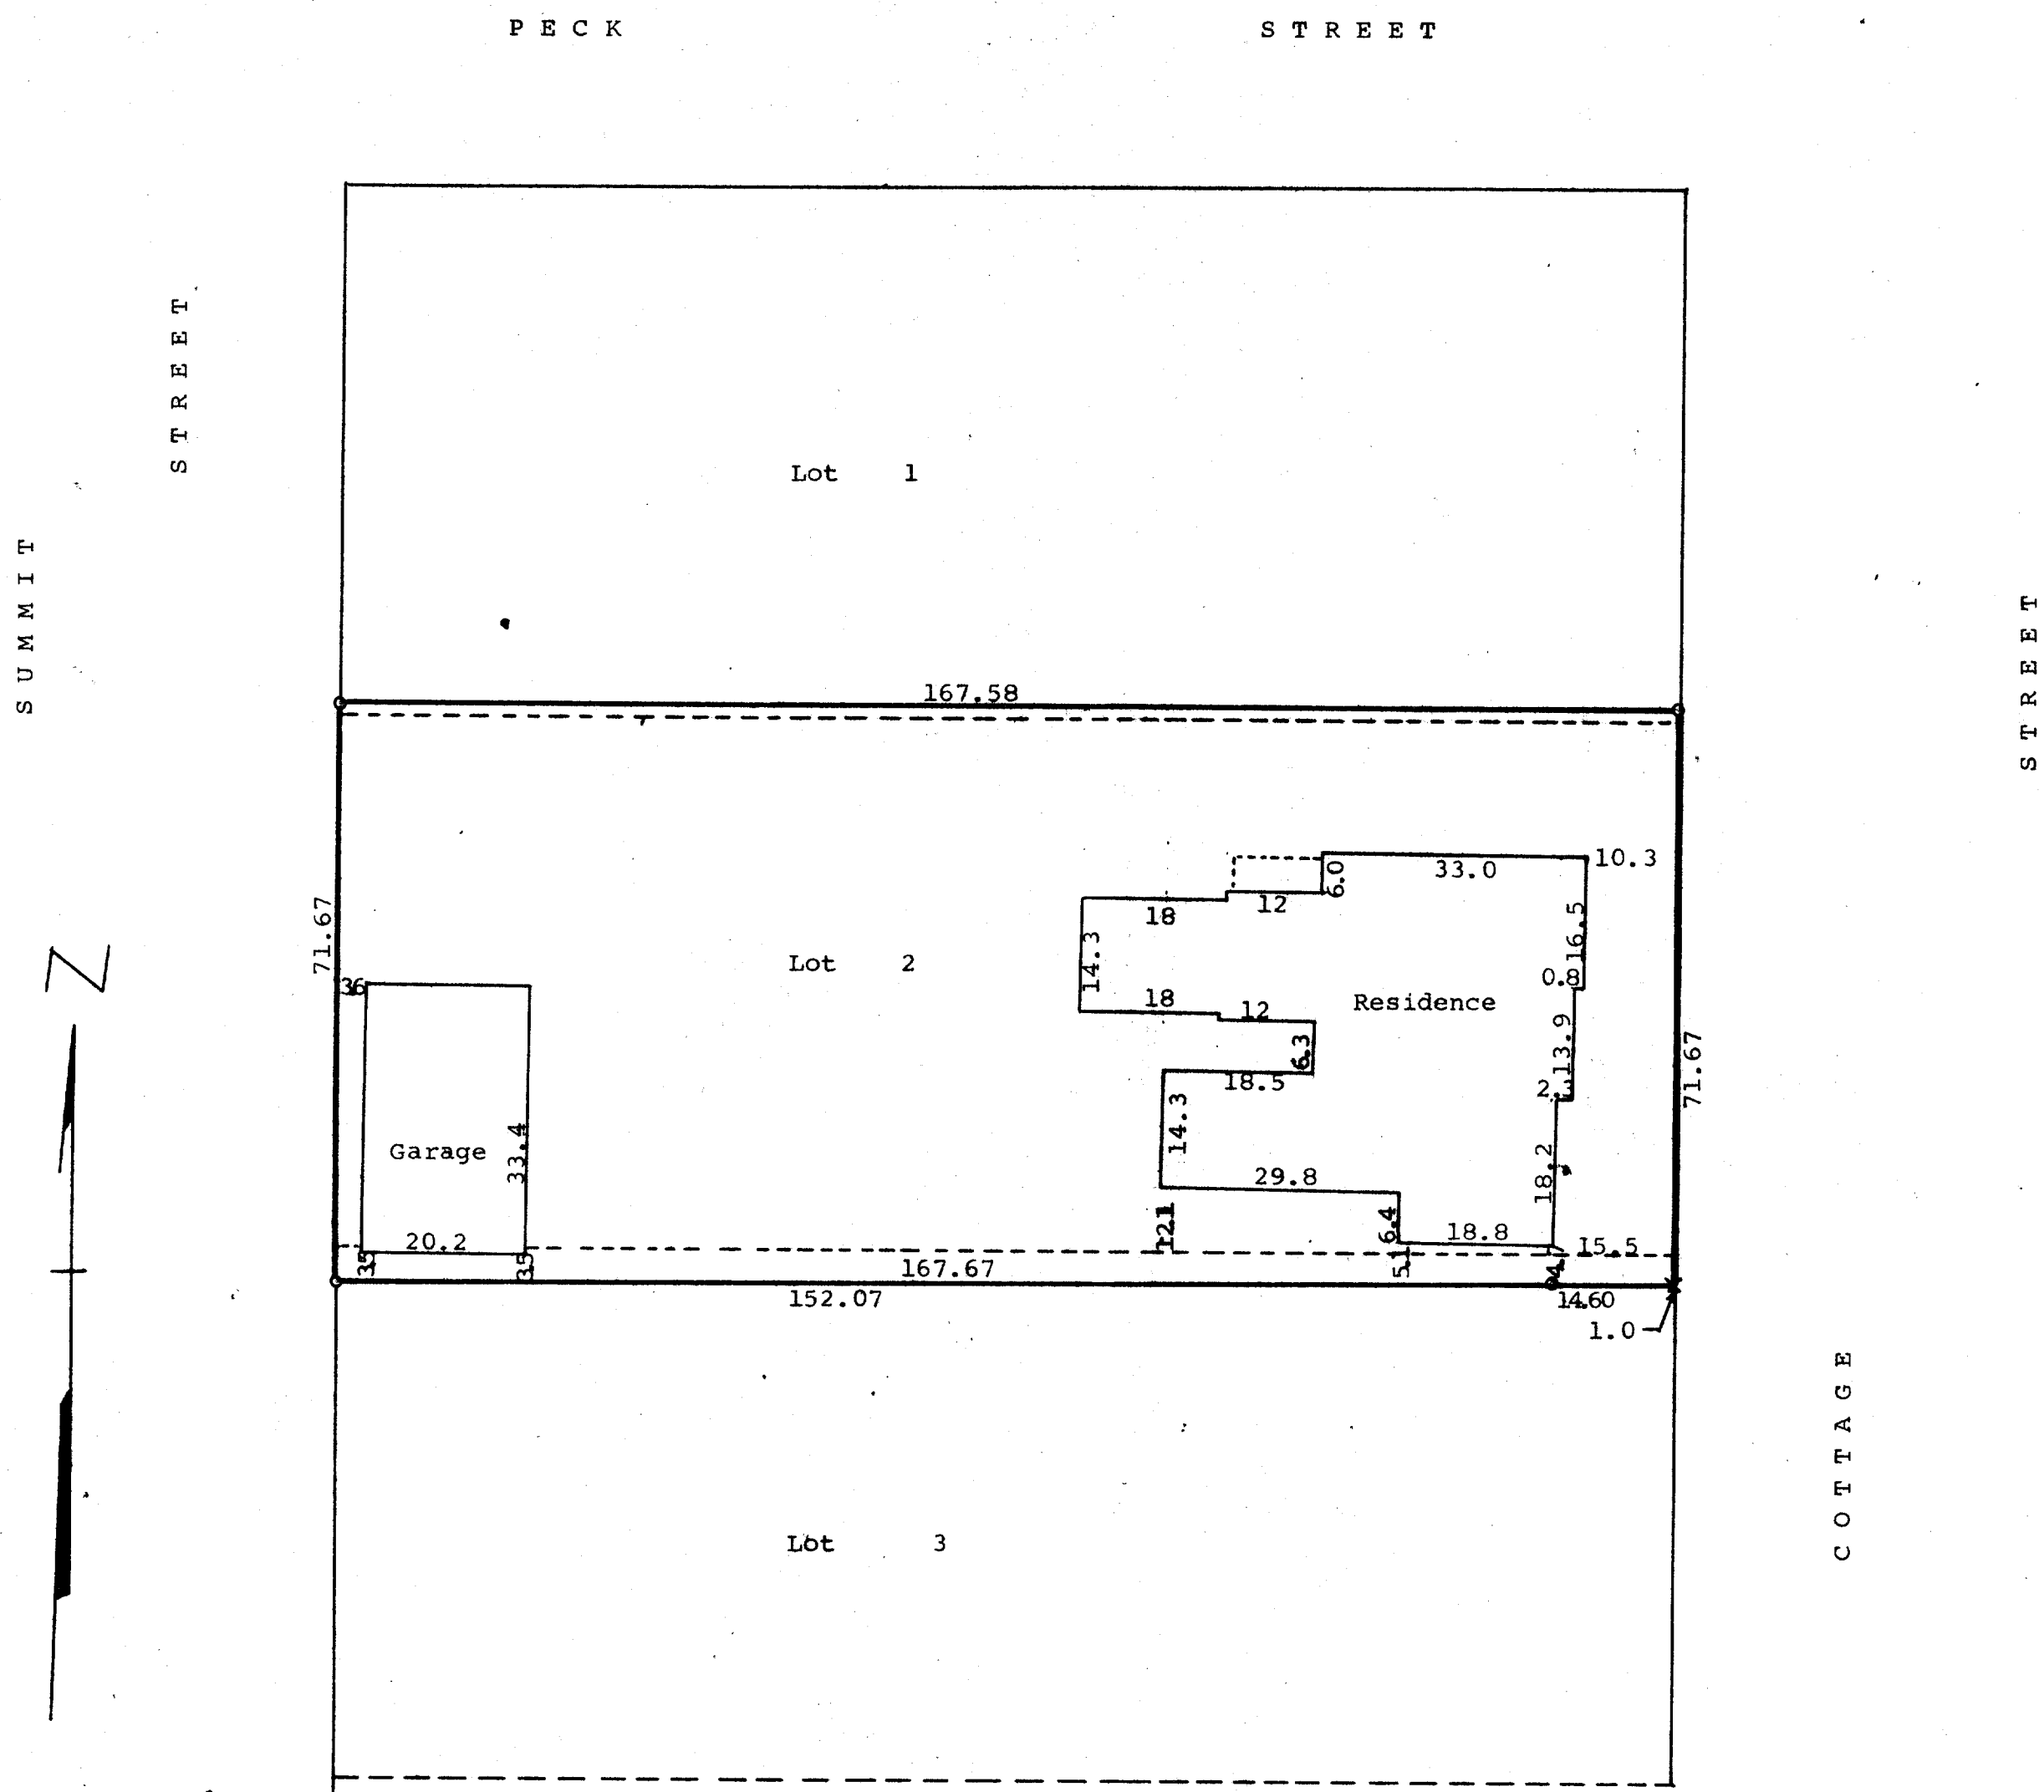

Scale - 1" = 20'
● = Iron Pipe
X = Cross in Concrete

Note: According to a survey in Dec. 1963 of Lot 1 by Harold Kolb, the survey markers along the west line of Cottage Street are placed 1.0 feet west of the lot line.

Plat of survey of
Lot 2 and the South 1.67 feet of Lot 1 and the North 4.00 feet
of Lot 3, Block 26 in Chapman and Ludington's Addition to the
Village (Now City) of Whitewater, Walworth County, Wisconsin.
October 12, 1966

George T. Dunham
George T. Dunham, Surveyor