

LAND-MARK SURVEYING

Mark L. Miritz

Wisconsin Professional Land Surveyor S-2582


N9330 Knuteson Drive
Whitewater, WI 53190
Phone: (262) 495-3284
MARKMIRITZ@
LAND-MARKSURVEYING.COM

PLAT OF SURVEY

Lot 4 in Block 3 of Tripp's Second Addition to the Village, now-City, of Whitewater, and also all that part of Lot 5 in said Block 3 lying South of a line drawn from a point on the West line 53 feet North of the Southwest corner to a point on the East line 60 feet from the Southeast corner. Said land being in the City of Whitewater, County of Walworth, State of Wisconsin. Together with a portion of the westerly half of the vacated alley as per resolution recorded as Document No. 862734 of Walworth County Records. Located adjacent to the East side of the here-in-before described parcel and between the East-west lot lines, of said parcel, extended Easterly to the centerline of said vacated alley.

OWNER:
HABITAT FOR HUMANITY
IN WALWORTH COUNTY, INC.
P.O. BOX 174
LAKE GENEVA, WI 53147

Horizontal Datum is based on the Wisconsin State Plane Coordinate System Grid, South Zone, North American Datum of 1927, all bearings are referred to Grid North. The NORTH line of the SE 1/4 of Section 4-4-15 was assumed to bear S 88°10'25" W

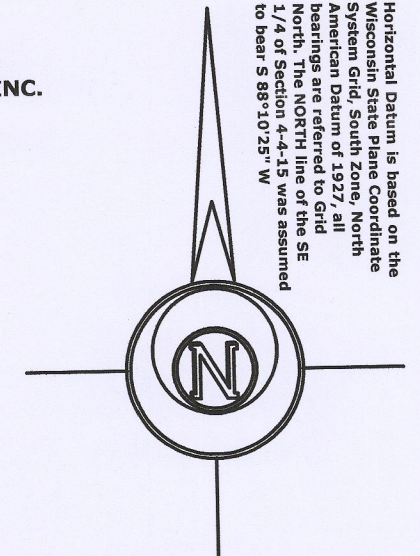

LEGEND

- FOUND IRON PIPE
- FOUND IRON ROD
- FOUND CONCRETE MONUMENT
- RECORDED AS DIMENSION

SCALE: 1 INCH = 30 FEET



"I hereby certify that the above described property has been surveyed by me or under my direction and that the above map is a true representation thereof and shows the size and location of the property, its exterior boundaries, the location of all visible structures and dimensions of all principal buildings thereon, boundary fences, apparent easements, roadways and visible encroachments, if any."
"This survey is made for the use of the present owners of the property, and also those who purchase, mortgage, or guarantee the title thereto within one year from date hereof."

Mark L. Miritz
MARK L. MIRITZ
WISCONSIN PROFESSIONAL
LAND SURVEYOR S-2582

REVISED JAN. 31, 2017 TO SHOW
RESIDENCE & DECK "AS BUILT"

DATE: NOV. 1, 2015 JOB NO. 15.1009

WAKELY STREET
(60.06')

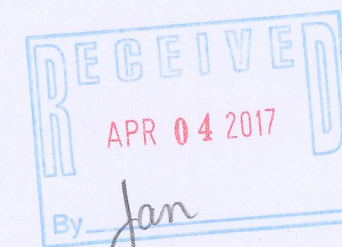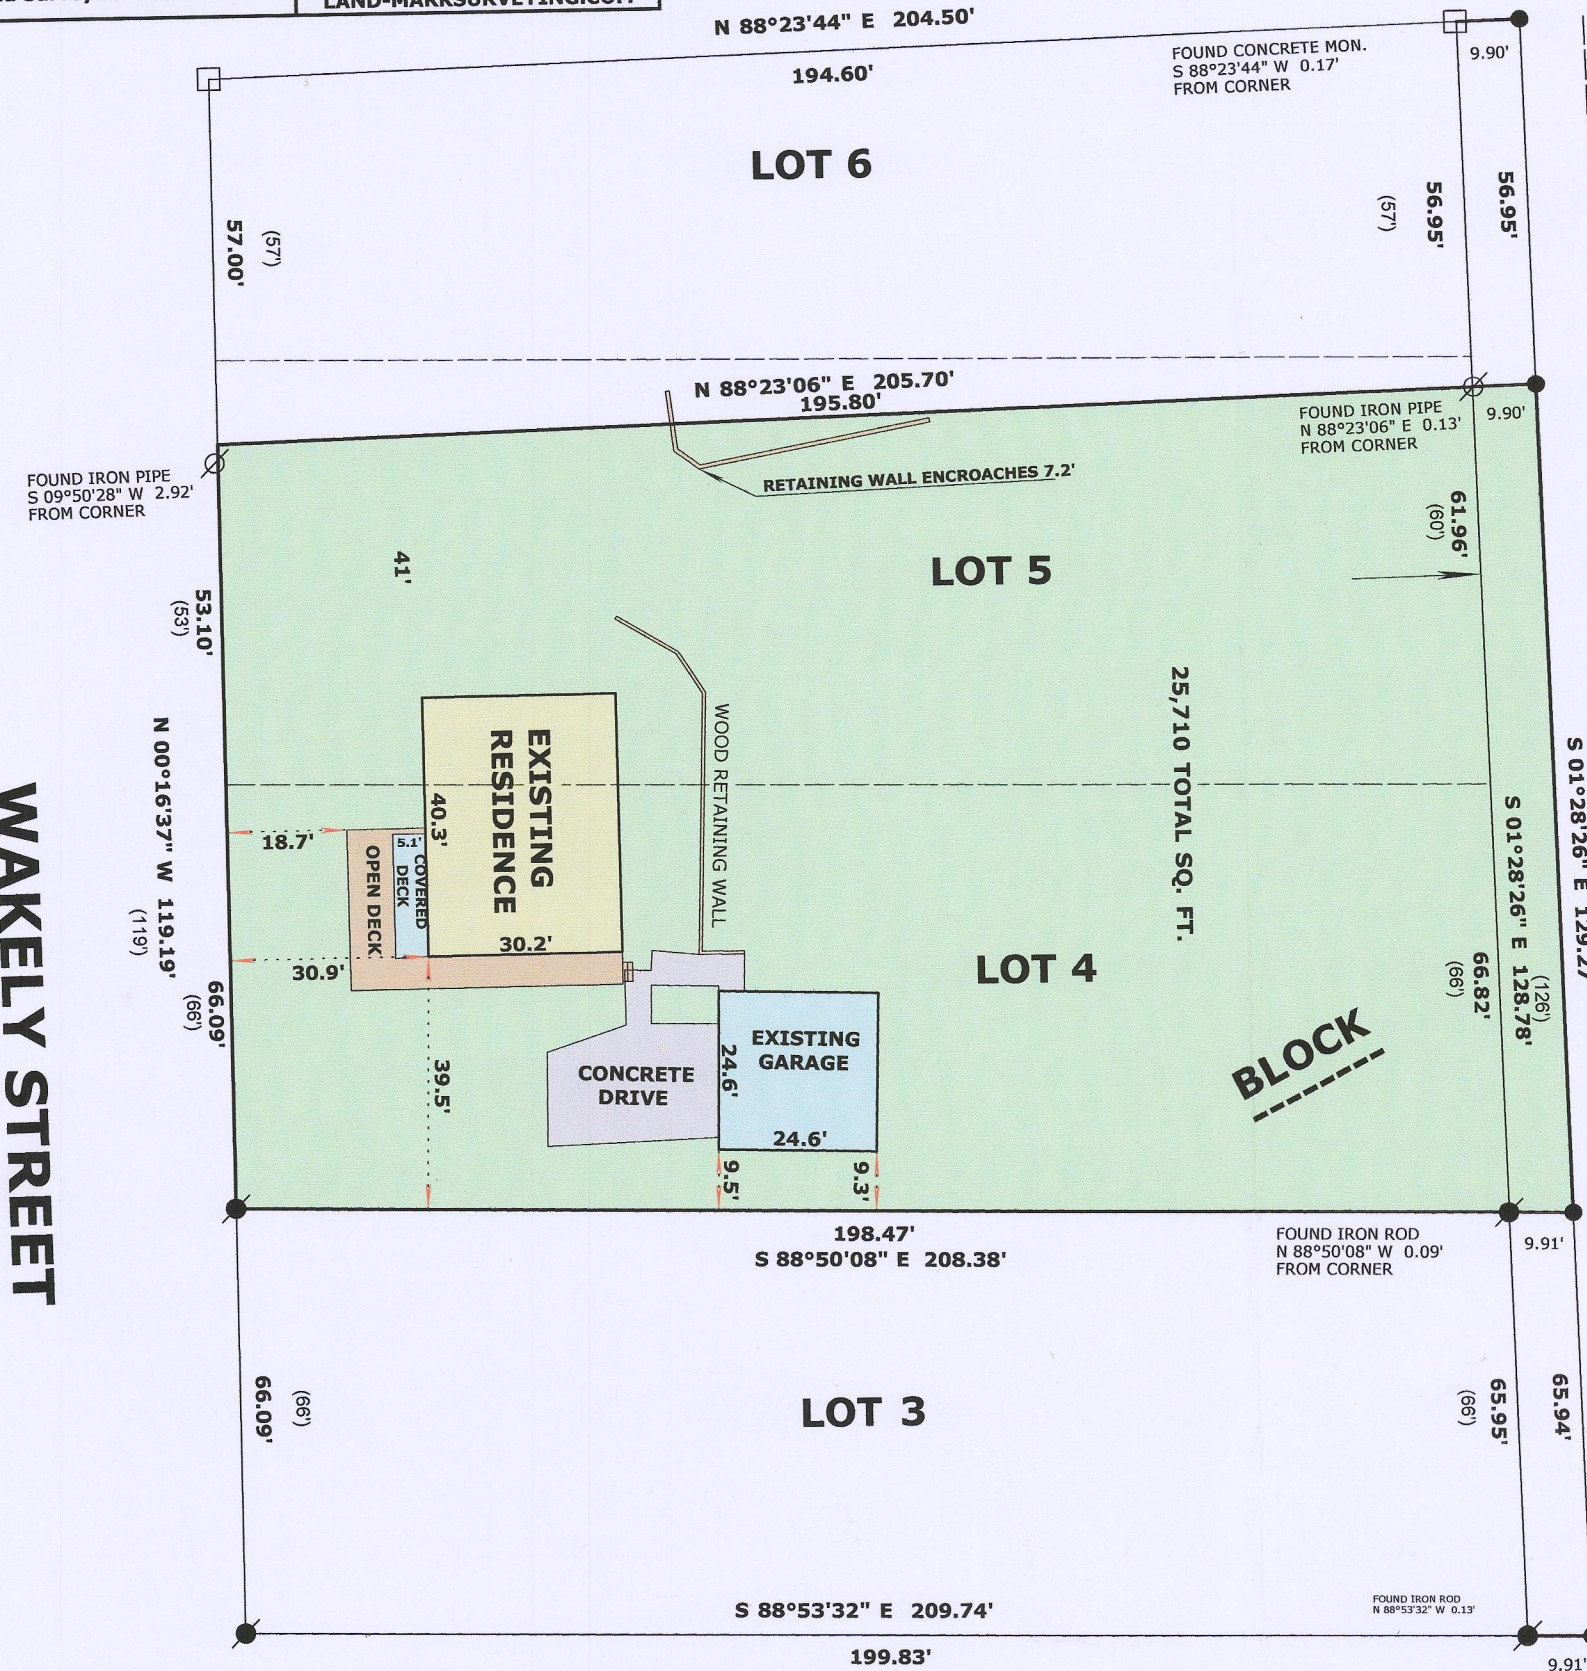

1TRA-28 010-1032