

LAND-MARK SURVEYING
Mark L. Miritz
Wisconsin Professional Land Surveyor S-2582


N9330 Knuteson Drive
Whitewater, WI 53190
Phone: (262) 495-3284
MARKMIRITZ@
LAND-MARKSURVEYING.COM

ORDERED BY:
RANDALL ASCHBRENNER
P. O. BOX 511
MCFARLAND, WI 53558


PLAT OF SURVEY

THE NORTH 4 RODS (66 FEET) OF LOT 1, BLOCK 1 OF BULKLEY
AND TRATT'S ADDITION TO THE CITY OF WHITEWATER, COUNTY
OF WALWORTH, STATE OF WISCONSIN.

PRAIRIE STREET
(60' WIDE)

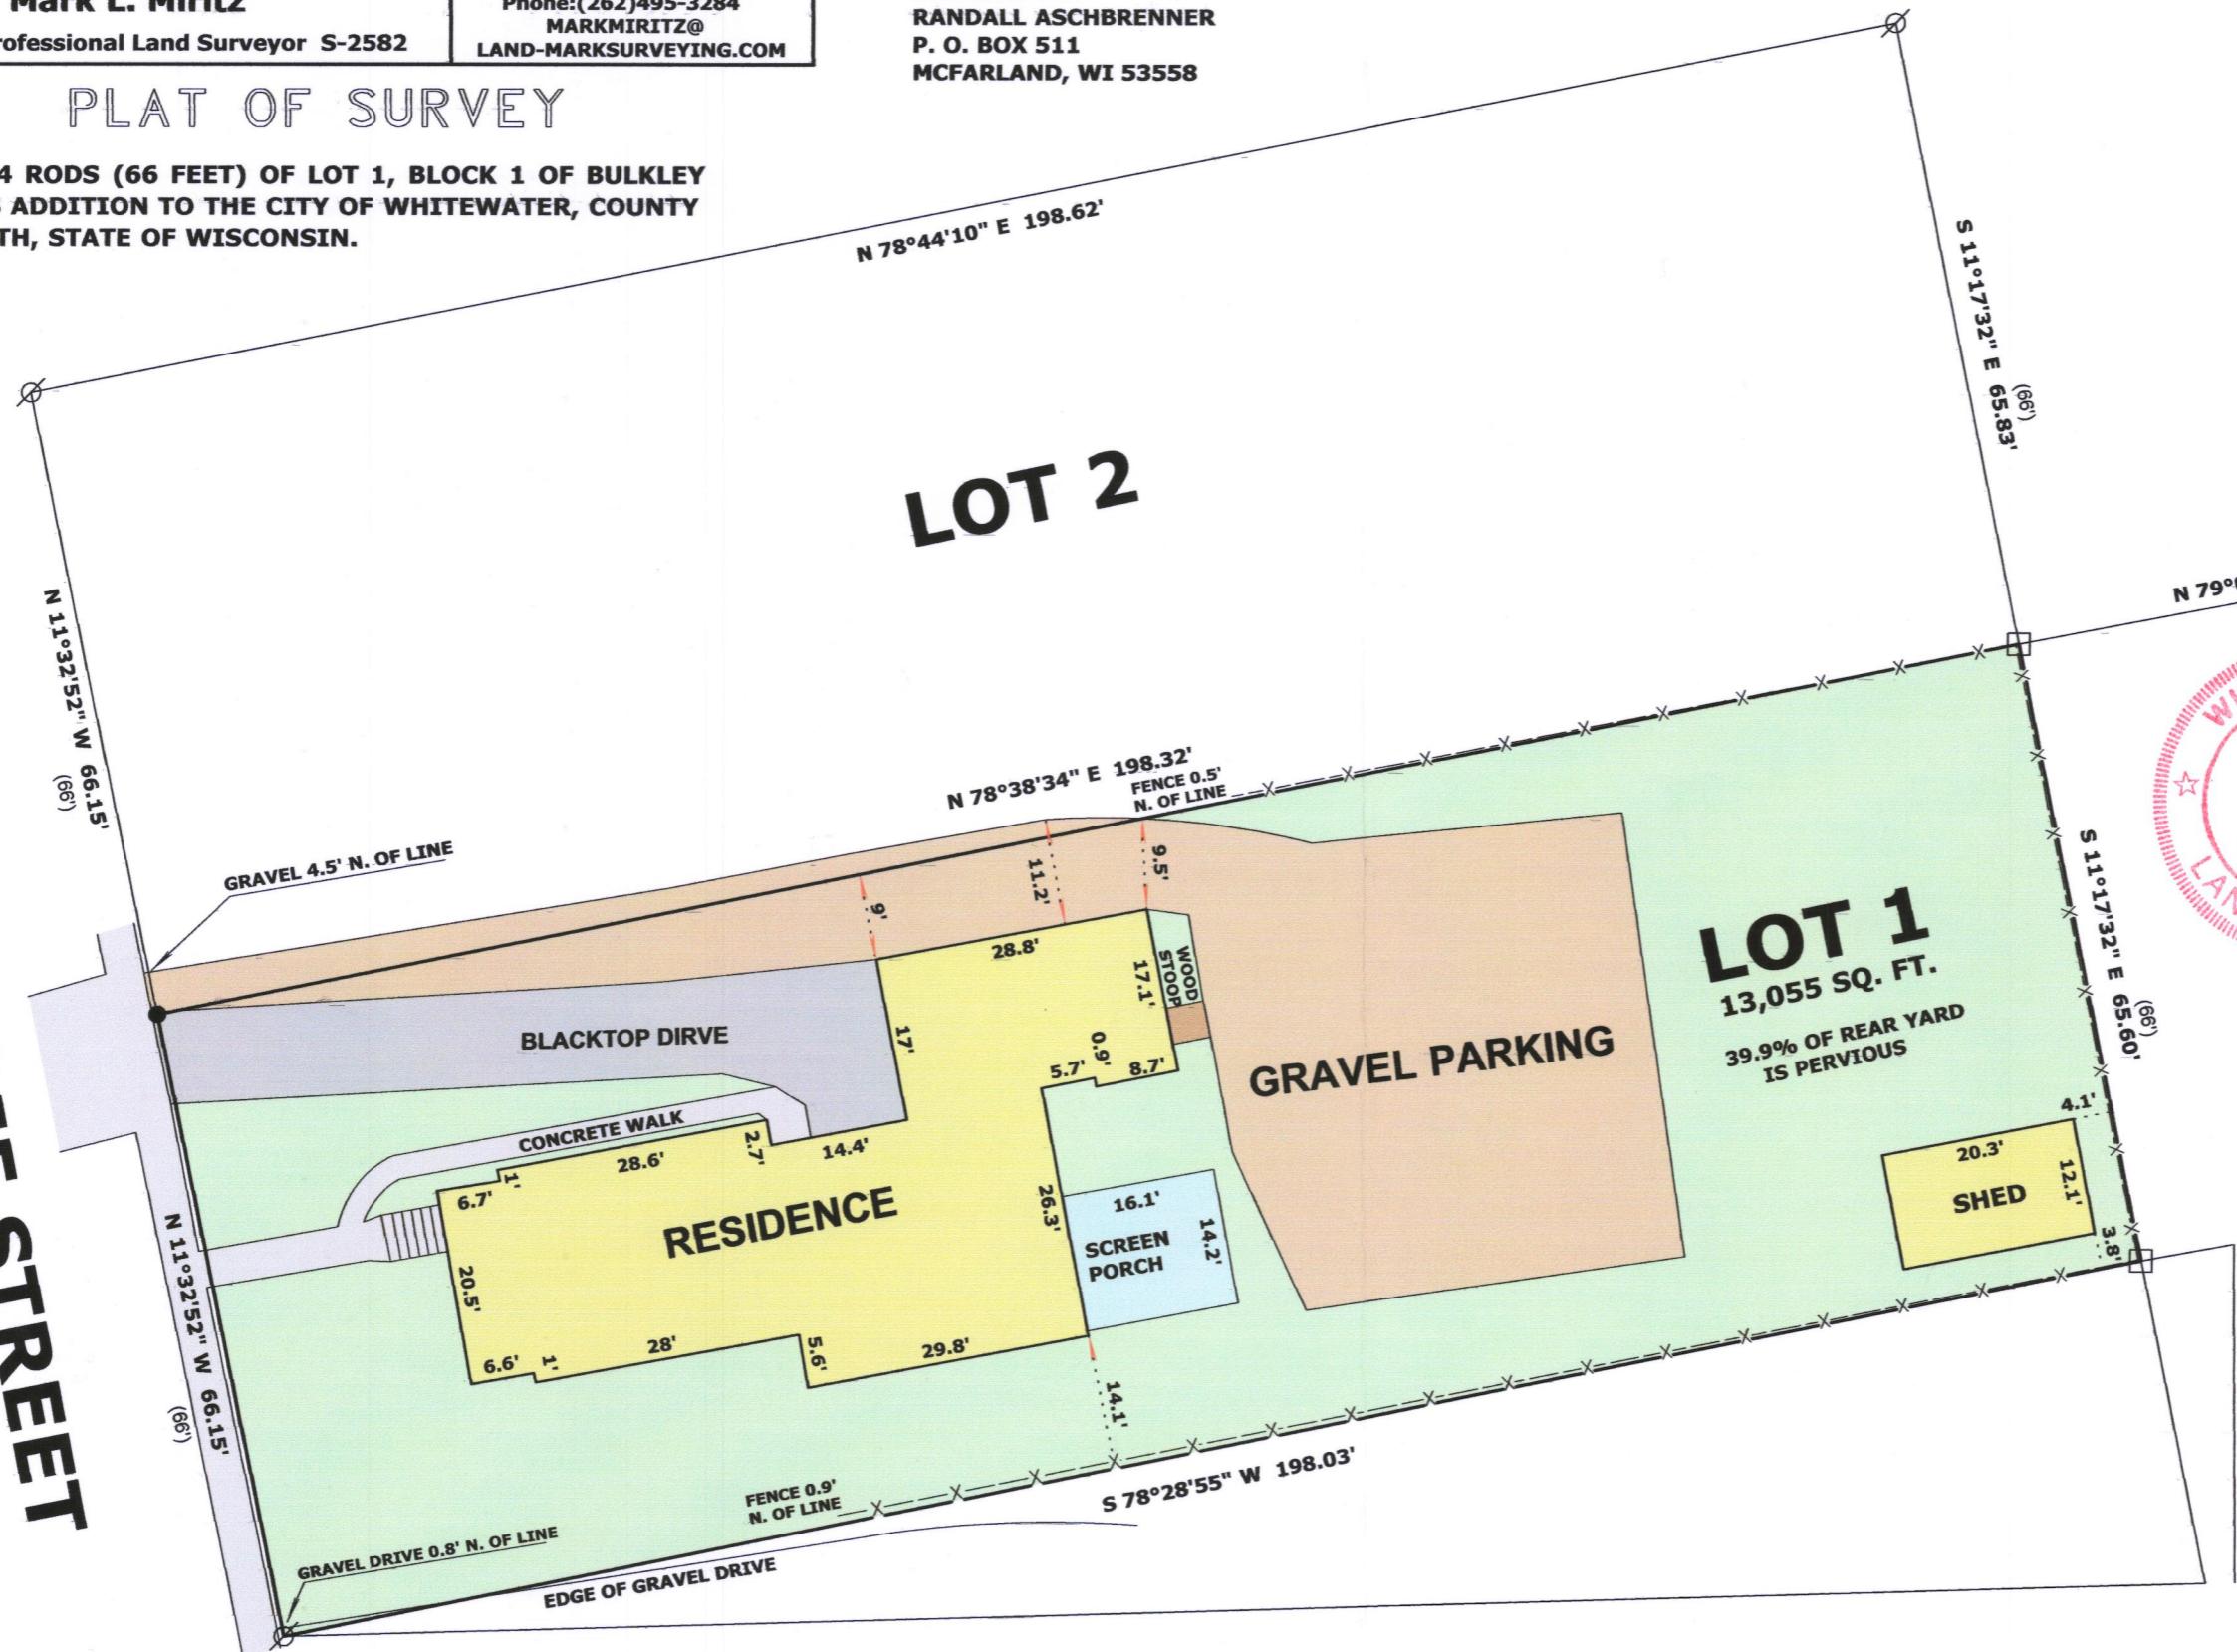

THE EASTERLY LINE OF
PRAIRIE STREET WAS
ASSUMED IN 11°32'52" W

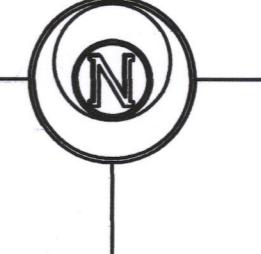

RECEIVED
OCT 26 2017
By Jan

LEGEND

- ∅ FOUND IRON PIPE
- FOUND IRON ROD
- 2.5" DIA. STEEL FENCE POST IN CONCRETE
- SET IRON ROD, 18" LONG, WEIGHING 1.5 LBS./LINEAL FT., 3/4" DIA.
- (xx) RECORDED AS DIMENSION
- Existing CHAIN LINK FENCE

SCALE: 1 INCH = 20 FEET

"I hereby certify that the above described property has been surveyed by me or under my direction and that the above map is a true representation thereof and shows the size and location of the property, its exterior boundaries, the location of all visible structures and dimensions of all principal buildings thereon, boundary fences, apparent easements, roadways and visible encroachments, if any."

"This survey is made for the use of the present owners of the property, and also those who purchase, mortgage, or guarantee the title thereto within one year from date hereof."

Mark L. Miritz

MARK L. MIRITZ
WISCONSIN PROFESSIONAL
LAND SURVEYOR S-2582

DATE: AUGUST 27, 2017 JOB NO. 17.812

1BUL-1

010-1045