


Plat of Survey

Survey For: Gordon J. & Jill A. Backman

Location: 531 W. Center Street, City of Whitewater, Walworth County, Wisconsin

Description: A part of Lots 1 and 2 in Block 22 of Chapman & Ludington's Addition to the City of Whitewater, located in the NE 1/4 of the SE 1/4 of Section 5, T4N, R15E, City of Whitewater, Walworth County, Wisconsin, bounded as follows: Beginning at the NW corner of said Lot 1; running thence E on the N Line of said Lots 1 and 2, 74 1/4 feet; thence S. parallel with the W line of said Lot 1, 146 feet; thence W parallel with the N line of said Lots 1 and 2, 74 1/4 feet; thence N along the W line of said Lot 1 to the point of beginning.

Subject to all rights, reservations, restrictive covenants, and easements recorded or unrecorded.

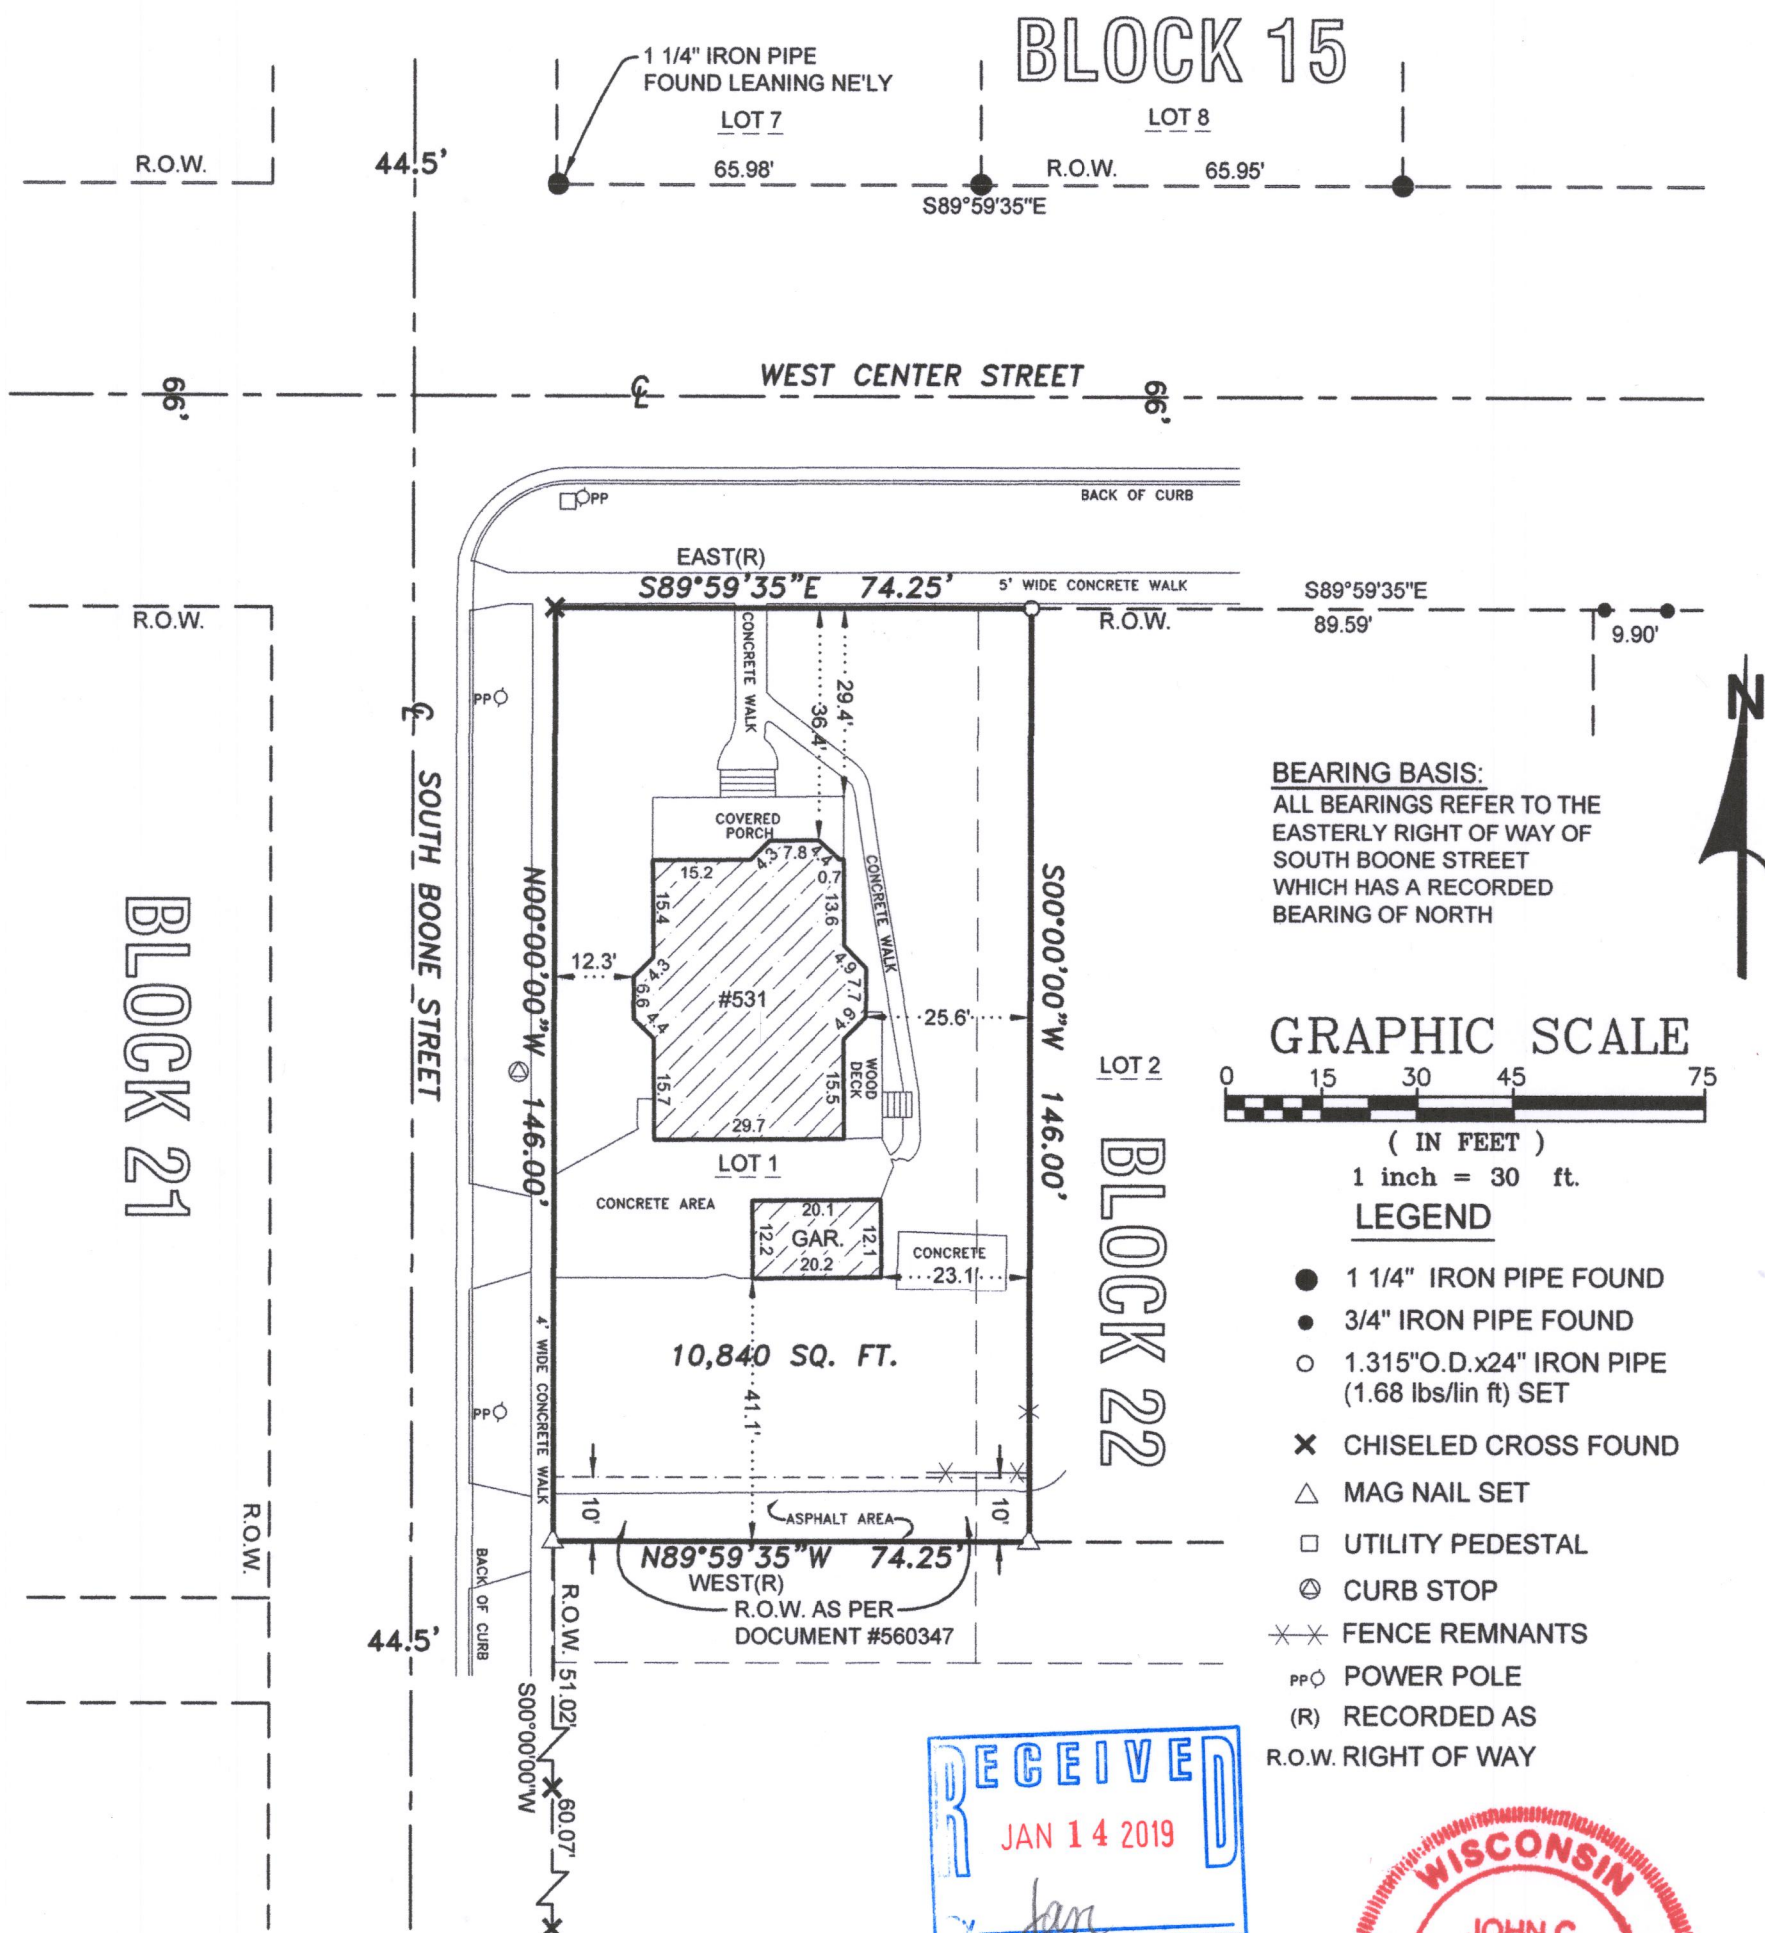

SOUTHWEST
SURVEYING & ASSOCIATES, Inc.

P.O. BOX K, PALMYRA, WI. 53156
262-495-4910
920-674-4884



State of Wisconsin) ss
Jefferson County) I certify that I have surveyed the above described (property) and the above map is a true
representation thereof and shows the size and location of the Property, its exterior boundaries, the location and
dimensions of all visible structures thereon, fences, apparent easements and roadways and visible encroachments,
if any to the best of my knowledge and belief.

THIS IS A JOHN C. KANNARD AUTHORIZED
PRINT ONLY IF SIGNATURE APPEARS IN
RED INK ON BLACK LINE PRINT.

JOHN C. KANNARD, Professional Land Surveyor

SHEET 1 OF 1
DATE: OCTOBER 8, 2015
JOB NO: B-215157

1CL-40 010-1060