


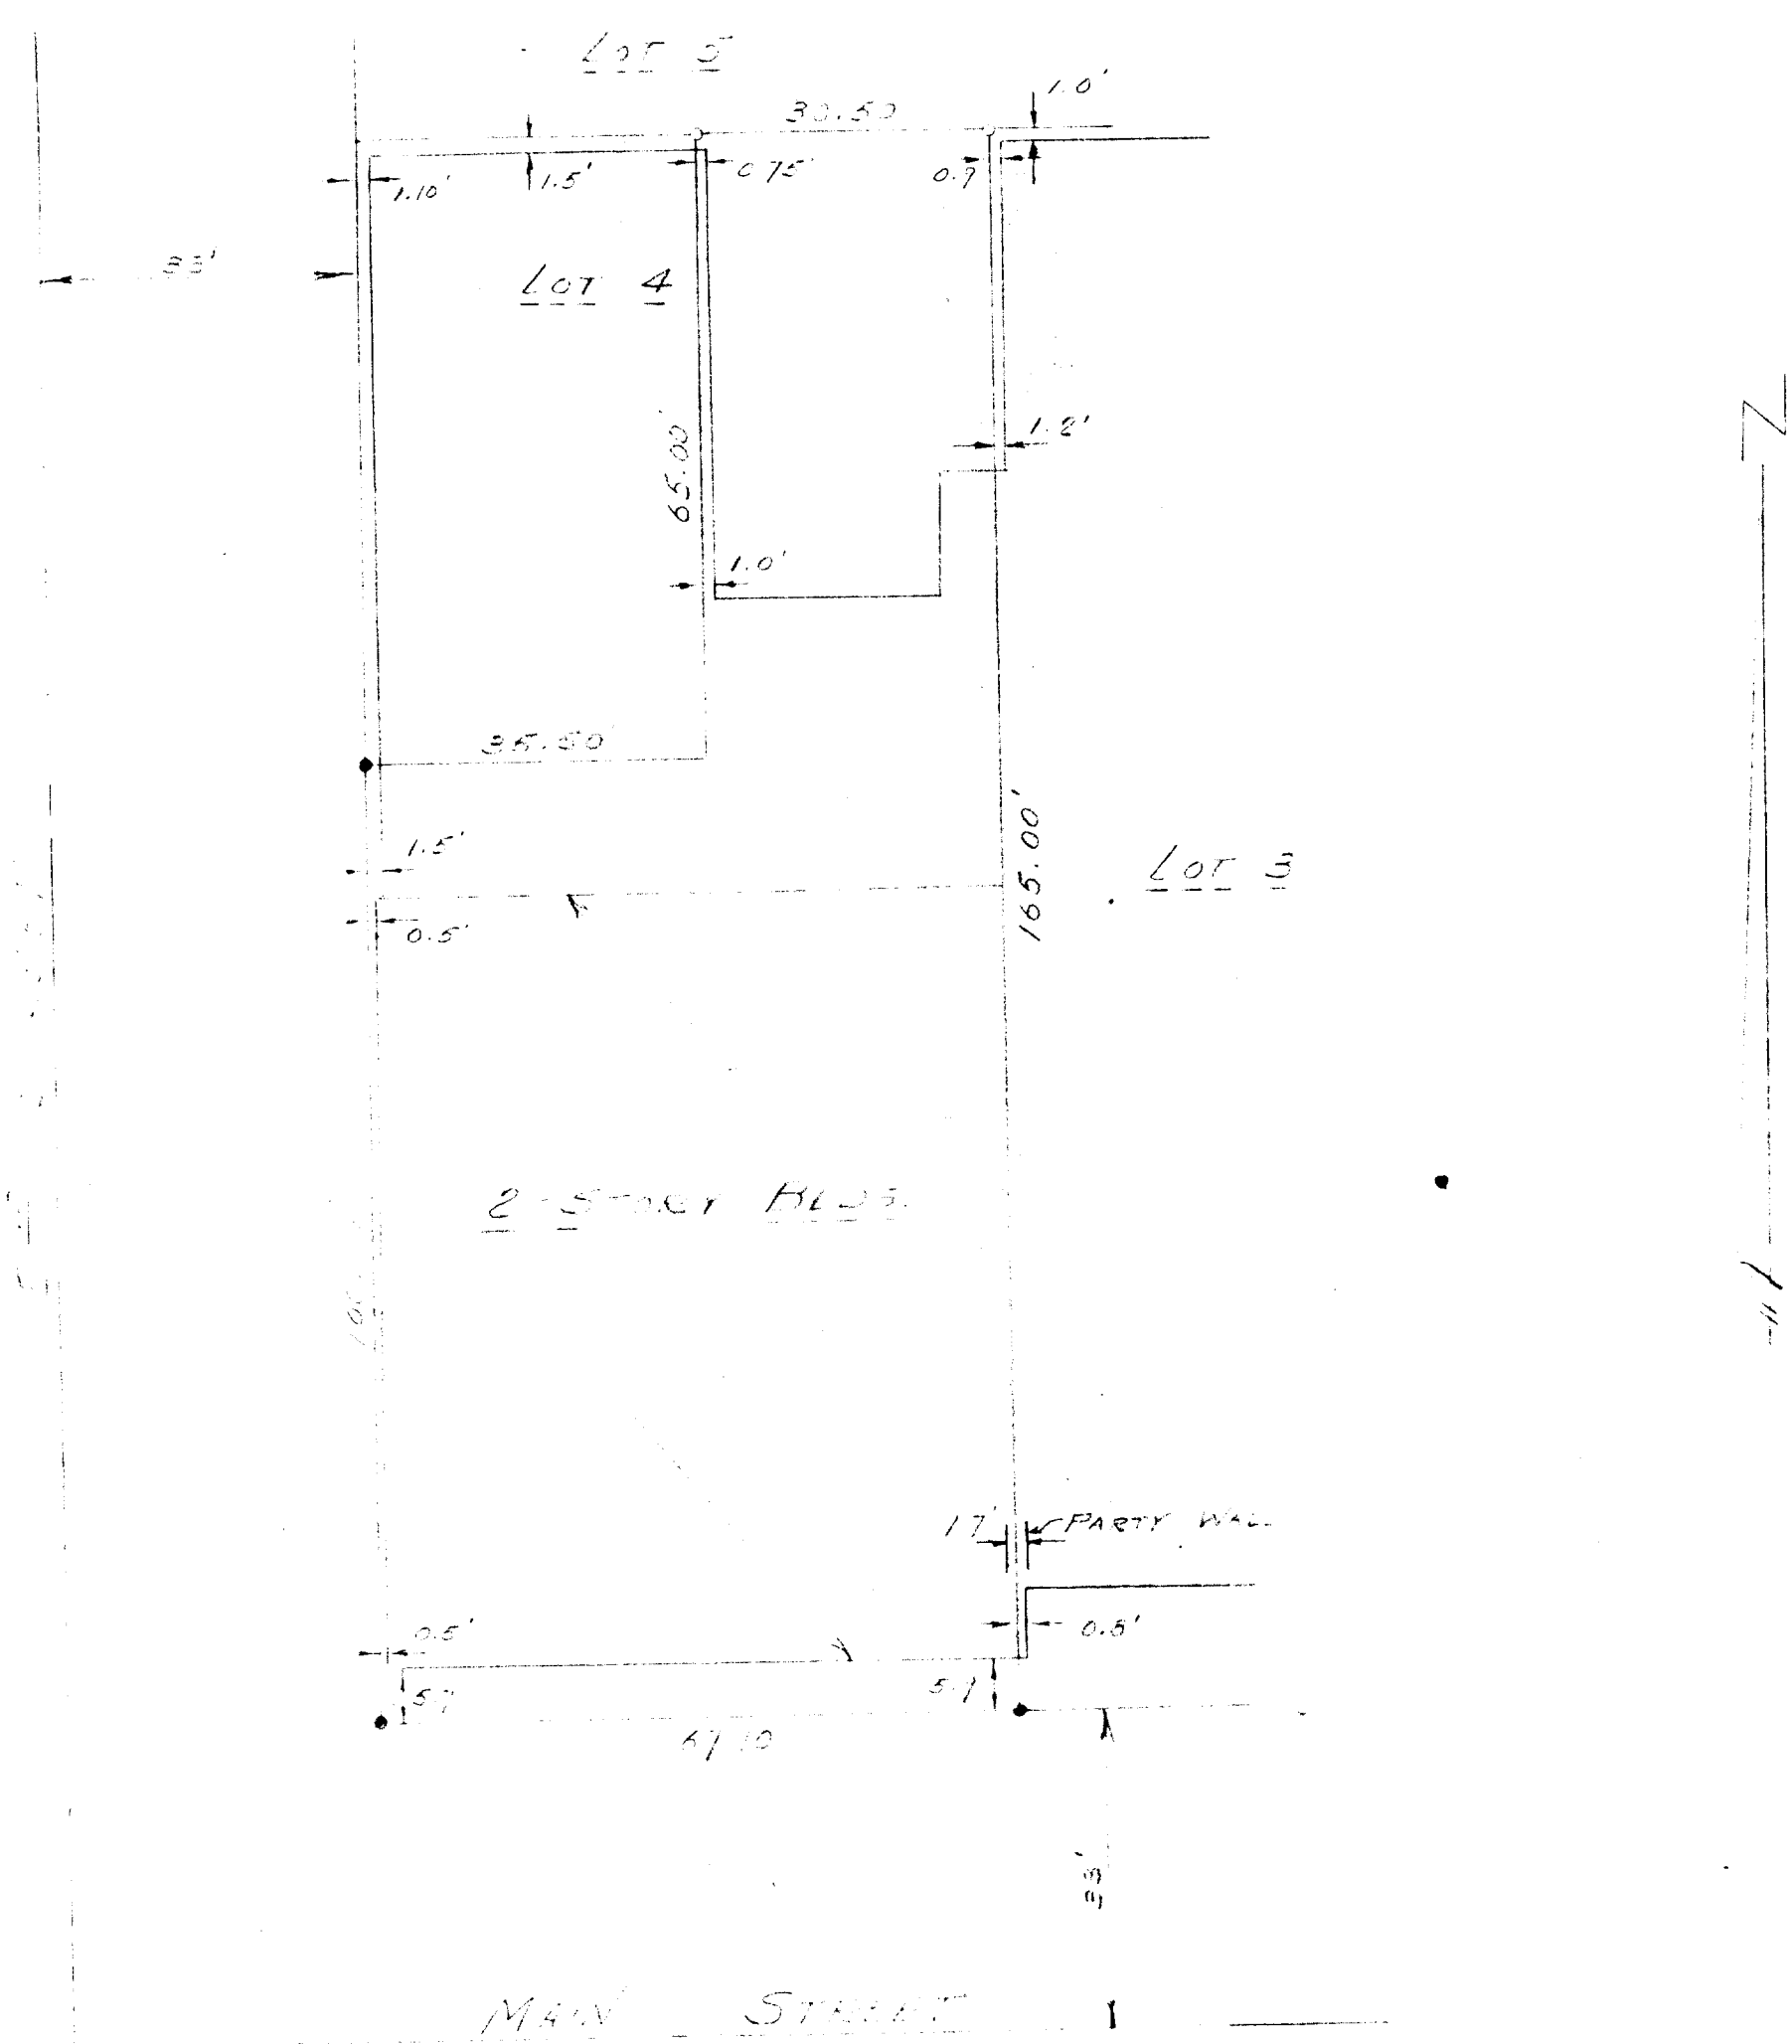

- Legend
- IRON STAKE
 - IRON NAIL CORNER

PLAT OF SURVEY OF

PART OF LOT 4 BLOCK 2
ORIGINAL PLAT - CITY OF
WHITEWATER, BALDWIN
COUNTY, MICHIGAN

10-10-101 James M. Jones
SURVEYOR

OT-21

10-10-64

SCALE 1" = 10'

DATE 2-11-2-1974