



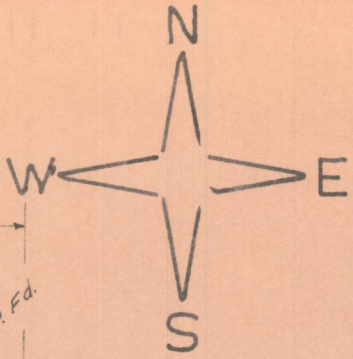

10 0 10 20 30 40 50 60 70 80 90 100
SCALE
FEET

LOT 2

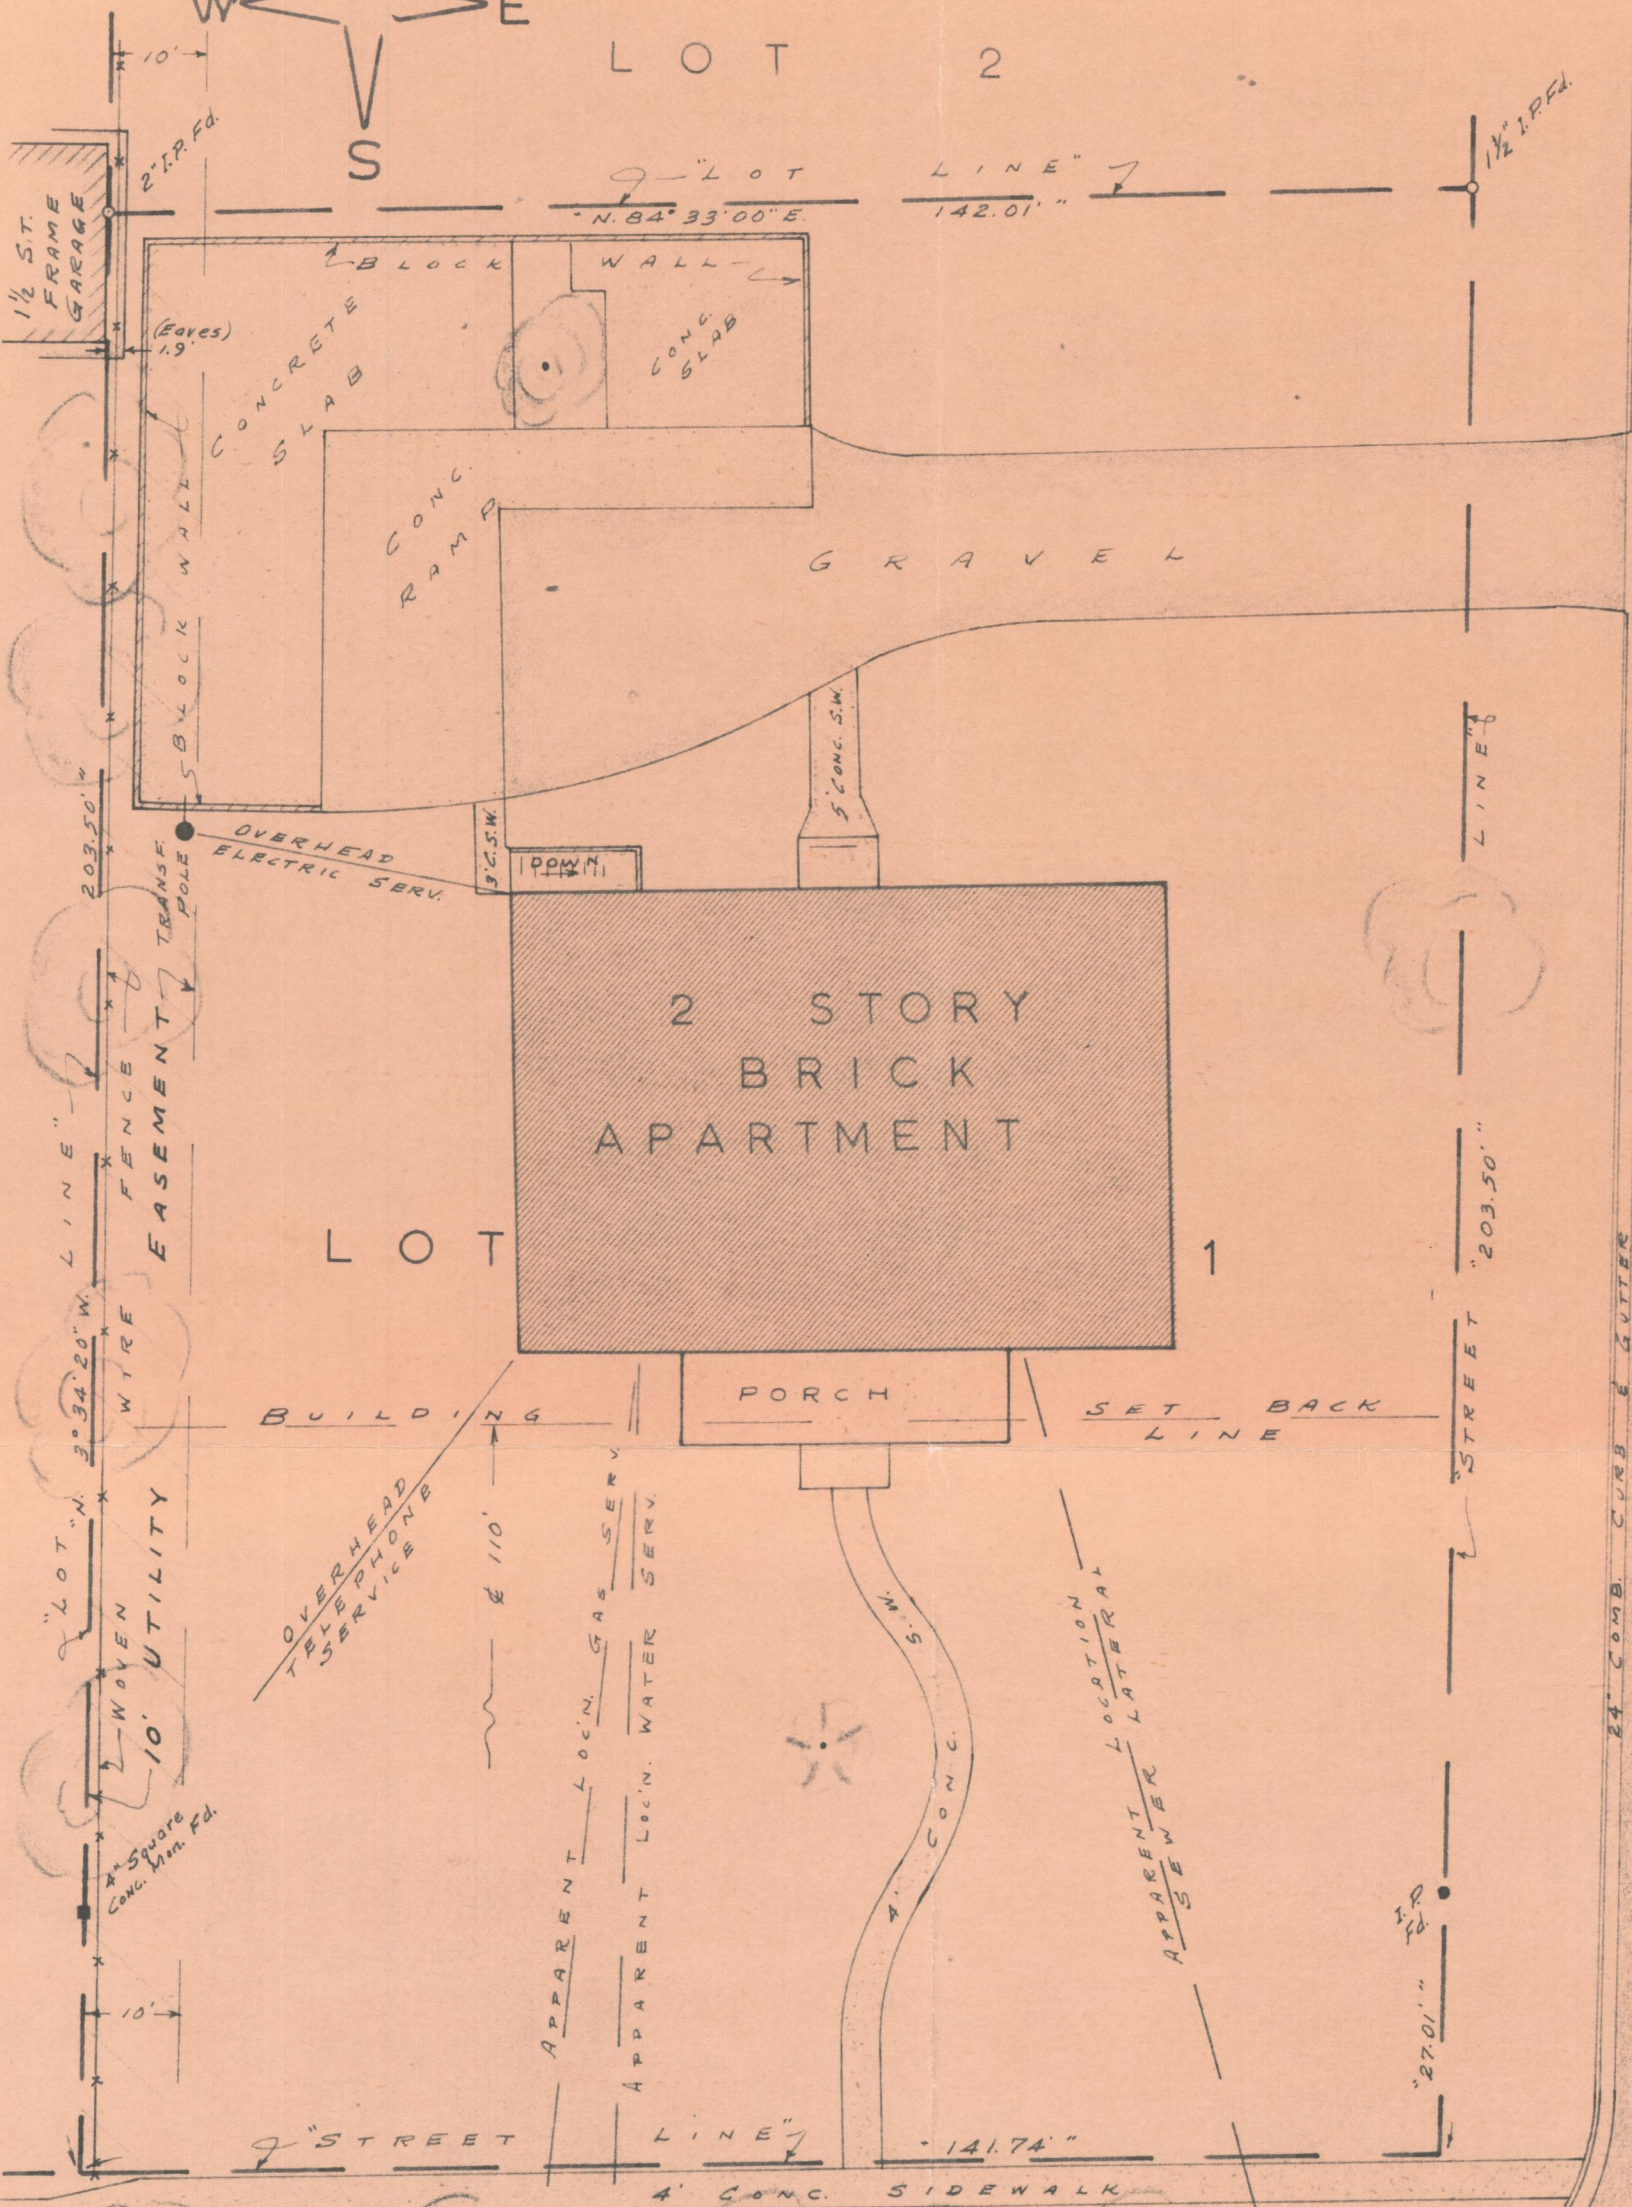

GRAVEL PAVEMENT
"N. 3°30'00\" W." 66'
12TH PLACE

"W. MAIN STREET 66'"

ACCURACY:

Planimetry (detail); 90 o/o within $\pm 1'$
Boundary; Boundary monuments found are believed to be those set by Waterman, Fuge & Assoc., Inc. (P-48), "Ward Addition to the City of Whitewater" (Vol. 14 of plats, P. 24, office of Register of Deeds). All boundary information shown hereon is from this source, believed to be correct, but not a part of this survey.

Revised: 12-10-62 To correct pvt., W. Main; add utility easement; and add bldg. set back.

IMPROVEMENTS SURVEY


of
Lot 1, Block 1, Ward Addition to the
City of Whitewater, Wisconsin
for

C. EDWARD WARD

December 7, 1962 Scale: 1" = 20'

Richard R. Mayer
Surveyor

Fort Atkinson, Wisconsin

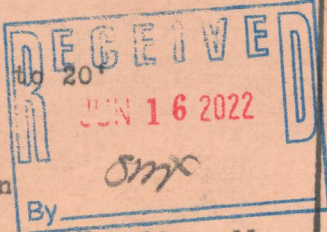

No. 62-69-11
Rev.

W-1

010-1118

W.F.A.