


VERIFIED STREET MAP

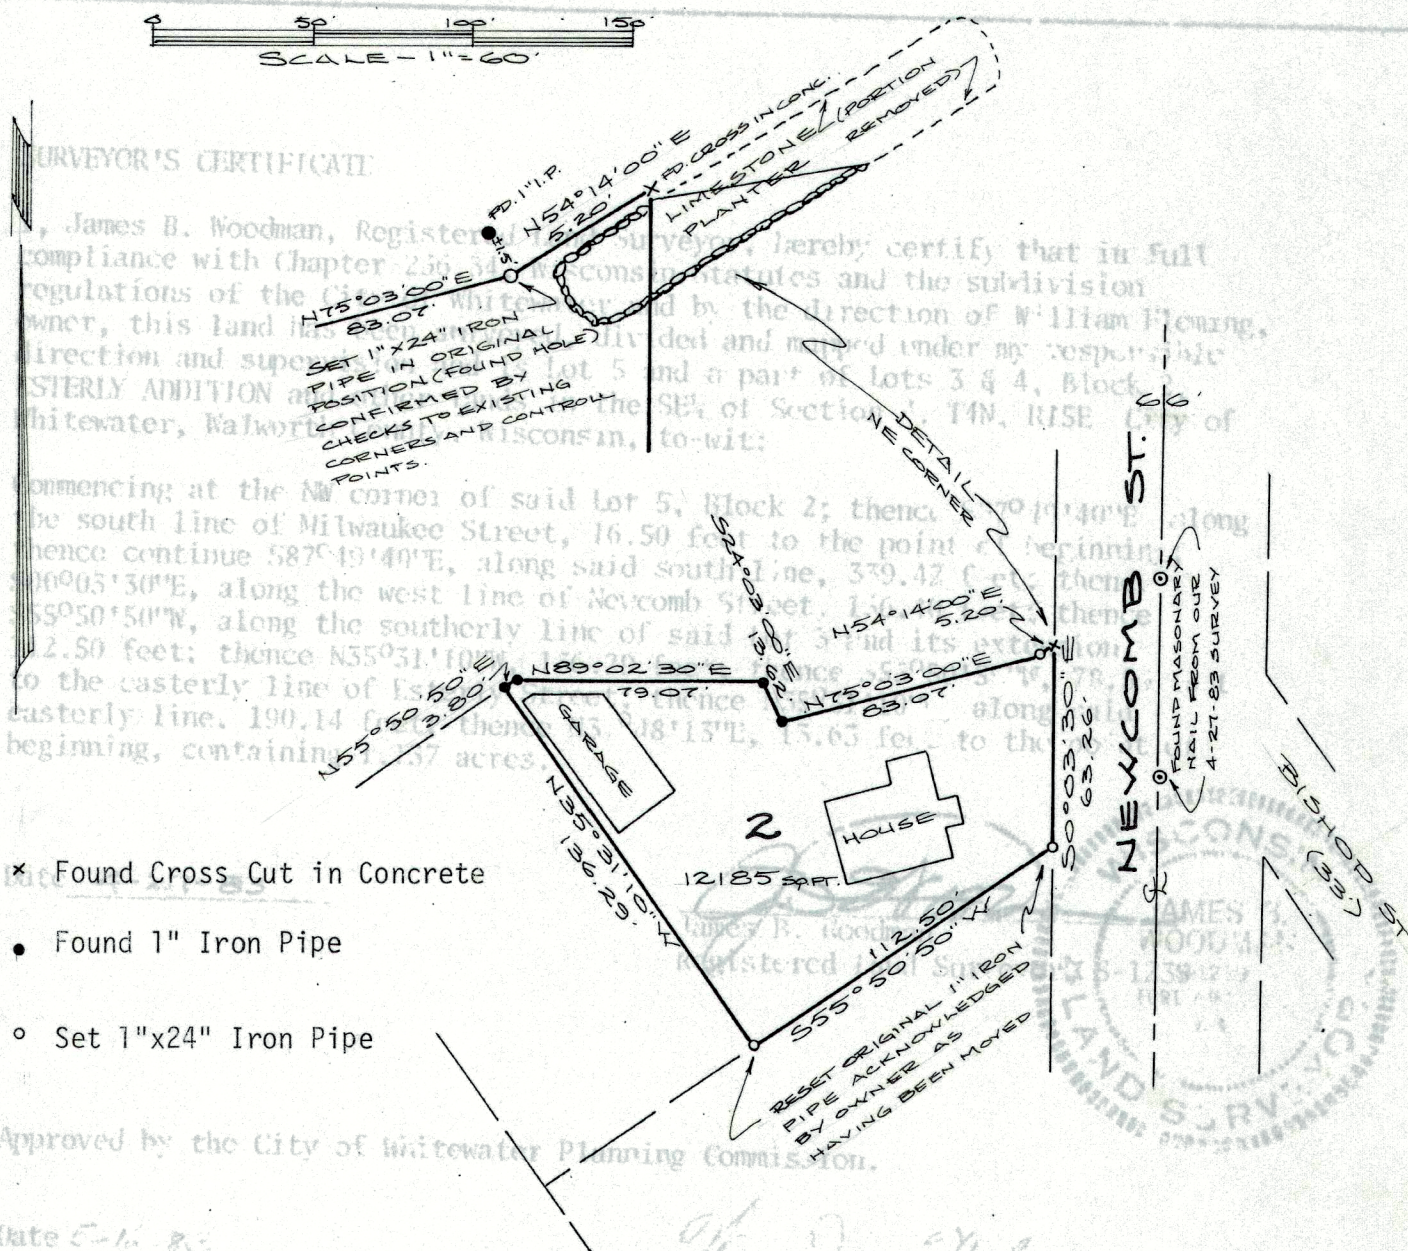

- × Found Cross Cut in Concrete
- Found 1" Iron Pipe
- Set 1"x24" Iron Pipe

Approved by the City of Whitewater Planning Commission.

Date 5-14-82

DESCRIPTION

Lot 2, Certified Survey Map #1274 recorded in Volume pages 54 and 55 in the SE $\frac{1}{4}$ of Section 4, T4N, R15E, City of Whitewater, Walworth County, Wisconsin.

CERTIFICATION


I hereby certify that the property described above has been surveyed under my responsible direction and supervision and that this map is a correct representation of the lot lines and dimensions and the principle lines of the permanent structures thereon.

Date 5-4-89

James B. Woodman
Registered Land Surveyor, S-1229

Prepared for: William Fleming
214 S. Newcomb
Whitewater, WI 53190

JAMES B. WOODMAN &
210 Madison Avenue
Fort Atkinson, WI 53538
(414) 565-8162

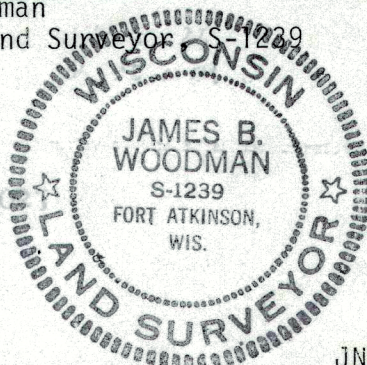

Sheet 1 of 1

JN 83S-23