


SCALE - 1" = 40'

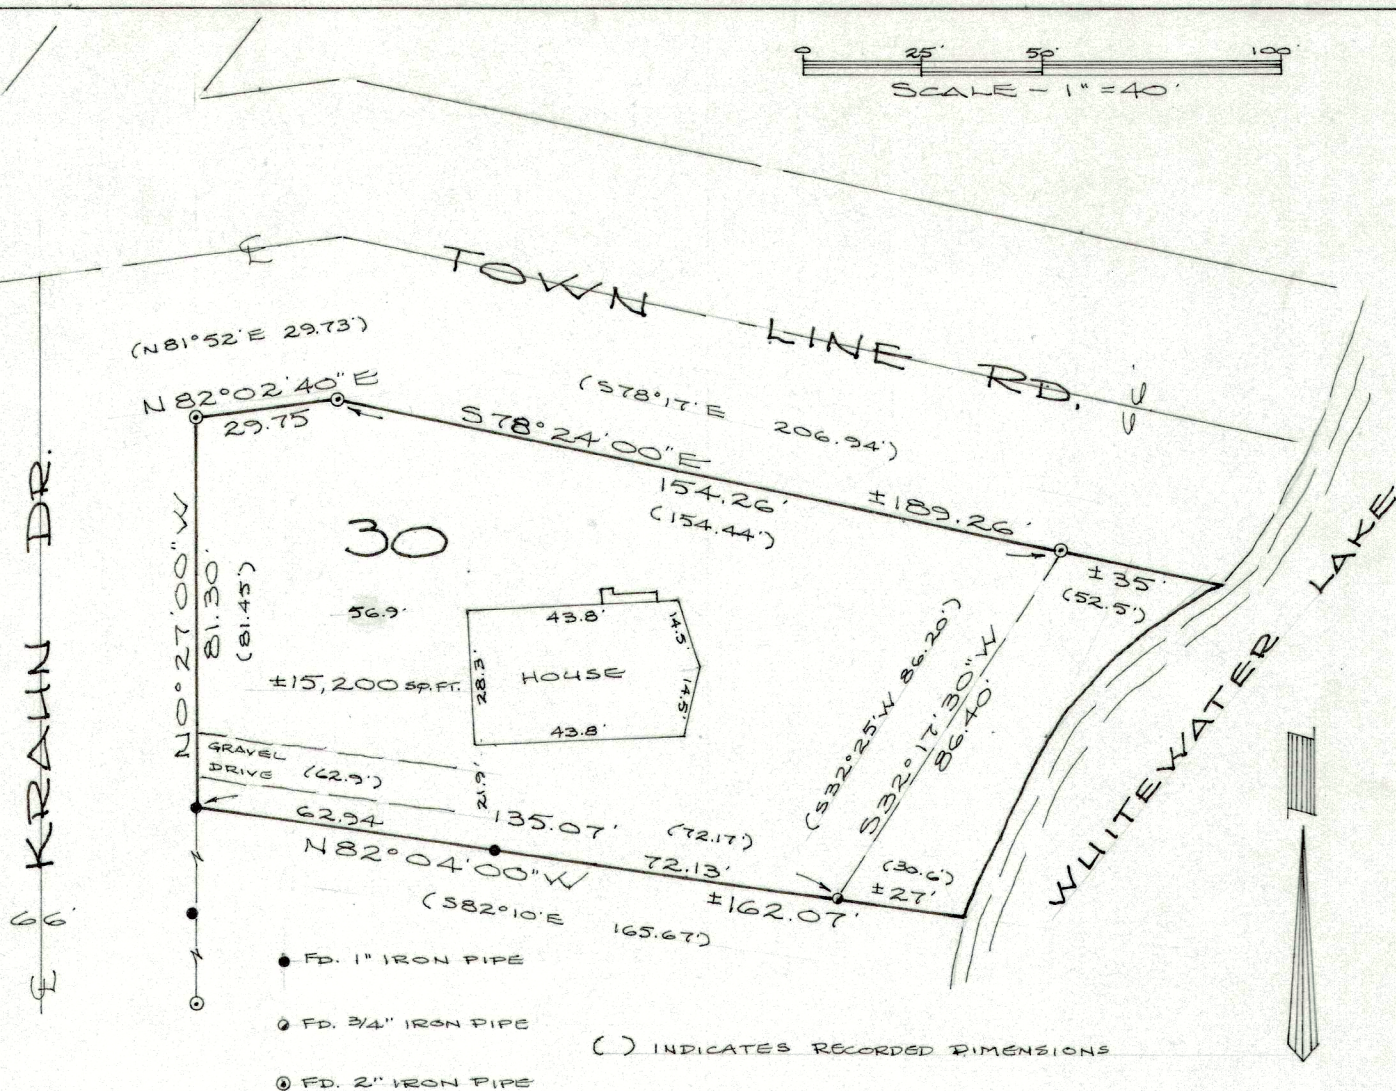

Lot 30, OAK KNOLL, in the SE $\frac{1}{4}$ of SEction 34, T4N, R15E, Town of Whitewater, Walworth County, Wisconsin.

I hereby certify that the property described above has been surveyed under my responsible idrection and supervision and that this map is a correct representation of the lot lines and dimensions and the principle lines of the permanent structures thereon.


James B. Woodman
Registered Land Surveyor, S-1239

Prepared for: Luchini Shelters
RR#2 E. Lake Shore Drive
Whitewater, WI 53190

Sheet 1 of 1

JN 84S-126

JAMES B. WOODMAN & ASSOCIATES
210 Madison Avenue, Fort Atkinson, WI 53538

Registered Land Surveyors
Phone (414) 563-8162