


PLAT OF SURVEY

LEGAL DESCRIPTION:
LANDS LOCATED IN THE SOUTHWEST 1/4 OF THE NORTHEAST 1/4 OF SECTION 4 IN TOWNSHIP 4 NORTH,
RANGE 15 EAST, IN THE CITY OF WHITEWATER, WALWORTH COUNTY, WISCONSIN.

MORE PARTICULARLY DESCRIBED AS:

PARCEL A: THE WEST 32' OF PART OF LOT 3 OF BLOCK 4 OF DANN'S ADDITION OF THE CITY OF WHITEWATER, EXCLUDING THE SOUTH '16'. SAID SUBDIVISION BEING DULY RECORDED IN THE OFFICE OF THE REGISTER OF DEEDS FOR WALWORTH COUNTY IN VOLUME 1, PAGE 29, AND AS DOCUMENT

PARCEL B: THE SOUTH 16' OF THE WEST 32' OF PART OF LOT 3 OF BLOCK 4 OF DANN'S ADDITION OF THE CITY OF WHITEWATER, SAID SUBDIVISION BEING DULY RECORDED IN THE OFFICE OF THE REGISTER OF DEEDS FOR WALWORTH COUNTY IN VOLUME 1, PAGE 29, AND AS DOCUMENT P597598

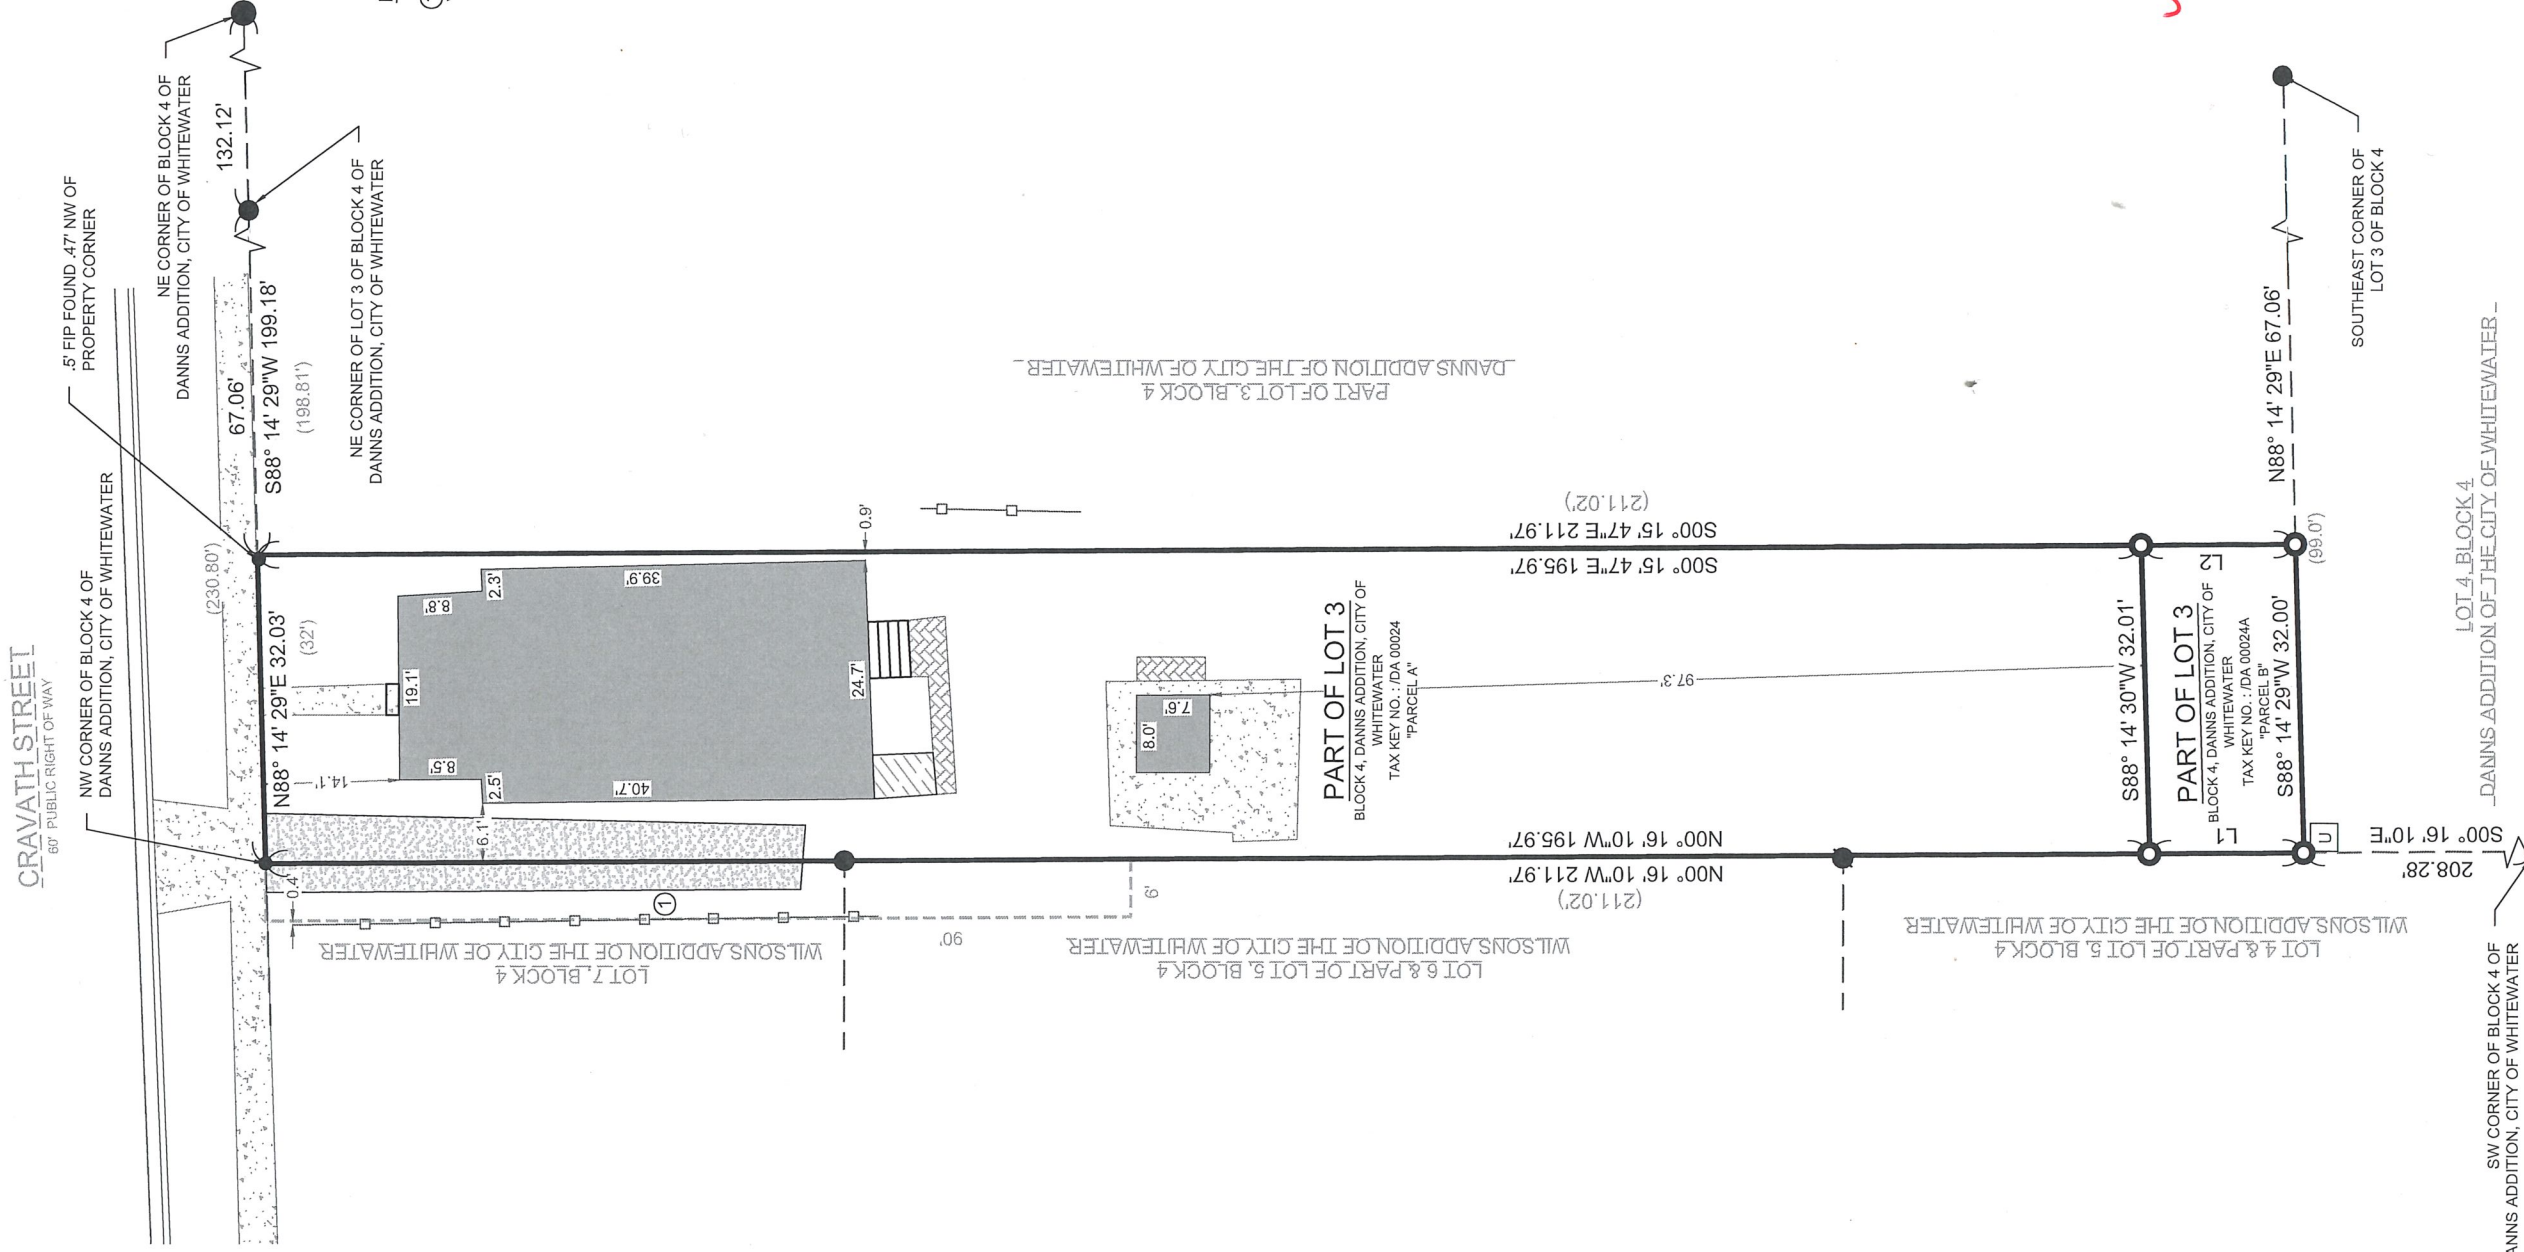


LEGAL DESCRIPTION:

LANDS LOCATED IN THE SOUTHWEST 1/4 OF THE NORTHEAST 1/4 OF SECTION 4 IN TOWNSHIP 4 NORTH, RANGE 15 EAST, IN THE CITY OF WHITEWATER, WALLWORTH COUNTY, WISCONSIN.

MORE PARTICULARLY DESCRIBED AS:

PARCEL A: THE WEST 32' OF PART OF LOT 3 OF BLOCK 4 OF DANN'S ADDITION OF THE CITY OF WHITEWATER, EXCLUDING THE SOUTH '16'. SAID SUBDIVISION BEING DULY RECORDED IN THE OFFICE OF THE REGISTER OF DEEDS FOR WALWORTH COUNTY IN VOLUME 1, PAGE 29, AND AS DOCUMENT

PARCEL B: THE SOUTH 16' OF THE WEST 32' OF PART OF LOT 3 OF BLOCK 4 OF DANN'S ADDITION OF THE CITY OF WHITEWATER, SAID SUBDIVISION BEING DULY RECORDED IN THE OFFICE OF THE REGISTER OF DEEDS FOR WALWORTH COUNTY IN VOLUME 1, PAGE 29, AND AS DOCUMENT P597598

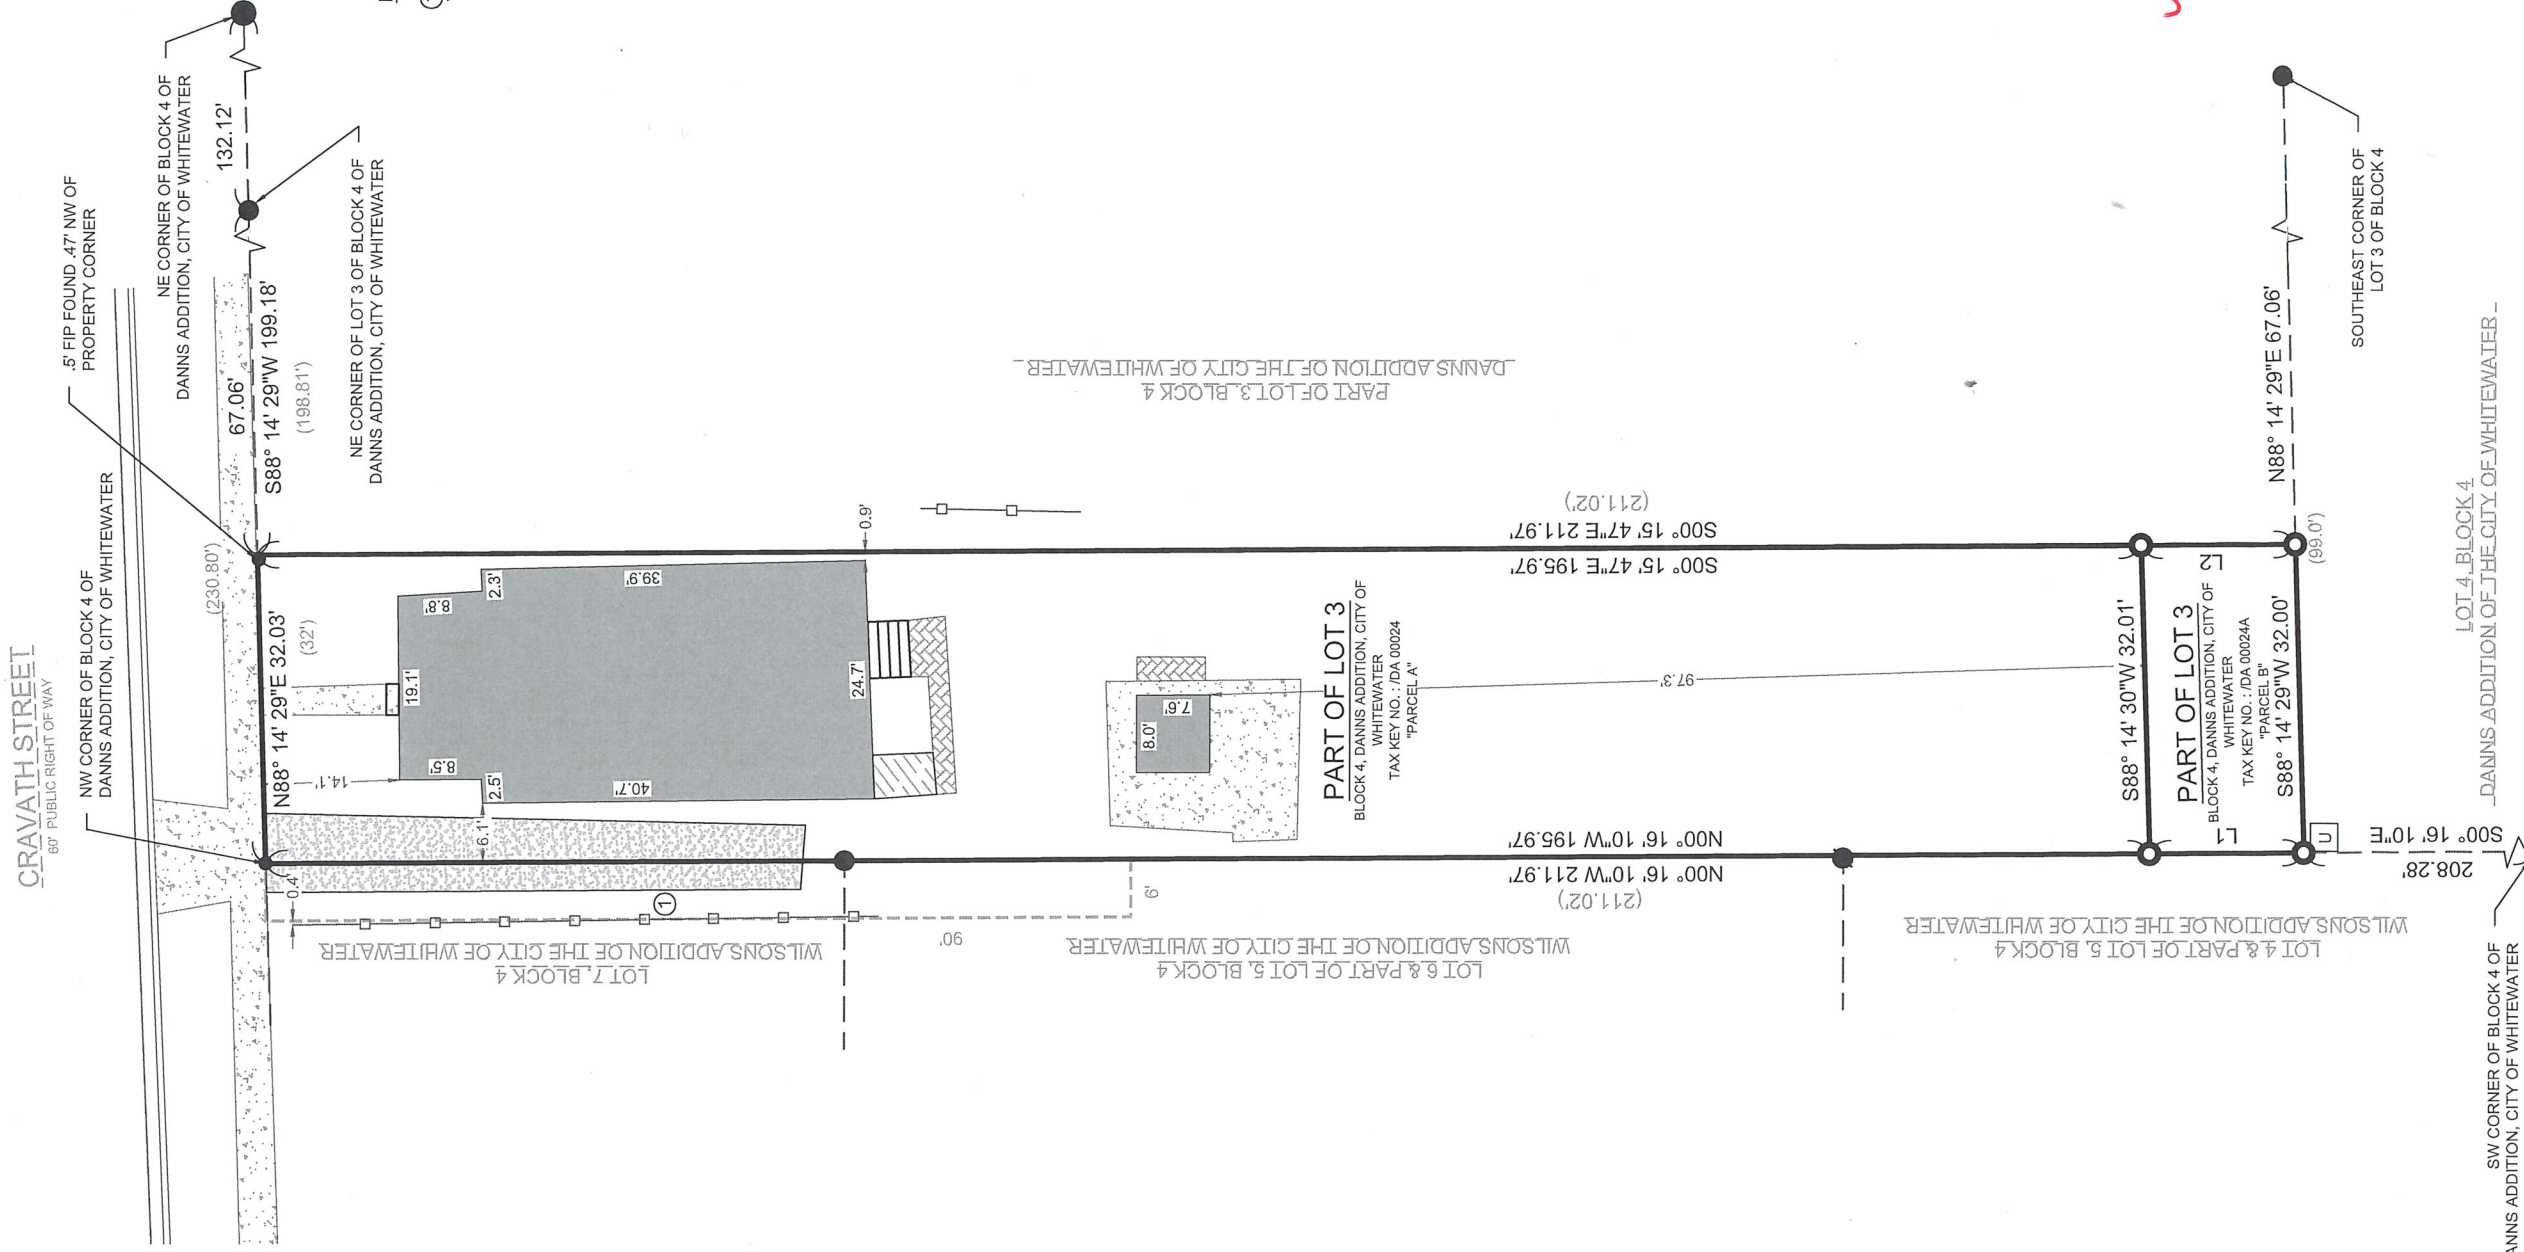

SW CORNER OF BLOCK 4 OF
ANN'S ADDITION, CITY OF WHITEWATER

LOT 4, BLOCK 4
DANNS ADDITION OF THE CITY OF WHITEWATER

G:\Shared drives\2021-2025 Projects\2025\25145 - 219 E. Cravath St Whitewater\DWG\BASE\25145P.dwg

PLOTTED: 4/8/2025 11:40:01 AM


LEGAL DESCRIPTION:

LANDS LOCATED IN THE SOUTHWEST 1/4 OF THE NORTHEAST 1/4 OF SECTION 4 IN TOWNSHIP 4 NORTH, RANGE 15 EAST, IN THE CITY OF WHITEWATER, WALLWORTH COUNTY, WISCONSIN.

MORE PARTICULARLY DESCRIBED AS:

PARCEL A: THE WEST 32' OF PART OF LOT 3 OF BLOCK 4 OF DANN'S ADDITION OF THE CITY OF WHITEWATER, EXCLUDING THE SOUTH '16'. SAID SUBDIVISION BEING DULY RECORDED IN THE OFFICE OF THE REGISTER OF DEEDS FOR WALWORTH COUNTY IN VOLUME 1, PAGE 29, AND AS DOCUMENT

PARCEL B: THE SOUTH 16' OF THE WEST 32' OF PART OF LOT 3 OF BLOCK 4 OF DANN'S ADDITION OF THE CITY OF WHITEWATER, SAID SUBDIVISION BEING DULY RECORDED IN THE OFFICE OF THE REGISTER OF DEEDS FOR WALWORTH COUNTY IN VOLUME 1, PAGE 29, AND AS DOCUMENT P597598

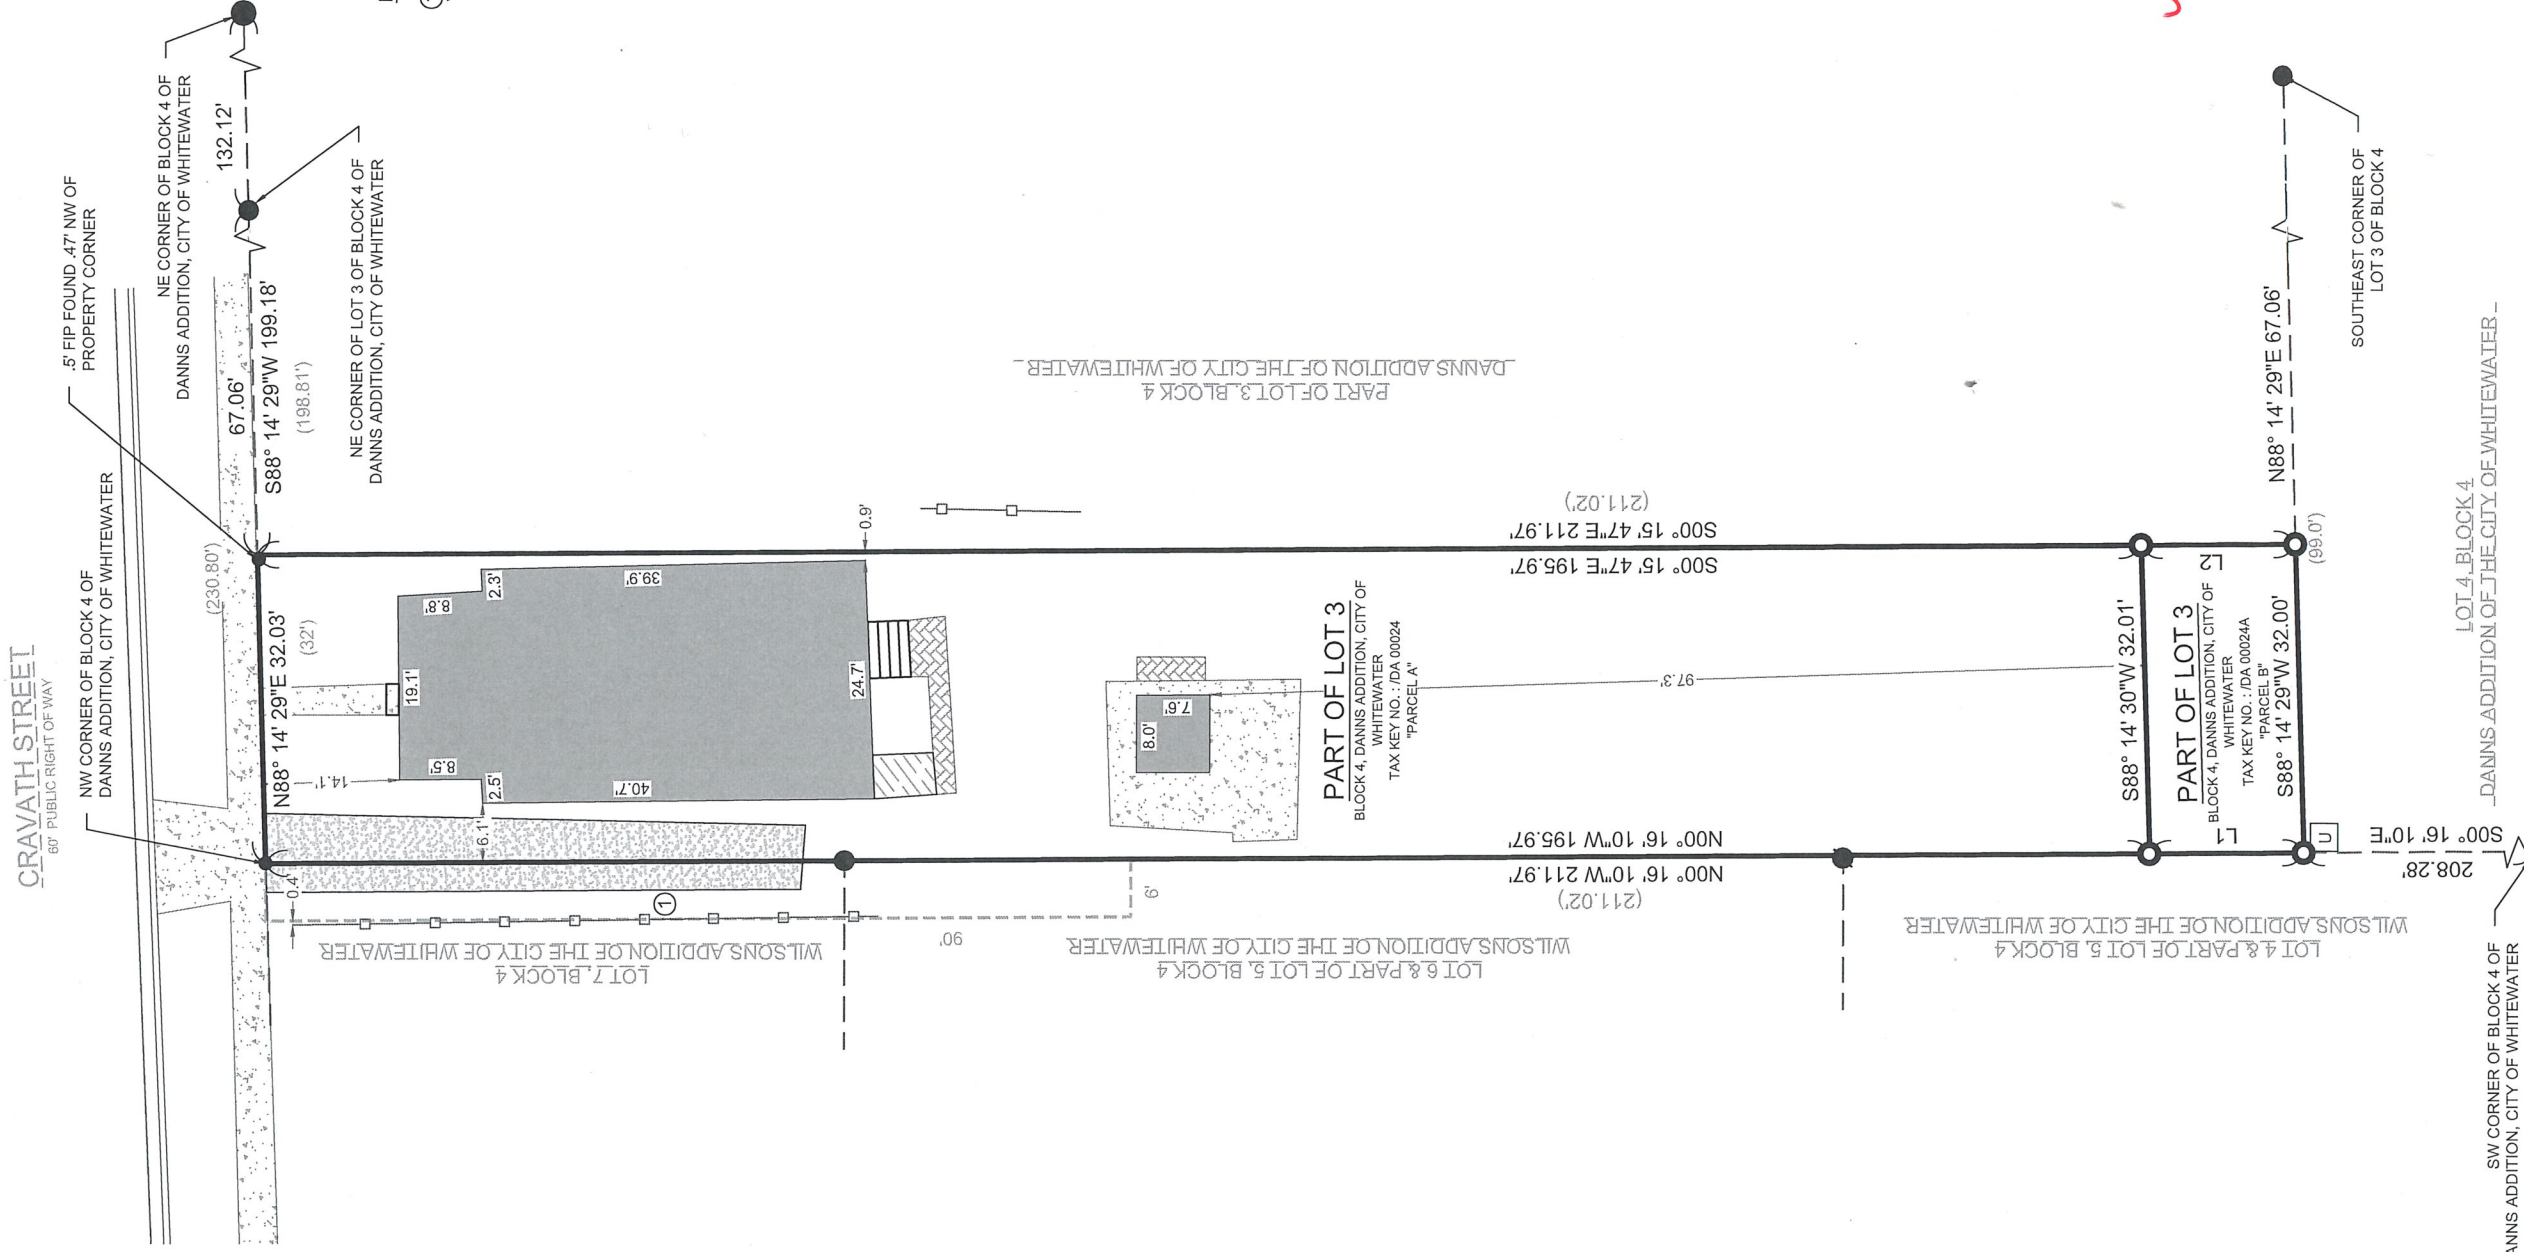

SW CORNER OF BLOCK 4 OF
ANN'S ADDITION, CITY OF WHITEWATER

LOT 4, BLOCK 4
DANNS ADDITION OF THE CITY OF WHITEWATER

G:\Shared drives\2021-2025 Projects\2025\25145 - 219 E. Cravath St Whitewater\DWG\BASE\25145P.dwg

PLOTTED: 4/8/2025 11:40:01 AM