



# PLAT OF SURVEY

BEING ALL OF LOT 31 AND LOT 32 OF THE RE-PLAT OF MOUND MEADOWS,  
 LOCATED IN THE NW 1/4 AND NE 1/4 OF THE SE 1/4,  
 SECTION 6, TOWNSHIP 4 NORTH, RANGE 15 EAST,  
 CITY OF WHITEWATER, WALWORTH COUNTY, WISCONSIN

**SURVEYOR:**  
 KEITH A. KINDRED, RLS S-2082  
 SEH  
 501 MAPLE AVE  
 DELAFIELD, WI 53018  
 (414) 949-8919  
 K KINDRED@SEHINC.COM

**SURVEY FOR:**  
 U.S. SHELTER HOMES LLC  
 31632 NORTH ELLIS DRIVE, UNIT 213  
 VOLO, ILLINOIS, 60073

LOT 1  
 CSM 3014

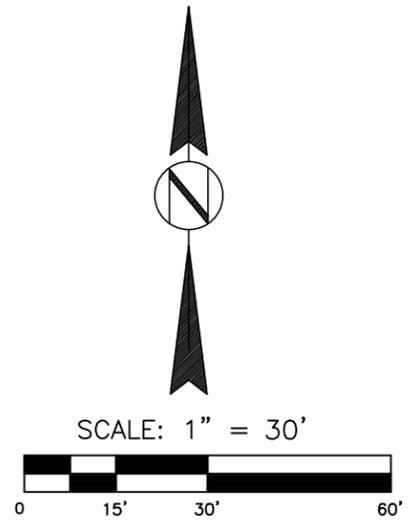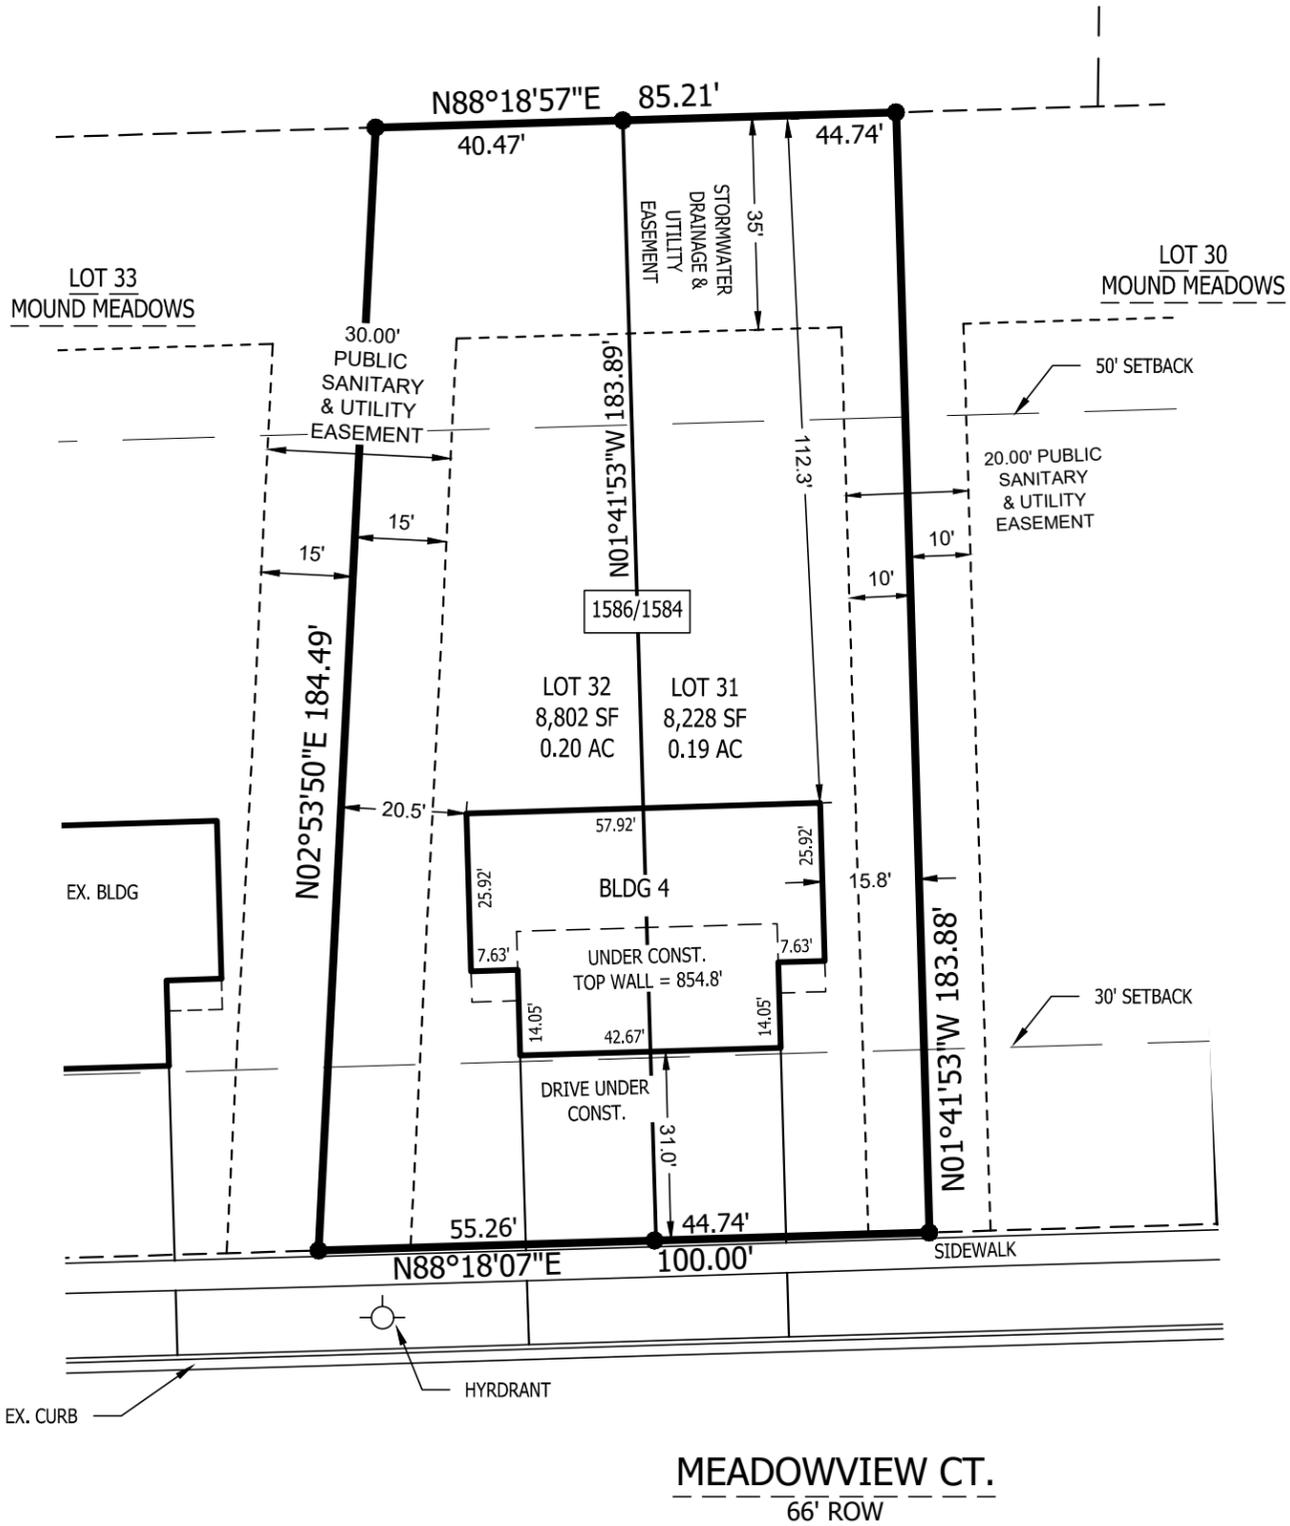

- LEGEND**
- - 11/16" REBAR FOUND
  - ☐/○ - STORM INLET
  - (S) - MANHOLE
  - x xxx.x - EX. GROUND ELEV. AS OF DATE OF SURVEY
  - ⊕ - BENCHMARK (AS NOTED)
  - x [xxx.xx] - TOP OF STAKE ELEV. OR BENCHMARK ELEV.



SEPTEMBER 26, 2024

**SURVEYOR'S CERTIFICATE:**

I HEREBY CERTIFY THAT I HAVE SURVEYED THE ABOVE DESCRIBED PROPERTY AND THAT THE ABOVE MAP IS A TRUE REPRESENTATION THEREOF AND SHOWS THE SIZE AND LOCATION OF THE PROPERTY, ITS EXTERIOR BOUNDARIES, THE LOCATION OF ALL VISIBLE STRUCTURES AND DIMENSIONS OF ALL PRINCIPAL BUILDINGS THEREON, BOUNDARY FENCES, APPARENT EASEMENTS, ROADWAYS, AND VISIBLE ENCROACHMENTS, IF ANY.

THIS SURVEY IS MADE FOR THE USE OF THE PRESENT OWNERS OF THE PROPERTY, AND ALSO THOSE WHO PURCHASE, MORTGAGE, OR GUARANTEE THE TITLE THERETO WITHIN ONE (1) YEAR FROM DATE HEREOF.

SEH  
 PHONE: 262.646.6855  
 501 MAPLE AVENUE  
 DELAFIELD, WI 53018  
 www.sehinc.com