


PLAT OF SURVEY

LOTS 13, 14, 15, 16, 17, 18 OF STRITZEL SUBDIVISION,
LOCATED IN PART OF NORTHEAST 1/4 OF SECTION 4,
TOWN 4 NORTH, RANGE 15 EAST, CITY OF WHITEWATER,
WALWORTH COUNTY, WISCONSIN.

OWNERS:
RYAN STRITZEL
DEANN STRITZEL
W7262 HWY 12
WHITEWATER, WI 53190


NOTE:

ONLY THE BOUNDARY WAS SURVEYED AS
PER OWNERS INSTRUCTIONS. UTILITIES
AND FENCES WERE NOT LOCATED.

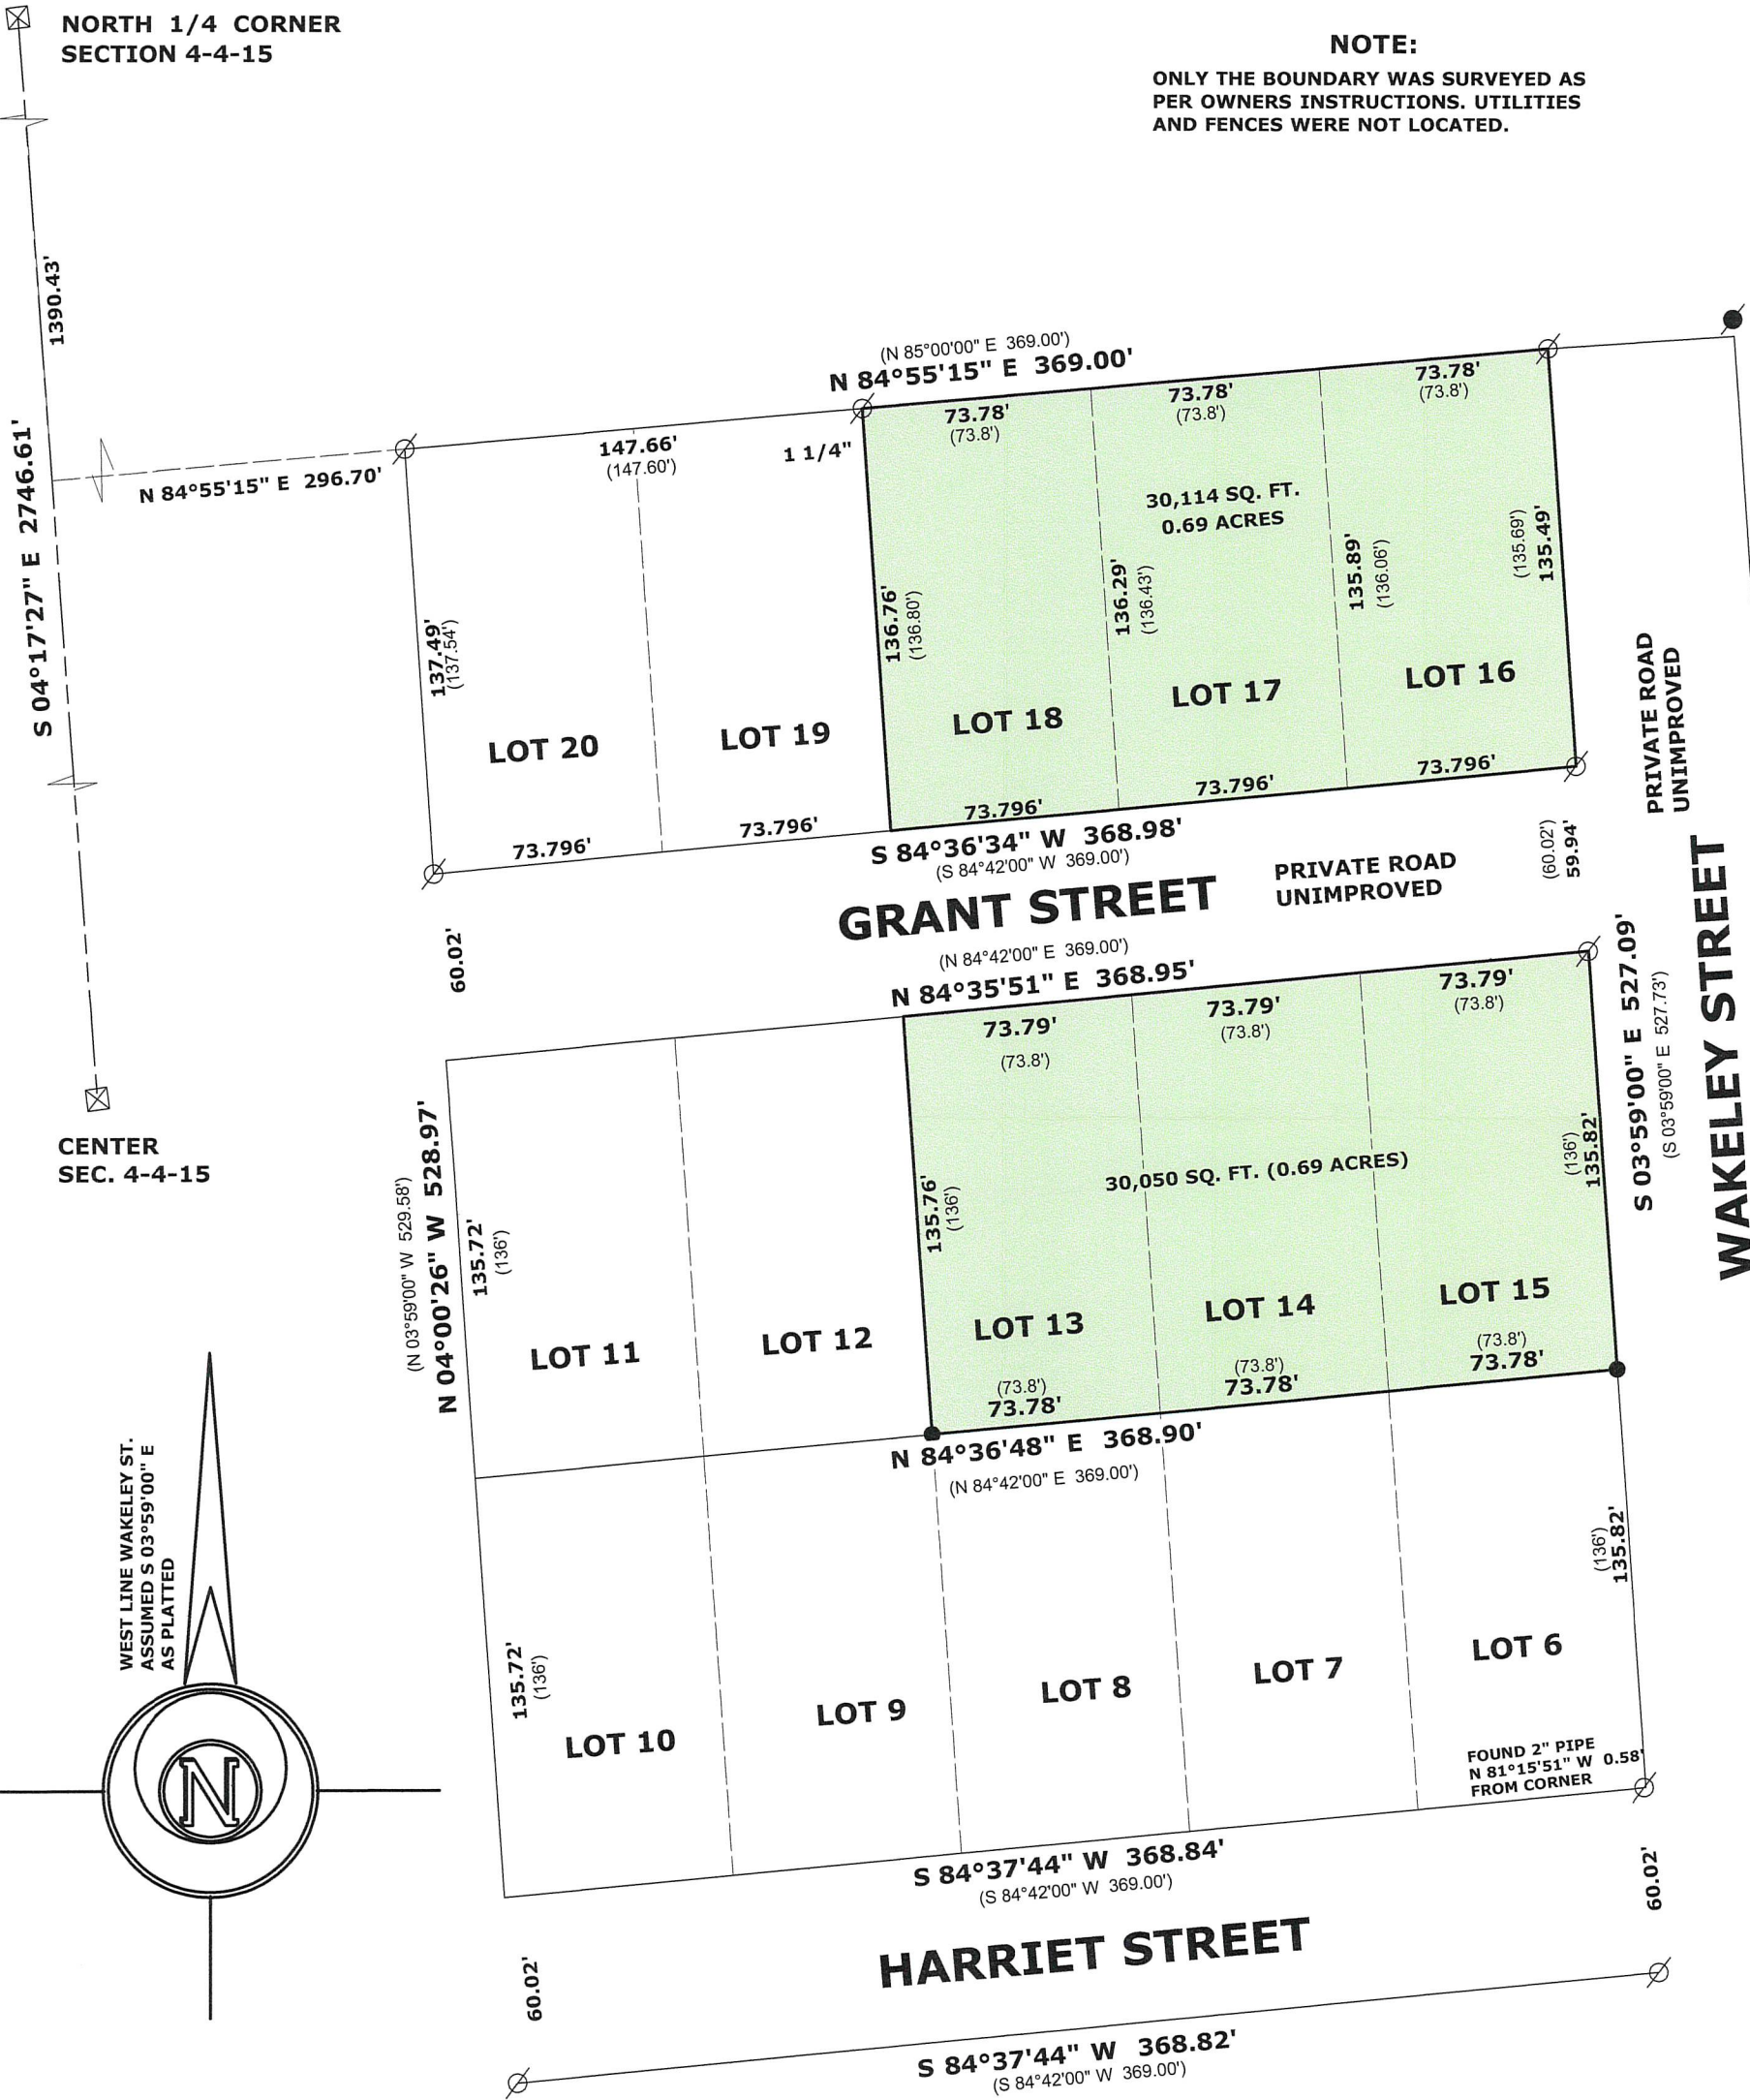

CENTER
SEC. 4-4-15

WEST LINE WAKELEY ST.
ASSUMED S 03°59'00" E
AS PLATTED

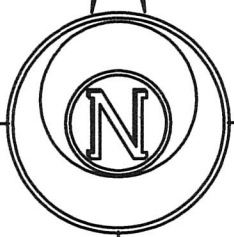

SCALE: 1 INCH = 60 FEET

"I hereby certify that the above described property
has been surveyed by me or under my direction in
full compliance with the owner's/agent's instructions
that the above map is correct to the best of my
knowledge and belief."

Mark L. Miritz
MARK L. MIRITZ
WISCONSIN PROFESSIONAL
LAND SURVEYOR S-2582

DATE: DEC. 18, 2025 JOB NO. 25.901



LEGEND

- FOUND IRON PIPE 2"
- FOUND IRON ROD 3/4"
- FOUND COUNTY MONUMENT
- SET IRON ROD, 18" LONG, WEIGHING 1.5 LBS./LINEAL FT., 3/4" DIA.
- RECORDED AS DIMENSION

ISS 14 thru 18 010-1196