

LAND-MARK SURVEYING

Mark L. Mirtz
Wisconsin Professional Land Surveyor S-2582

N9330 Knuteson Drive
Whitewater, WI 53190
Phone: (262) 949-1239
MARKMIRITZ@
LAND-MARKSURVEYING.COM


PLAT OF SURVEY

LOT 6, BLOCK 3 OF S.C. HALL'S ADDITION TO THE VILLAGE (NOW CITY)
OF WHITEWATER, WALWORTH COUNTY, WISCONSIN


OWNER:
MICHELLE I BUCHOLTZ
934 E. MAIN STREET
WHITEWATER, WI 53190

SURVEYOR'S NOTES:

THIS SURVEY RETRACES A SURVEY BY JAMES K. LANGONE DATED
JAN. 20, 2003. SUSPECT RECENT RECONSTRUCTION OF EAST MAIN
STREET REMOVED OR DISTURBED EXISTING IRON.

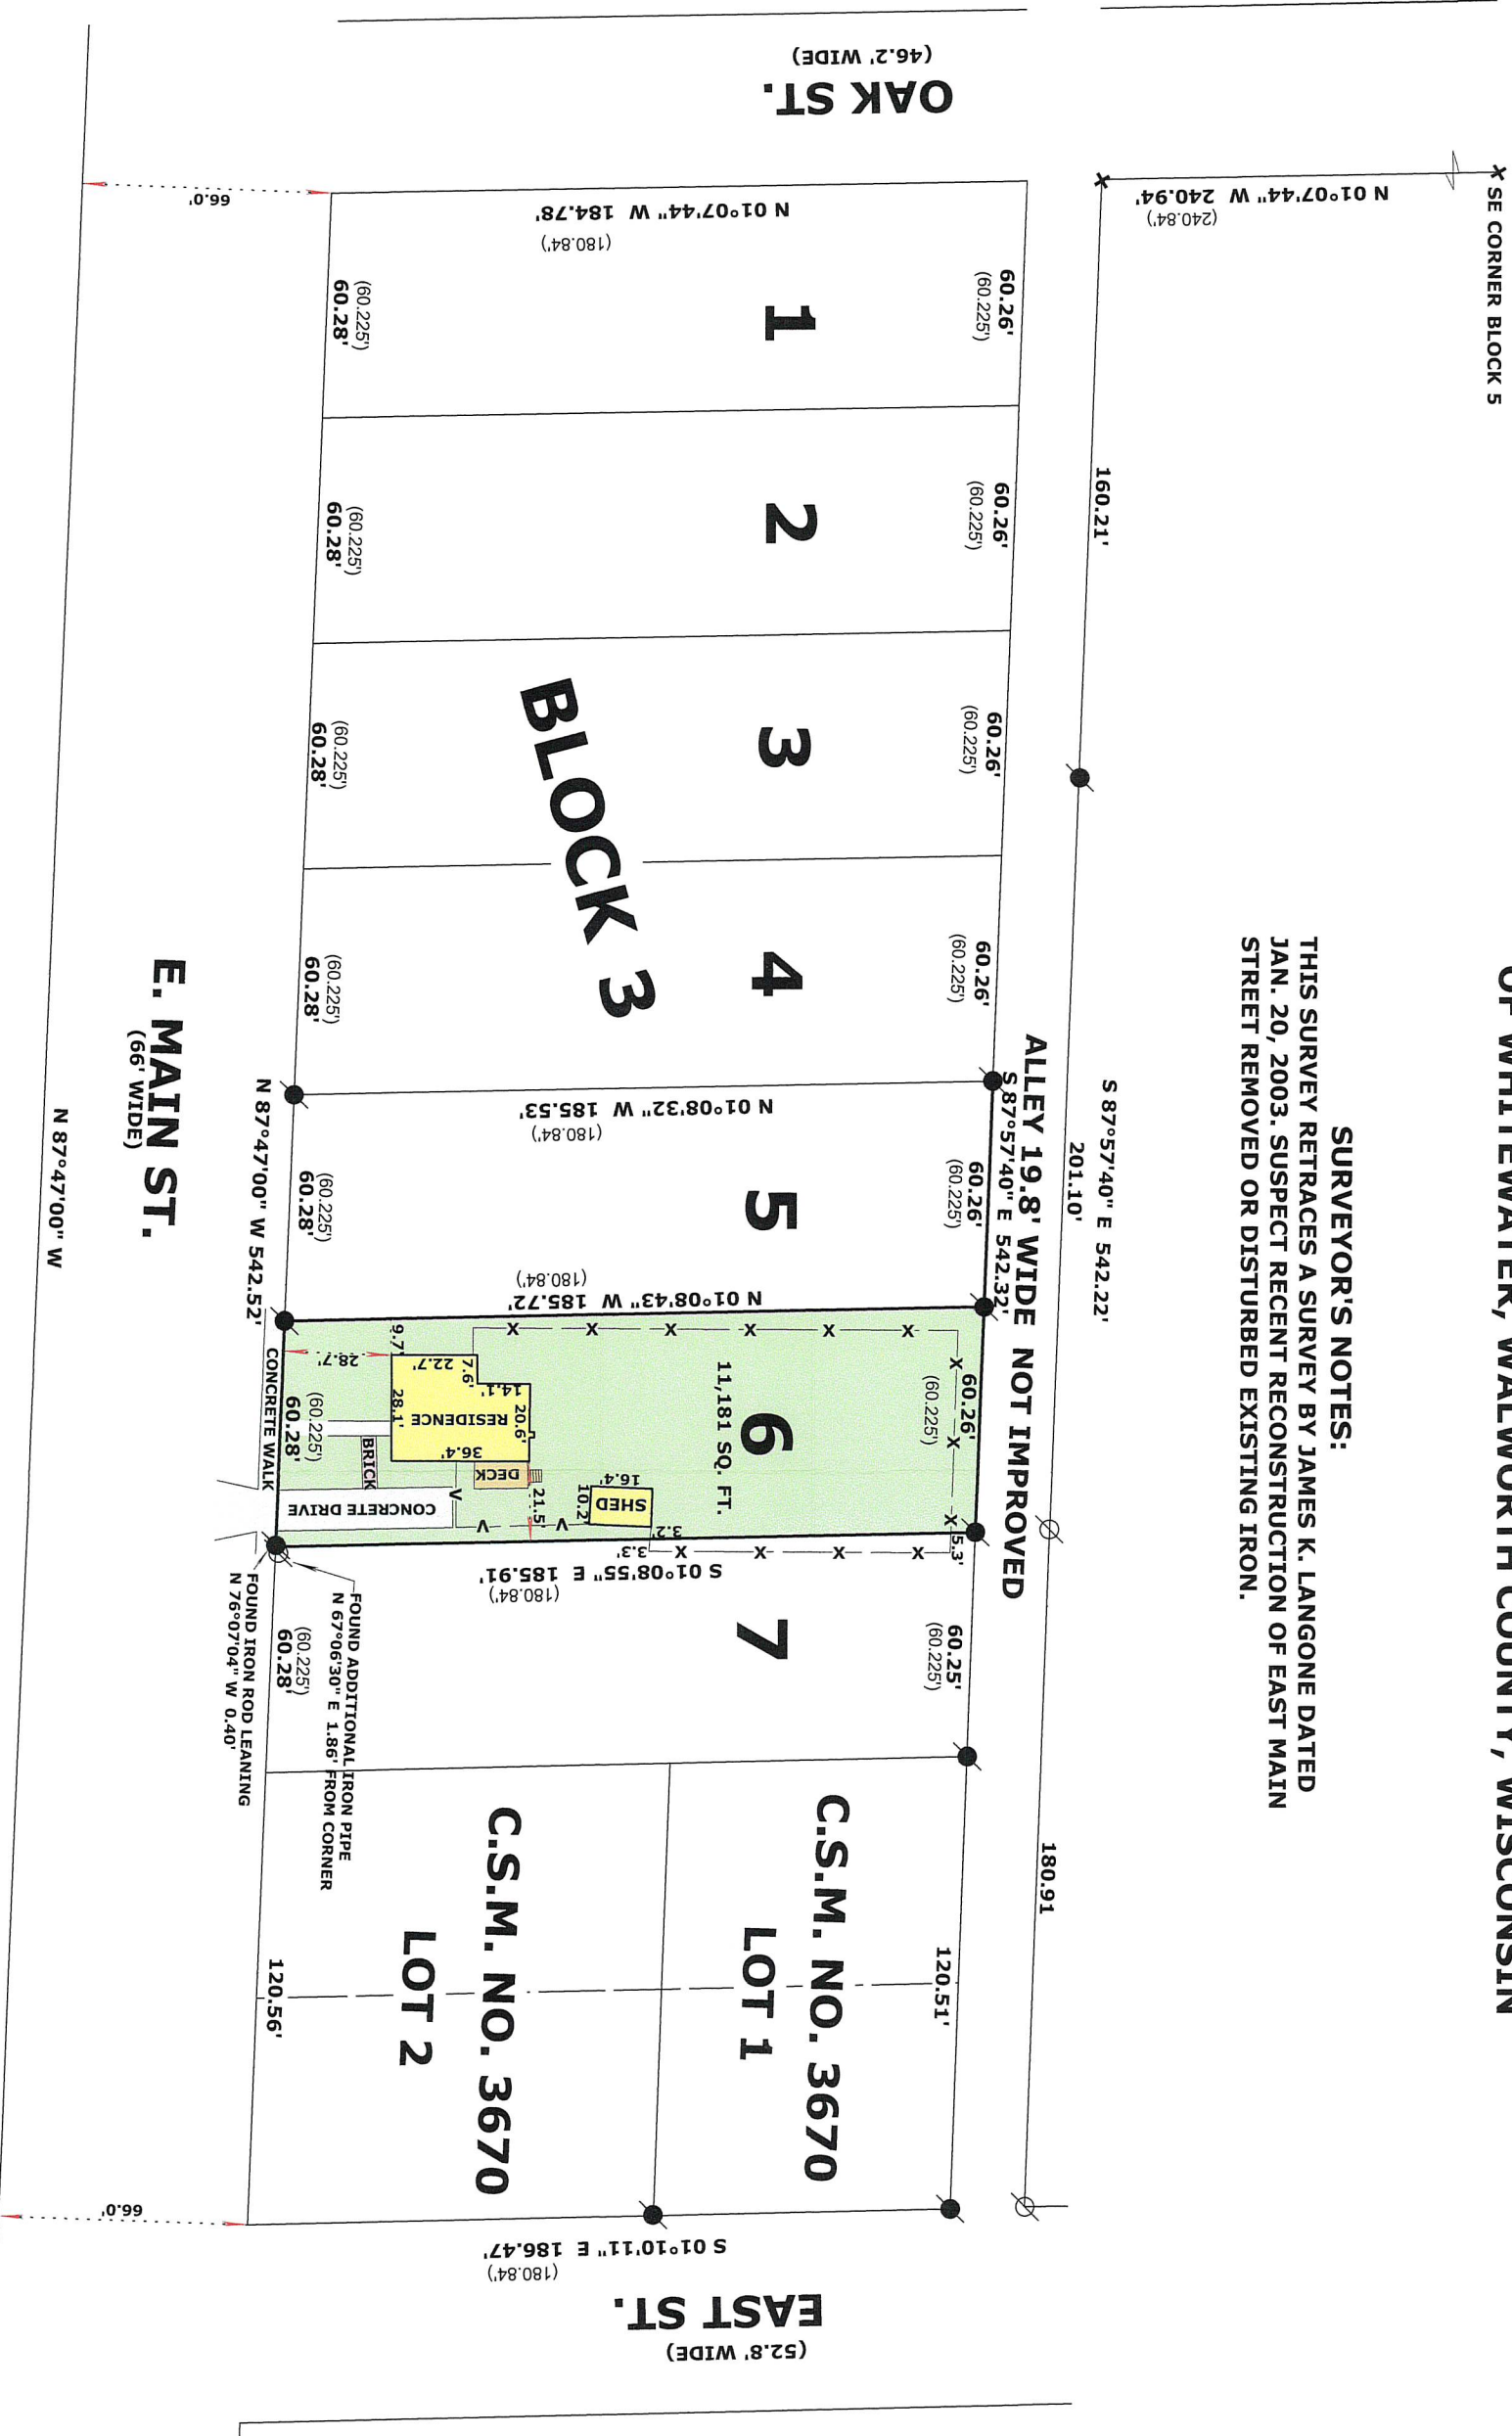

Horizontal Datum is based on the Wisconsin State Plane Coordinate System Grid, South Zone, North American Datum of 1983/2011, all bearings are referred to Grid North.

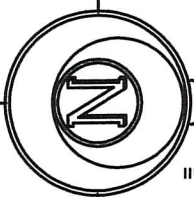

LEGEND

- X- CHAIN LINK FENCE
- VINYL FENCE
Ø FOUND IRON PIPE
+ FOUND IRON ROD
(x x) CHISEL CUT IN CONCRETE
(x x) RECORDED AS DIMENSION

SCALE: 1 INCH = 50 FEET

"I hereby certify that the above described property has been surveyed by me or under my direction and that the above map is a true representation thereof and shows the size and location of the property, its exterior boundaries, the location of all visible structures and dimensions of all principal buildings thereon, boundary fences, apparent easements, roadways and visible encroachments, if any. This survey is made for the use of the present owners of the property, and also those who purchase, mortgage, or guarantee the title thereto within one year from date hereof."

Mark L. Mirtz
MARK L. MIRITZ
WISCONSIN PROFESSIONAL
LAND SURVEYOR S-2582

DATE: NOVEMBER 1, 2025 JOB NO. 25.1001

STATE OF WI DEPT. OF TRANSPORTATION

RAIL ROAD RIGHT OF WAY 66' WIDE

N 87°47'00" W

HAAS-23

DID-1198