


07-13 DT-14, 07-15



DRAWN BY GBW		SCALE 1" = 5'	
CHECKED BY JENSEN & JOHNSON		REVISION	
APPROVED BY JENSEN & JOHNSON		SHEET NO. 1 OF 1	
DATE MARCH 12, 1966			

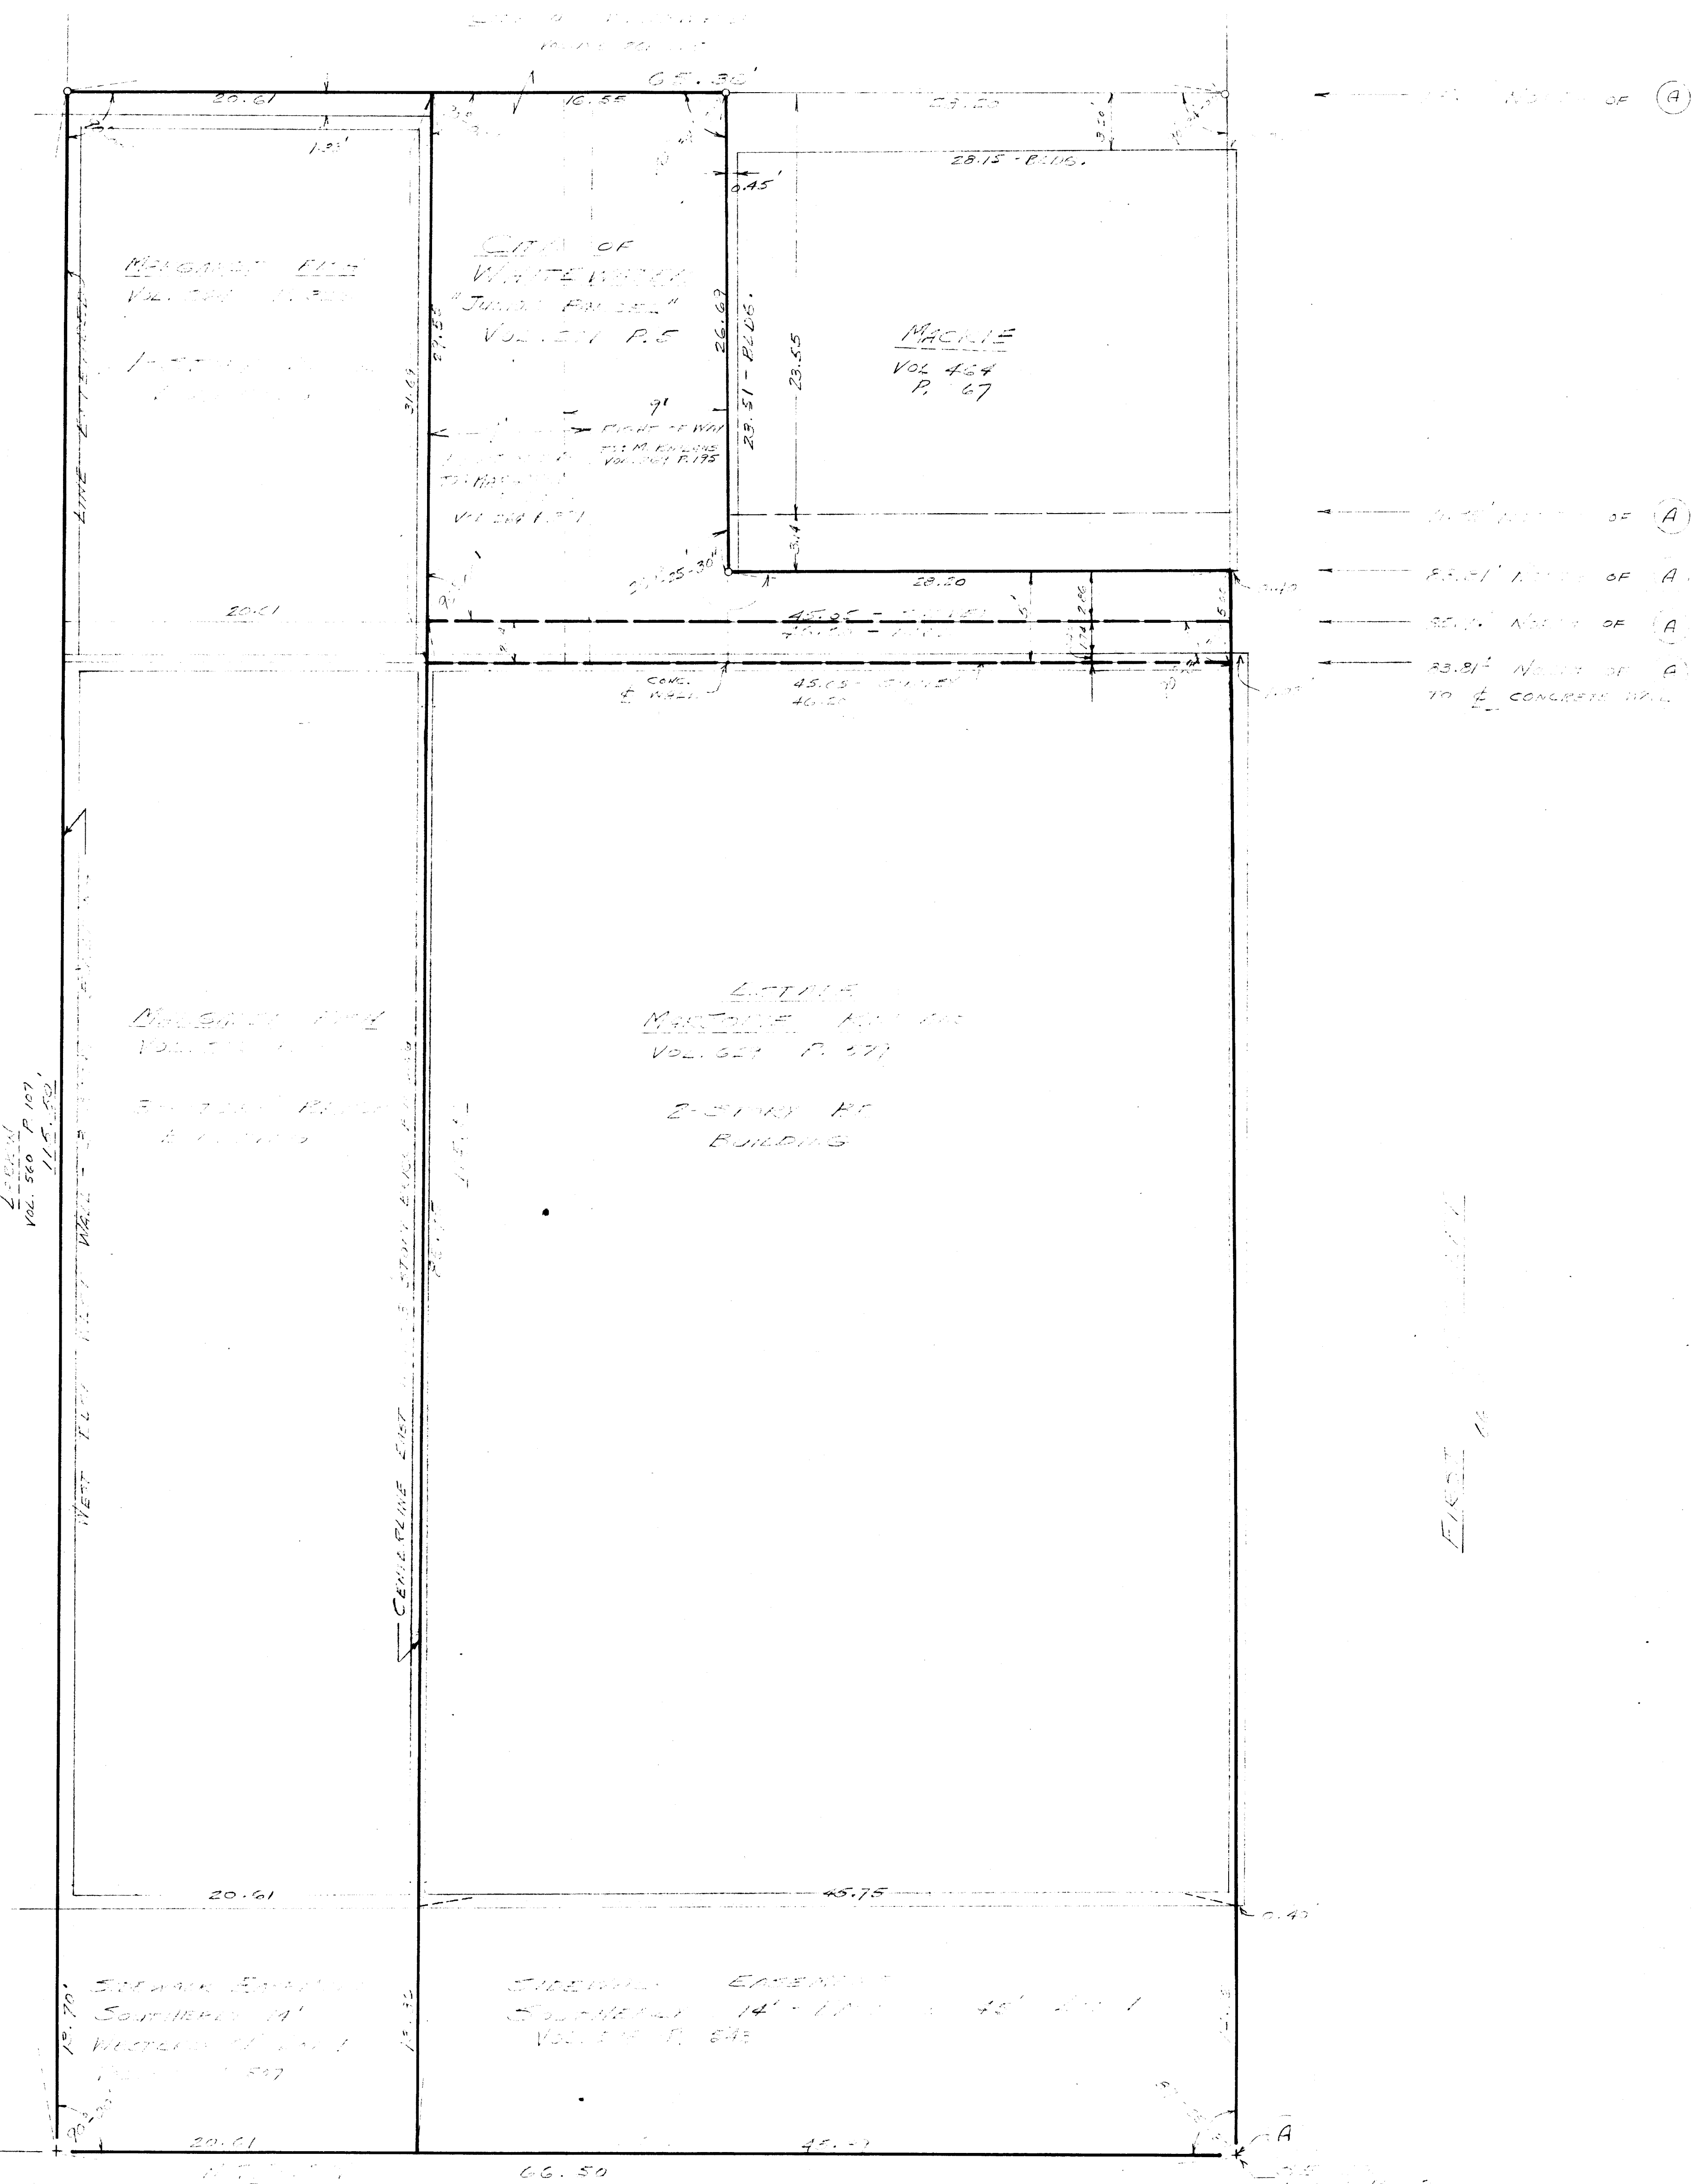

LEGEND
+ - CHISEL MARK IN SIDEWALK
O - IRON PIPE