


HAROLD H. KOLB

REGISTERED PROFESSIONAL LAND SURVEYOR (3152-1151K)
LAKE GENEVA, WISCONSIN

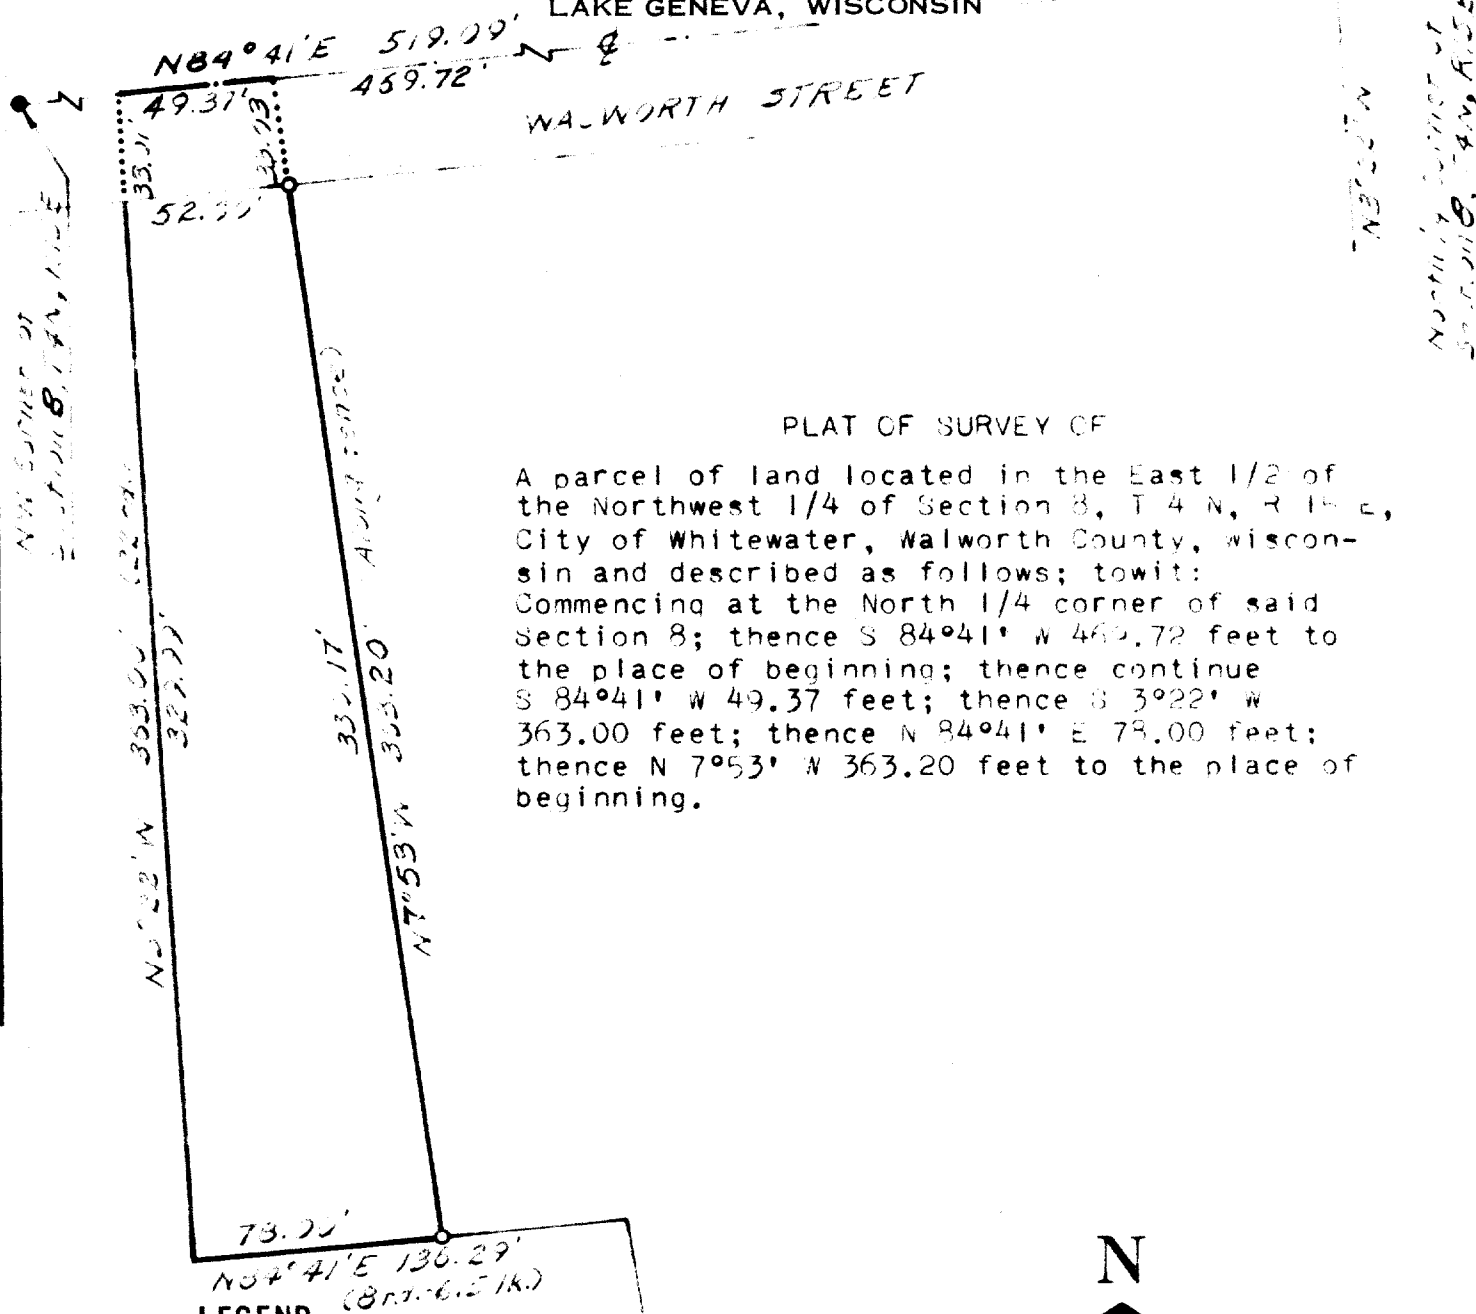


PLAT OF SURVEY OF

A parcel of land located in the East 1/2 of the Northwest 1/4 of Section 8, T4N, R15E, City of Whitewater, Walworth County, Wisconsin and described as follows; to wit: Commencing at the North 1/4 corner of said Section 8; thence S 84°41' W 469.72 feet to the place of beginning; thence continue S 84°41' W 49.37 feet; thence S 3°22' W 363.00 feet; thence N 84°41' E 78.00 feet; thence N 7°53' W 363.20 feet to the place of beginning.

LEGEND

- ⊗ — IRON PIPE FOUND
- — IRON PIPE PLACED
- — CONCRETE MONUMENT FOUND
- () — AS RECORDED

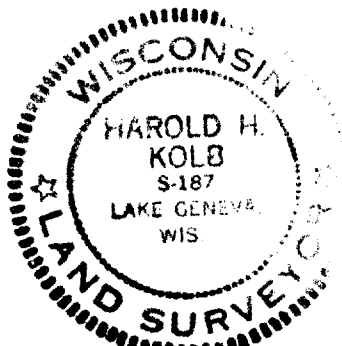

N

SCALE 1" = 60'

I, HAROLD H. KOLB, DO HEREBY CERTIFY THAT I HAVE SURVEYED THE PROPERTY HEREON DESCRIBED ACCORDING TO THE OFFICIAL RECORDS, AND THAT THE PLAT HEREON IS A CORRECT REPRESENTATION OF THE LOT LINES.

Harold H. Kolb

HAROLD H. KOLB

WISCONSIN REGISTERED LAND SURVEYOR, S-187

DATE: April 5, 1968

CC 1 C. 2. 712 (part of 1)
WWD 314F

10-125