


JEFFERSON ST. 60' WIDE

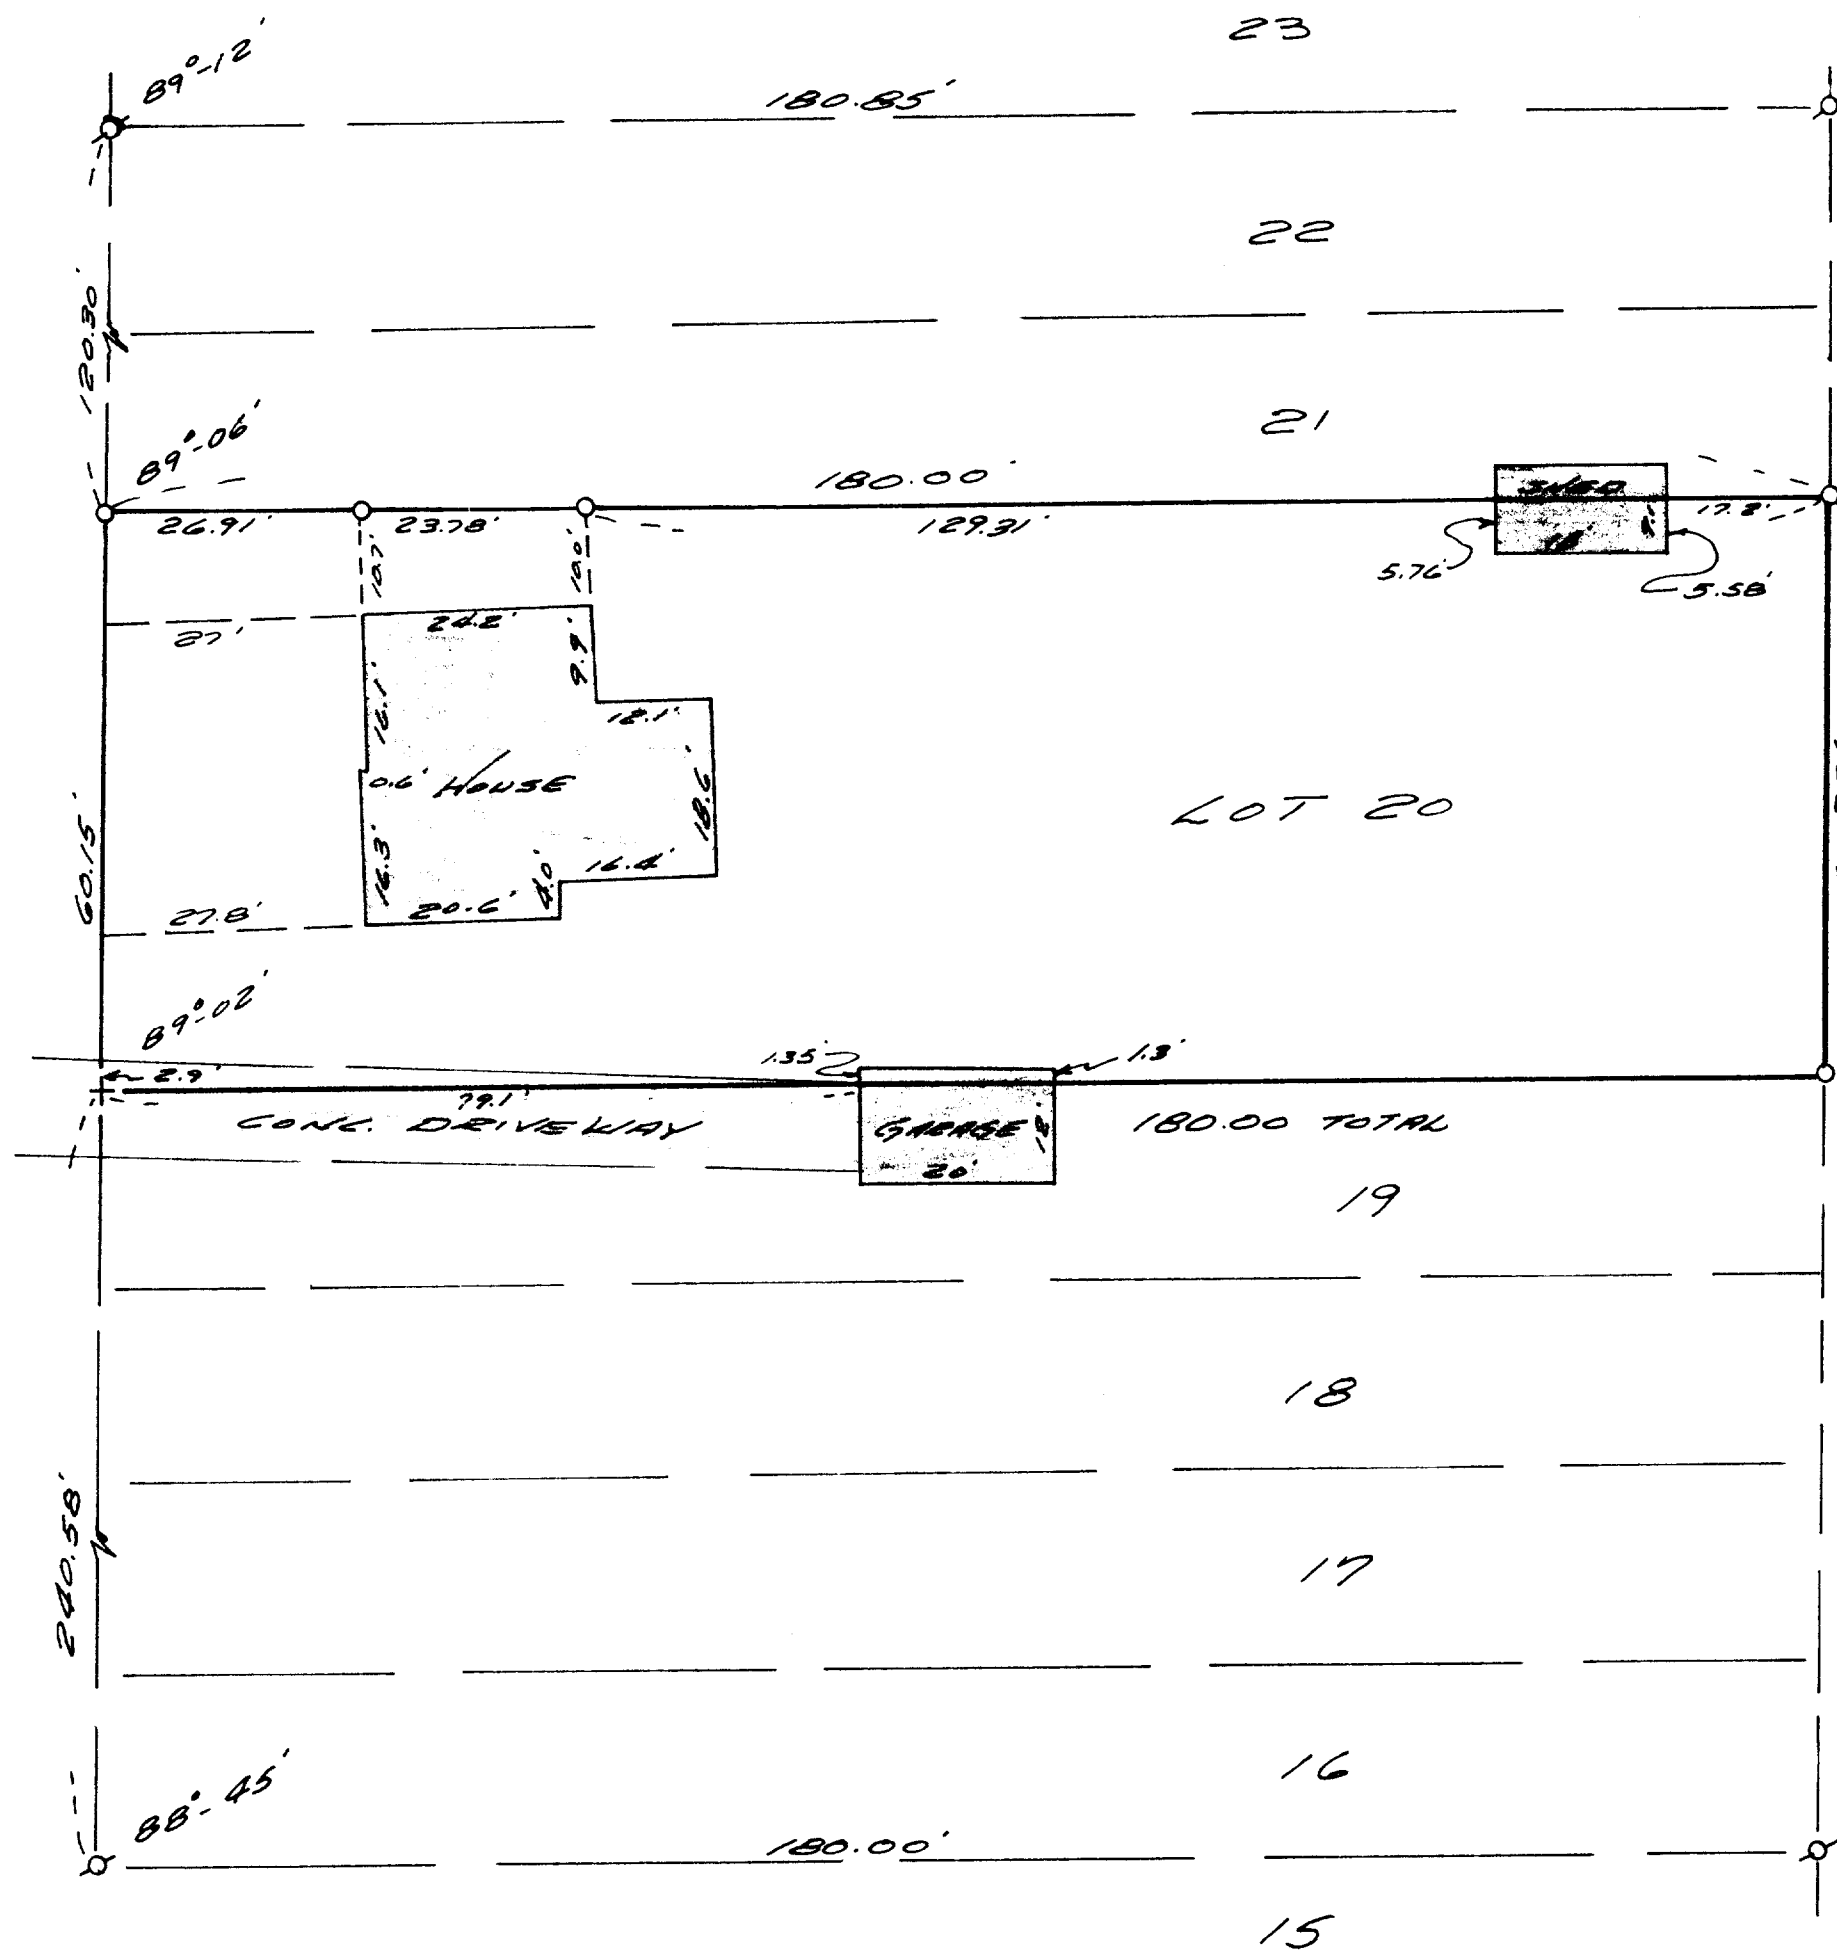

S~IRON PIPE FOUND
O~IRON PIPE SET
+~CHISEL CROSS CUT IN CONC.

PLAT OF SURVEY OF

LOT 20 BLOCK 4, WILSON ADDITION
TO THE CITY OF WHITEWATER,
WALKWORTH COUNTY, WISCONSIN.

Floyd Jensen
SURVEYOR

SCALE 1" = 20'

DATE NOV. 1971