

Any of Harb. AL 1/16/66 at 22
 Block 1 M and located in 1011
 Certified Survey of page 13

REGISTERED OF LAND

Survey of Harb.
 10-137

CERTIFIED SURVEY #18

HAROLD H. KOIB
 REGISTERED PROFESSIONAL LAND SURVEYOR
 LAKE GENEVA, WISCONSIN

PLAT OF SURVEY OF

A parcel of land located in Block 5 of Birches Addition to the City of White-water, Walworth County, Wisconsin and described as follows: to-wit: Commencing at the South 1/4 corner of Section 5, T 4 N, R 15 E, Walworth County, Wisconsin; thence N 3° 24' W 1219.64 feet; thence N 85° 45' E 246.41 feet to the place of beginning; thence N 3° 46' W 519.44 feet; thence N 85° 03' E 114.72 feet; thence S 3° 46' E 166.70 feet; thence along the arc of a curve to the right, the radius of which is 51.2 feet, the angle of which is S 18° 41' E 44.52 feet; thence S 3° 46' E 166.70 feet; thence S 85° 45' W 166.70 feet to the place of beginning.


OWNER: Floyd and Dorothy Froemming

State of Wisconsin,
 County of Walworth

I, Harold H. Koib, do hereby certify that I have surveyed the property hereon described according to the official records, and that the plat hereon is a correct representation of all lot lines, and fully complies to Chapter 236.34 of the Wisconsin Statutes of 1961.

Harold H. Koib

Harold H. Koib, Wisconsin Surveyor, 3-190
 DATE: December 16, 1965

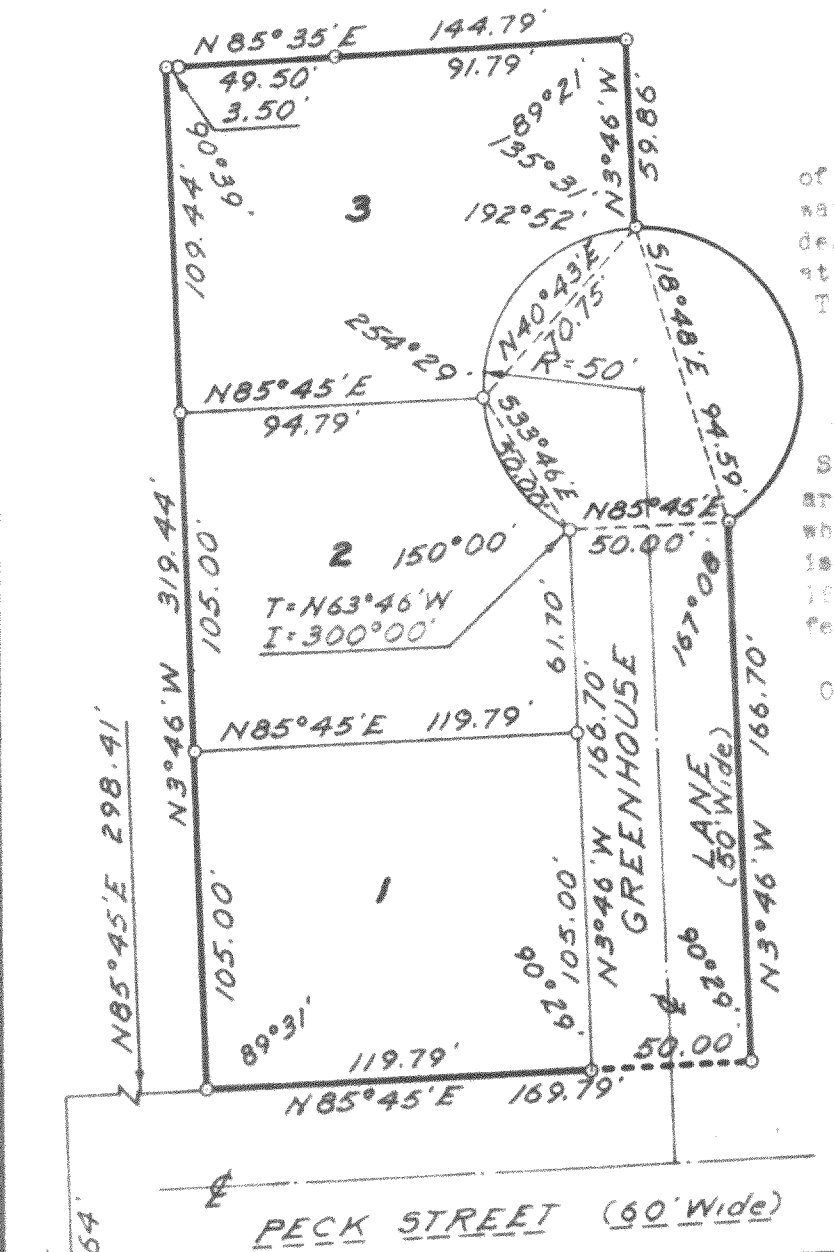

South 1/4 Corner of
 Section 5, T 4 N, R 15 E
 N 3° 24' W 1219.64'

N
 SCALE 1"=60'

o - Iron pipe, 1" dia. x 24"
 Min. wt. 1.13#/lin. ft.

Cert. Sur. #18

10-137