


REGISTERED PROFESSIONAL LAND SURVEYOR
LAKE GENEVA, WISCONSIN



A parcel of land located in the Northwest 1/4 of Section 4, T 4 N, R 15 E, City of Whitewater, Walworth County, Wisconsin, as found to be monumented, and described:

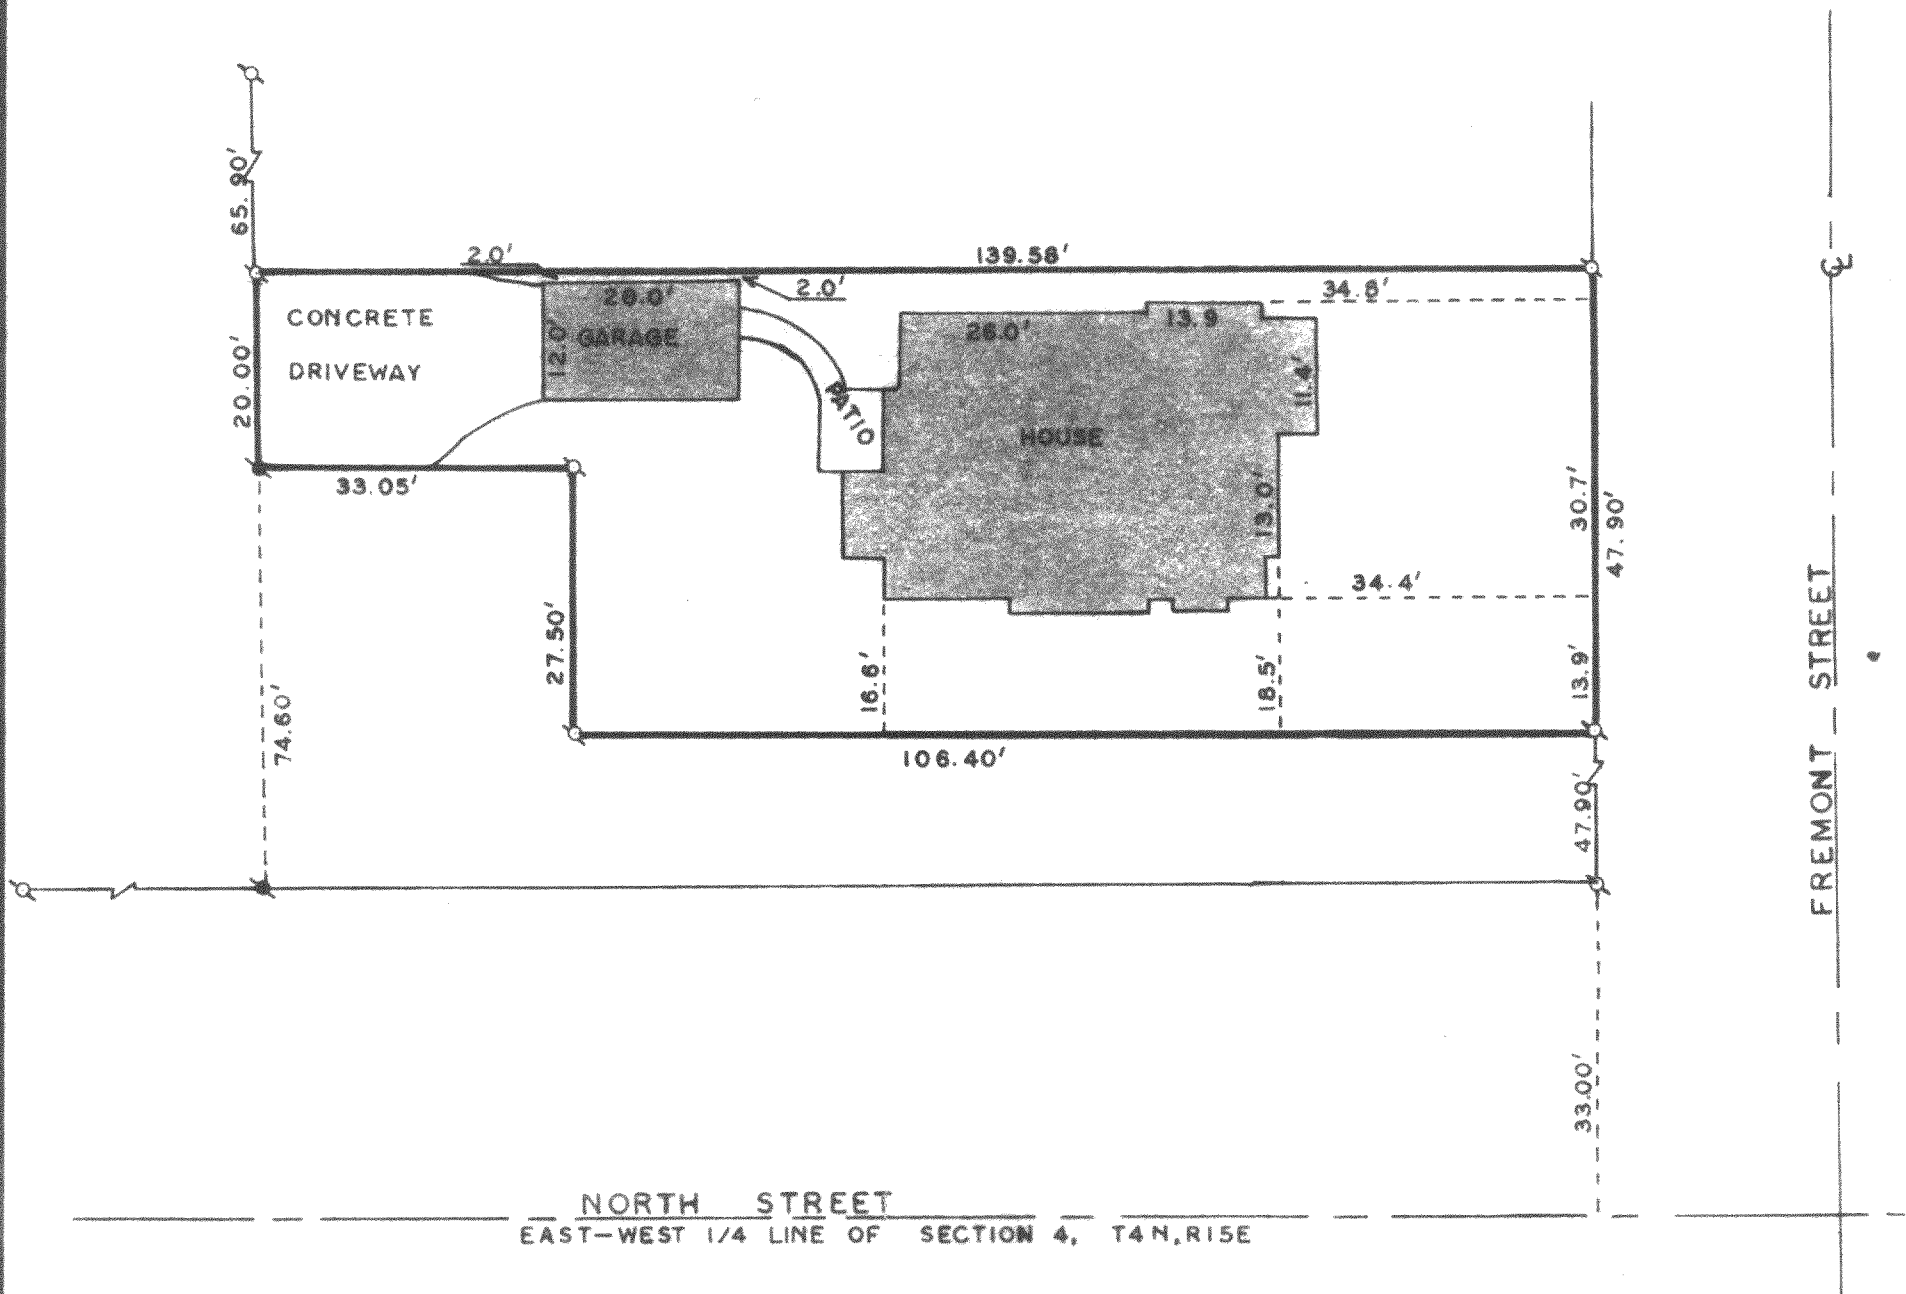

- Ø - IRON PIPE FOUND
 O - IRON PIPE PLACED
 ● - CONCRETE MONUMENT
 X - SPIKE
 ⚓ - FOUND IRON ROD

SCALE: 1" = 20'

I, HAROLD H. KOLB, DO HEREBY CERTIFY THAT I HAVE SURVEYED THE PROPERTY HEREON DESCRIBED ACCORDING TO THE OFFICIAL RECORDS, AND THAT THE PLAT HEREON IS A CORRECT REPRESENTATION OF THE LOT LINES, and the principle lines of the buildings thereon.

Harold H. Kolk

HAROLD H. KOLB

WISCONSIN REGISTERED LAND SURVEYOR, S-187

DATE July 30, 1965