


HAROLD H. KOLB

REGISTERED PROFESSIONAL LAND SURVEYOR

LAKE GENEVA, WISCONSIN

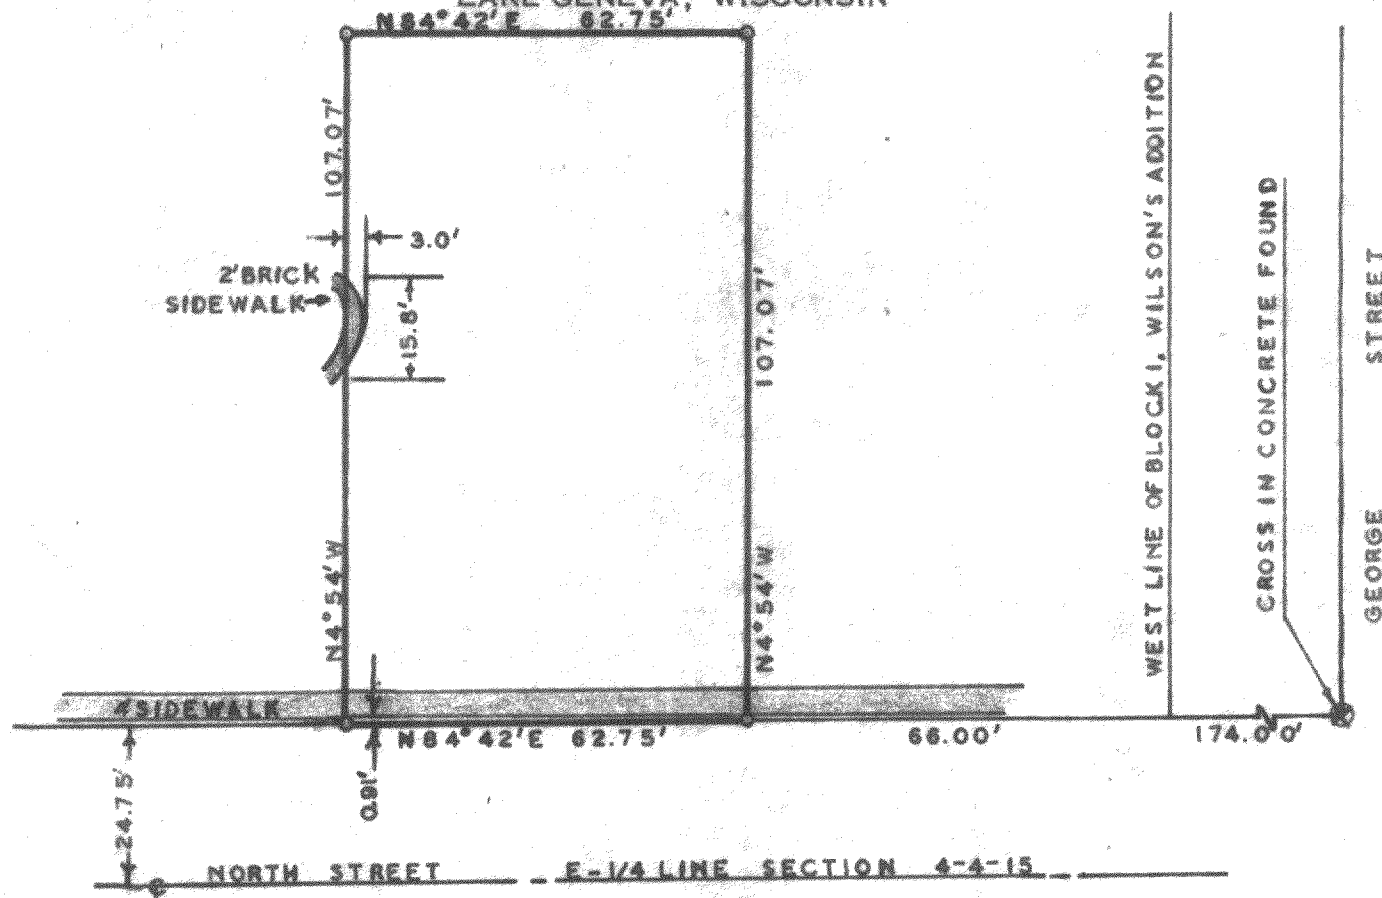

SCALE: 1"=30'

LEGEND

- ⊔ - IRON PIPE FOUND
- - IRON PIPE PLACED
- - CONCRETE MONUMENT
- x - SPIKE

PLAT OF SURVEY OF
A parcel of land located in the Northwest 1/4 of
Section 4; T 4 N, R 15 E, City of Whitewater, Walworth
County, Wisconsin and described as follows; to wit:
Commencing at the Southwest corner of Block 1, Wilson's
Addition; thence S 84° 42' W 66.00 feet to the place of
beginning; thence continue S 84° 42' W 62.75 feet;
thence N 4° 54' W 107.07 feet; thence N 84° 42' E 62.75
feet; thence S 4° 54' E 107.07 feet to the place of
beginning.

I, HAROLD H. KOLB, DO HEREBY CERTIFY THAT I HAVE
SURVEYED THE PROPERTY HEREON DESCRIBED ACCORDING
TO THE OFFICIAL RECORDS, AND THAT THE PLAT HEREON
IS A CORRECT REPRESENTATION OF THE LOT LINES.

Harold H. Kolb
HAROLD H. KOLB

WISCONSIN REGISTERED LAND SURVEYOR, S-187
DATE December 19, 1966

10-145

UP-67