


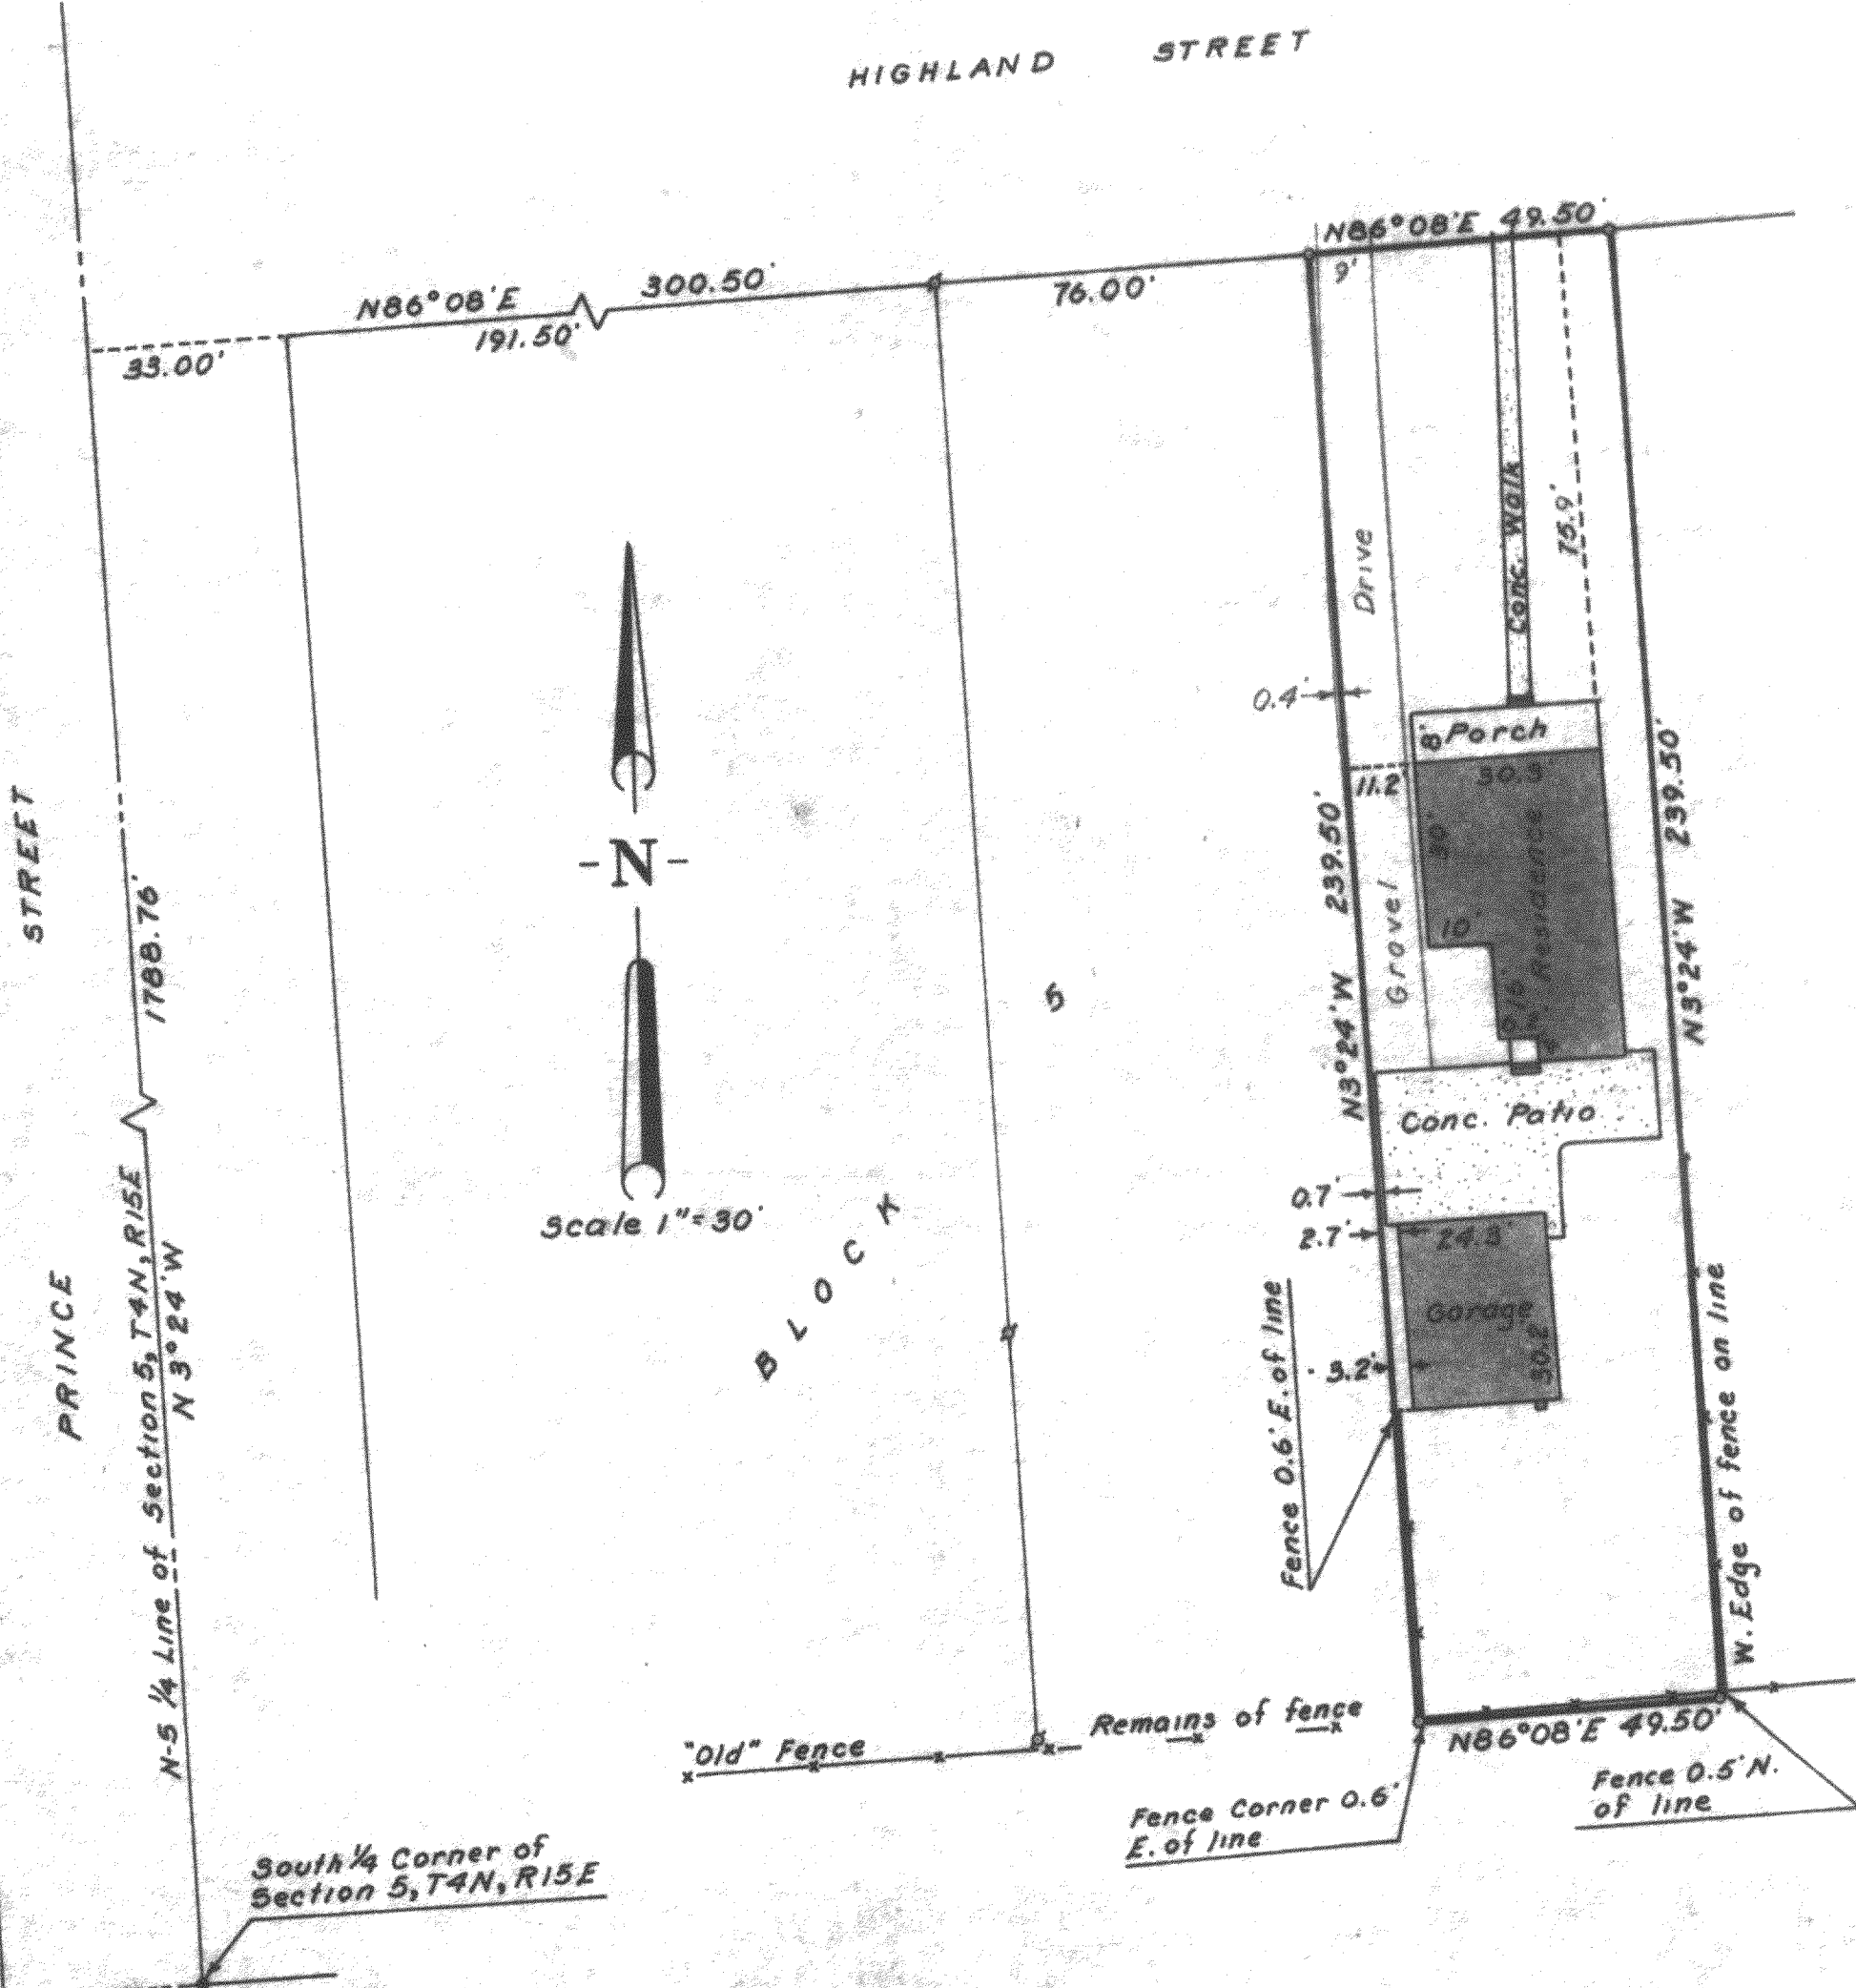

PLAT OF SURVEY OF

A parcel of land located in Block 5, Birge's Addition to the City of Whitewater, Walworth County, Wisconsin and as described in Vol. 439, page 459 of Deeds, Walworth County Register of Deeds Office, and more particularly described as follows; to-wit: Commencing at the South 1/4 corner of Section 5, T 4 N, R 15 E; thence N 3°24' W 1788.76 feet; thence N 86°08' E 300.50 feet to the place of beginning; thence continue N 86°08' E 49.50 feet; thence S 3°24' E 239.50 feet; thence S 86°08' W 49.50 feet; thence N 3°24' W 239.50 feet to the place of beginning.

State of Wisconsin) ss  
County of Walworth)

I, Harold H. Kolb, do hereby certify that I have surveyed the property hereon described according to the official records, and that the plat hereon is a correct representation of the lot line and the principal lines of the buildings and other improvements thereon.

Date July 9, 1963



Harold H. Kolb

Harold H. Kolb, Wisconsin Registered Surveyor, S-187

BIR - 79 80

• - Conc. Monument  
• - Iron Pipe Found  
• - Iron Pipe Placed

10-155